

# **OPERATION & MAINTENANCE MANUAL**

**DFI No. : D00134**

**Facility Type: Detention Pond/Water  
Quality Biofiltration Swale Combo**



**JUNE, 2011**

**INDEX**

**1. IDENTIFICATION..... 1**

**2. FACILITY CONTACT INFORMATION..... 1**

**3. CONSTRUCTION..... 1**

**4. STORM DRAIN SYSTEM AND FACILITY OVERVIEW ..... 2**

**5. FACILITY HAZ MAT SPILL FEATURE(S)..... 4**

**6. AUXILIARY OUTLET (HIGH FLOW BYPASS)..... 5**

**7. MAINTENANCE REQUIREMENTS..... 6**

**8. WASTE MATERIAL HANDLING..... 6**

**APPENDIX A: Operational Plan and Profile Drawing(s)**

**APPENDIX B: ODOT Project Plan Sheets**

## 1. Identification

Drainage Facility ID (DFI): **D00134**

Facility Type: Detention Pond/Water Quality Biofiltration Swale Combo

Construction Drawings: (V-File Number) 39V-058

Location: District: 2B (Old 2A)  
Highway No.: 064  
Mile Post: 2.41 – 2.51; (beg. / end)  
Description: This facility is located in the median of I-205 between Stafford Road and Prosperity Park Road. Access is obtained from the inside shoulders of either the northbound or southbound lanes.

## 2. Facility Contact Information

Contact the Engineer of Record, Region Technical Center, or Geo-Environmental's Senior Hydraulics Engineer for:

- Operational clarification
- Maintenance clarification
- Repair or restoration assistance

### Engineering Contacts:

Region Technical Center Hydro Unit Manager

Or

Geo-Environmental Senior Hydraulics Engineer (503) 986-3365.

## 3. Construction

Engineer of Record: Consultant Designer - OBEC, Jerome D. Lane, P.E., 503-589-4100

Facility construction: 2006  
Contractor: Mainline Paving, LLC

#### 4. Storm Drain System and Facility Overview

A detention pond/water quality biofiltration swale combo (referred to from this point forward as a pond/swale combo) combines the forms and functions of a water quality swale and a detention pond. In a pond/swale combo, the biofiltration swale is situated within the bottom confines of the detention facility. The facility provides water quality treatment of the smaller storm events and detention of the larger storm events.

The biofiltration swale is designed as if it was a separate facility and consists of a grassy-lined facility with a flat trapezoidal cross section and gradual slope. Treatment is provided through sedimentation and filtration processes. If amended soils are present, additional treatment is obtained through infiltration through the amended soil media.

When the flows exceed the water quality flows, the pond/swale combo facility begins to provide detention. Detention is required to reduce or mitigate the increases in discharge, resulting from development. The facility is designed to store and gradually release (or attenuate) stormwater runoff via a control structure or release mechanism, then releasing it slowly over a more extended period of time. The flow control mechanism for this facility involves a 4-inch orifice surrounded by a wirecloth strainer assembly. When flows exceed the water quality design flow, the orifice restricts the flow causing the water to backup within the facility.

This particular detention pond/water quality biofiltration swale combo facility (Photos 2 & 3) is approximately 500-feet long and is located in the median of I-205 (Hwy 64). Access is obtained from the inside shoulders of either the northbound or southbound lanes.

The system is feed stormwater as sheet flow from the northbound and southbound lanes of I-205 (Hwy 64). Water travels through the swale from both the east and west sides and exits through the swale outlet structure (Point A, Operational Plan, Appendix A, Photo 4). The water travels through an 18-inch pipe northward into the near stormwater system.

A. Maintenance equipment access:

Access is obtained from the inside shoulders of the north and southbound lanes of I-205 (Hwy 64); see Photo 1.

B. Heavy equipment access into facility:

- Allowed (no limitations)
- Allowed (with limitations)
- Not allowed

C. Special Features:

- Amended Soils
- Porous Pavers
- Liners
- Underdrains



Photo 1: Maintenance access looking west

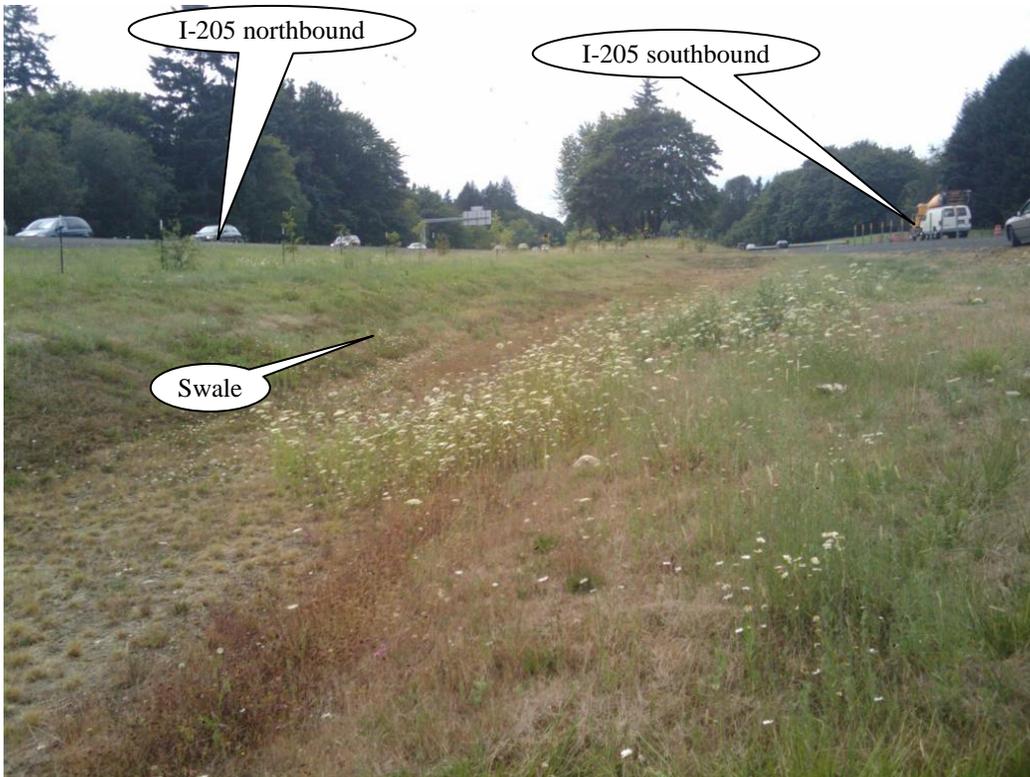


Photo 2: East end of swale looking west



Photo 3: Swale looking west

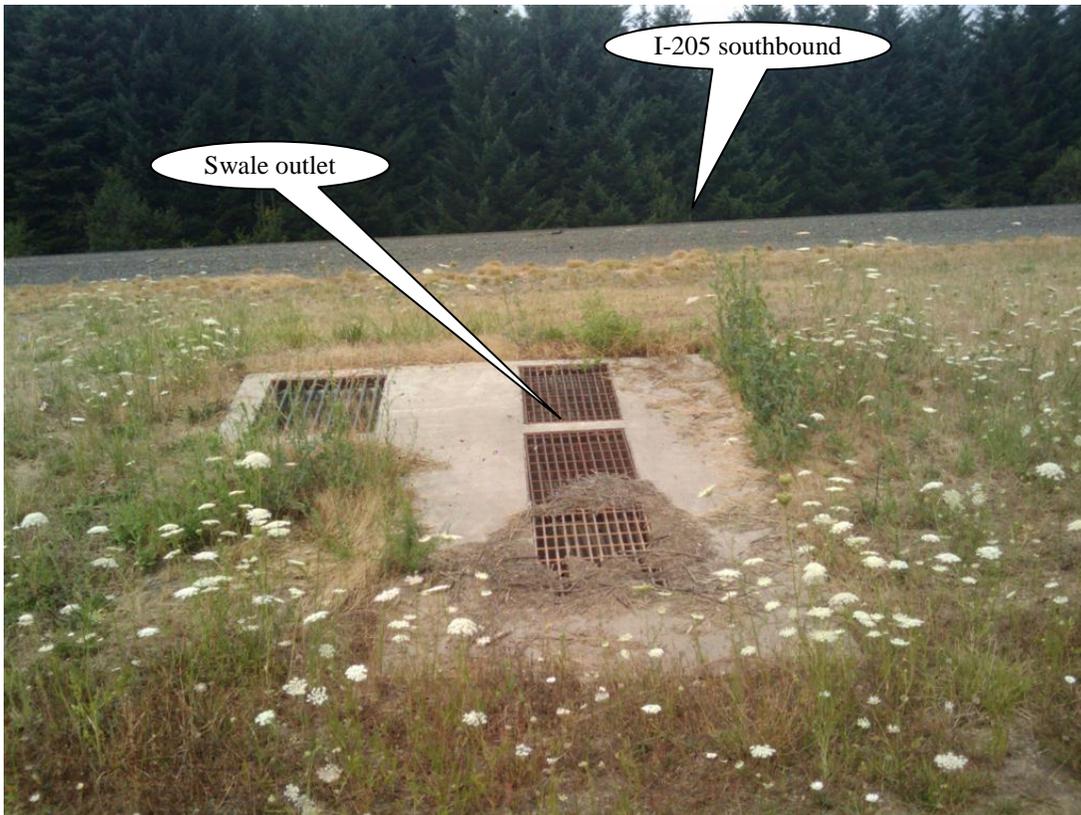


Photo 4: Outlet structure looking north

## 5. Facility Haz Mat Spill Feature(s)

The detention pond/water quality biofiltration swale combo can be used to store a volume of liquid by blocking the 18-diameter outlet pipe located at the outlet structure (Point A, Photo 4).

## 6. Auxiliary Outlet (High Flow Bypass)

Auxiliary Outlets are provided if the primary outlet control structure can not safely pass the projected high flows. Broad-crested spillway weirs and over flow risers are the two most common auxiliary outlets used in stormwater treatment facility design. The auxiliary outlet feature is either a part of the facility or an additional storm drain feature/structure.

The auxiliary outlet feature for this facility is:

Designed into facility

The auxiliary outlet is located in the outlet structure (Point A, Photo 4). In the case of high flows water will spill over the first two outlets and exit out of the top two inlets (located side by side). The two top inlets are connected to each other by an 18-inch pipe. Water then flows out of the

system through an 18-inch storm pipe toward a nearby stormwater system.

Other, as noted below

## 7. Maintenance Requirements

Routine maintenance table for non-proprietary stormwater treatment and storage/detention facilities have been incorporated into ODOT's Maintenance Guide. These tables summarize the maintenance requirements for ponds, swales, filter strips, bioslopes, and detention tanks and vaults. Special maintenance requirements in addition to the routine requirements are noted below when applicable.

The ODOT Maintenance Guide can be viewed at the following website:

<http://www.oregon.gov/ODOT/HWY/OOM/MGuide.shtml>

Maintenance requirements for proprietary structures, such as underground water quality manholes and/or vaults with filter media are noted in Appendix C when applicable.

The following stormwater facility maintenance table (See ODOT Maintenance Guide) should be used to maintain the facility outlined in this Operation and Maintenance Manual or follow the Maintenance requirements outlined in Appendix C when proprietary structure is selected below:

- Table 1 (general maintenance)
- Table 2 (stormwater ponds)
- Table 3 (water quality biofiltration swales)
- Table 4 (water quality filter strips)
- Table 5 (water quality bioslopes)
- Table 6 (detention tank)
- Table 7 (detention vault)
- Appendix C (proprietary structure)
- Special Maintenance requirements:

Note: Special maintenance Requirements Require Concurrence from ODOT SR Hydraulics Engineer.

## 8. Waste Material Handling

Material removed from the facility is defined as waste by DEQ. Refer to the roadwaste section of the ODOT Maintenance Yard Environmental Management System (EMS) Policy and Procedures Manual for disposal options: <http://egov.oregon.gov/ODOT/HWY/OOM/EMS.shtml>




Contact any of the following for more detailed information about management of waste materials found on site:

ODOT Clean Water Unit	(503) 986-3008
ODOT Statewide Hazmat Coordinator	(503) 229-5129
ODOT Region Hazmat Coordinator	(503) 731-8304
ODEQ Northwest Region Office	(503) 229-5263

# Appendix A

## Content:

- **Operational Plan and Profile Drawing(s)**

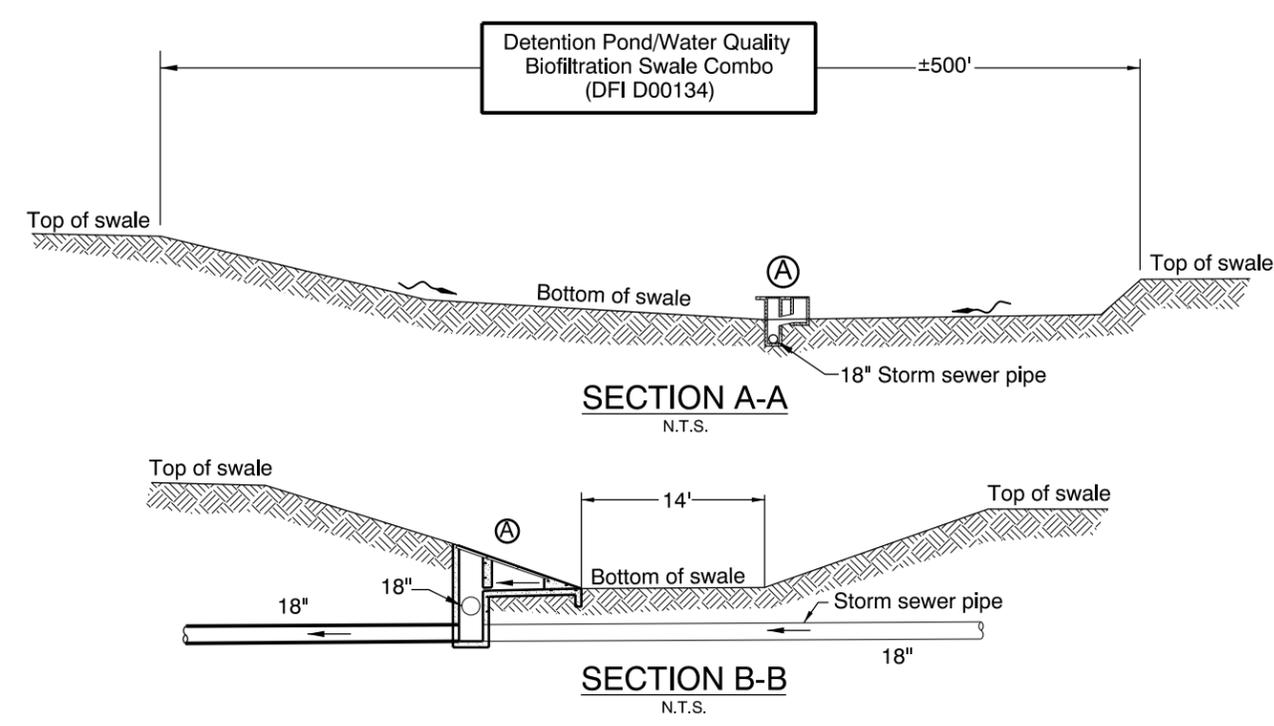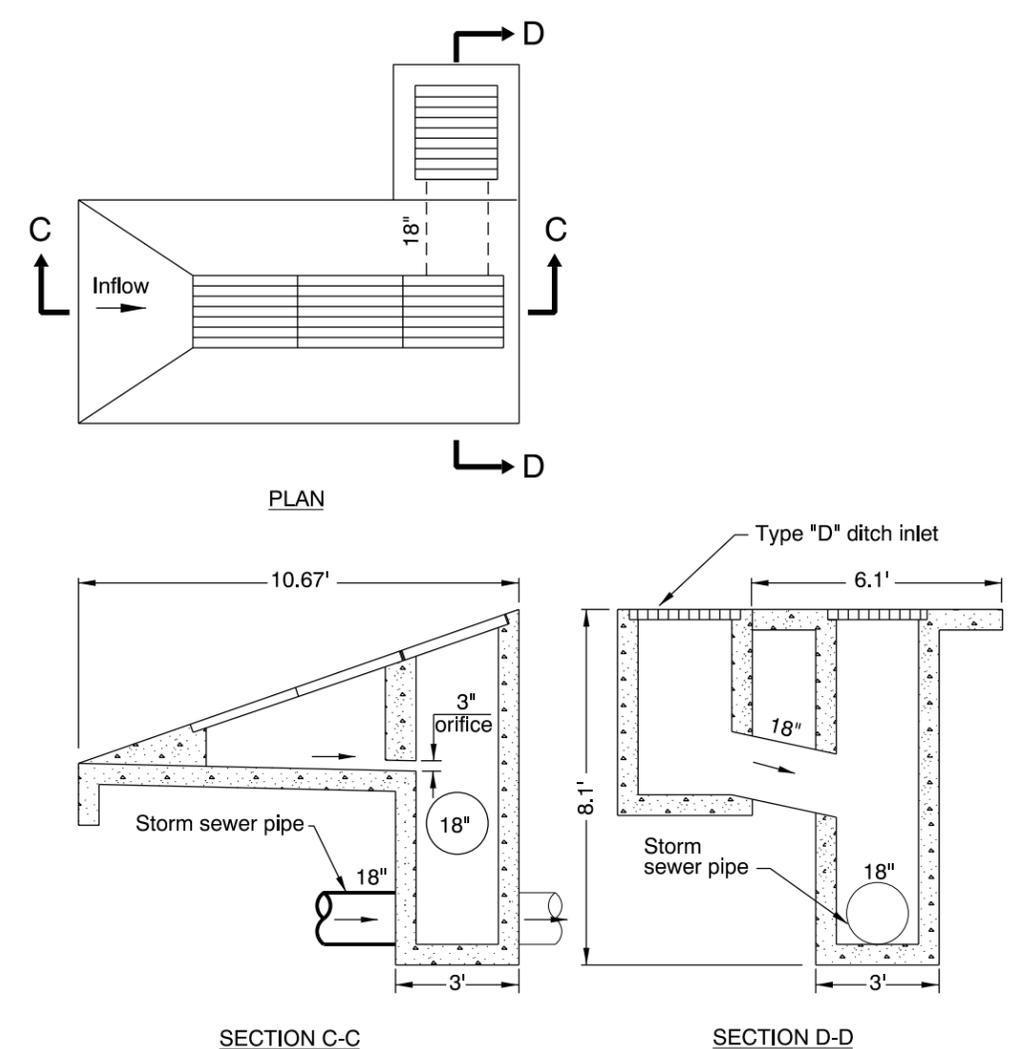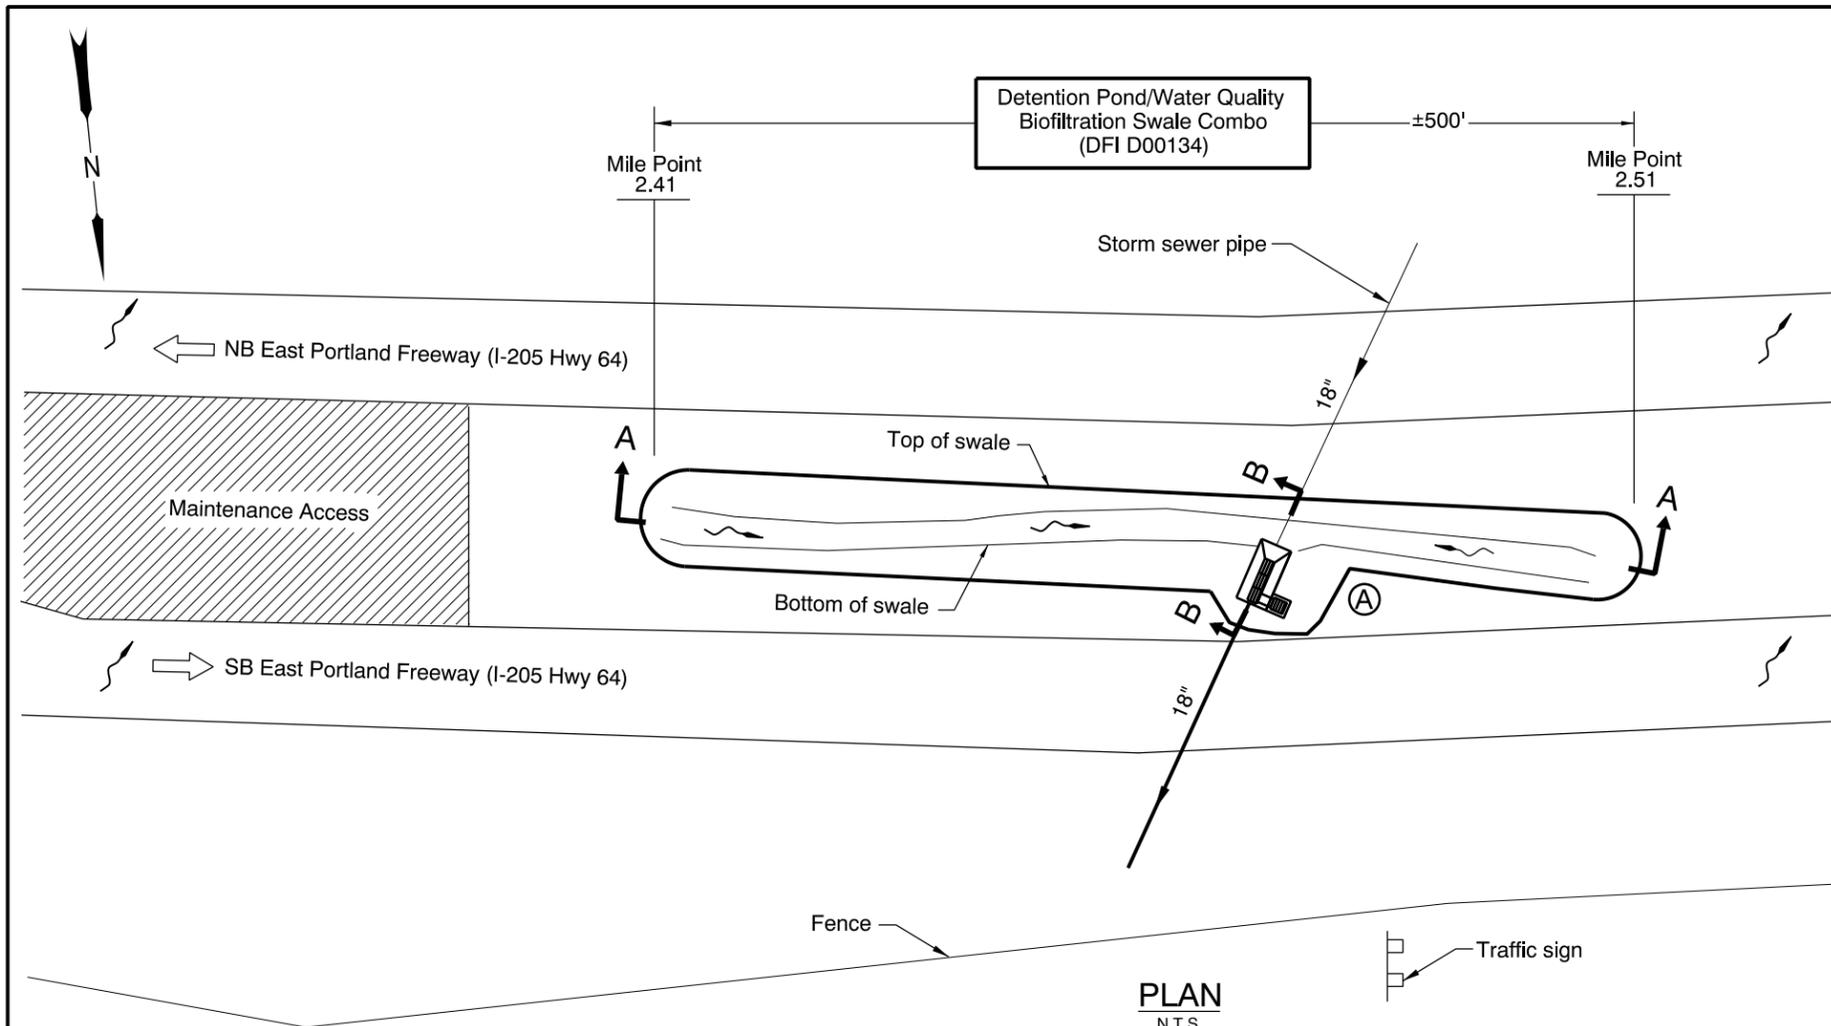

- LEGEND:
- Photo Location / Direction
  - Swale Outlet Structure
  - Traffic Flow / Direction
  - Storm Pipe (Facility)
  - Storm Pipe
  - Conveyance Direction
  - Pavement / Facility Flow Path
  - Maintenance Access

Sht. 1 of 1

OREGON DEPARTMENT OF TRANSPORTATION

DFI D00134  
**MAINTENANCE DISTRICT 2B HWY 64  
 DETENTION POND/WQ SWALE COMBO**  
 EAST PORTLAND FREEWAY MP 2.41-2.51  
 CLACKAMAS COUNTY

Prepared By: Craig Fox

Drafted By: Rodney Schultz

# Appendix B


## Content:

- **ODOT Project Plan Sheets**
  - *Cover/Title Sheet*
  - *Water Quality/Detention Plan Sheets*
  - *Other Details*

INDEX OF SHEETS	
SHEET NO.	DESCRIPTION
1	Title Sheet
1A, 1B	Index Of Sheets Cont'd.
1C	Std. Drg. Nos.

STATE OF OREGON  
 DEPARTMENT OF TRANSPORTATION  
 PLANS FOR PROPOSED PROJECT  
**GRADING, DRAINAGE, STRUCTURES, PAVING, SIGNING & ILLUMINATION**

**I-205: WILLAMETTE RIVER BR. -  
 PACIFIC HWY. (UNIT 3) SEC.  
 EAST PORTLAND FREEWAY  
 CLACKAMAS & WASHINGTON COUNTIES  
 APRIL 2006**

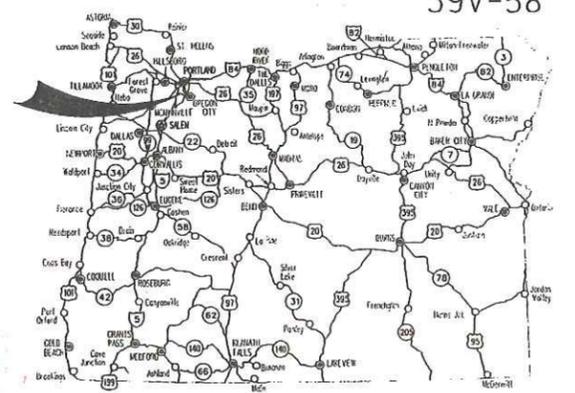


Overall Length Of Project - 8.90 Miles

**"AS CONSTRUCTED"**  
*Matthew Nelson*  
 Date 6/26/09 Project Mgr

**ATTENTION:**  
 Oregon Law Requires You To Follow Rules Adopted By The Oregon Utility Notification Center. Those Rules Are Set Forth In OAR 952-001-0010 Through OAR 952-001-0090. You May Obtain Copies Of The Rules By Calling The Center. (Note: The Telephone Number For The Oregon Utility Center Is (503) 232-1987.)

LET'S ALL  
 WORK TOGETHER  
 TO MAKE THIS  
 JOB SAFE

**END OF PROJECT IM-OTIA-S064(032)  
 STA. "LS2" 1231+71.15 (M.P. -0.10)**

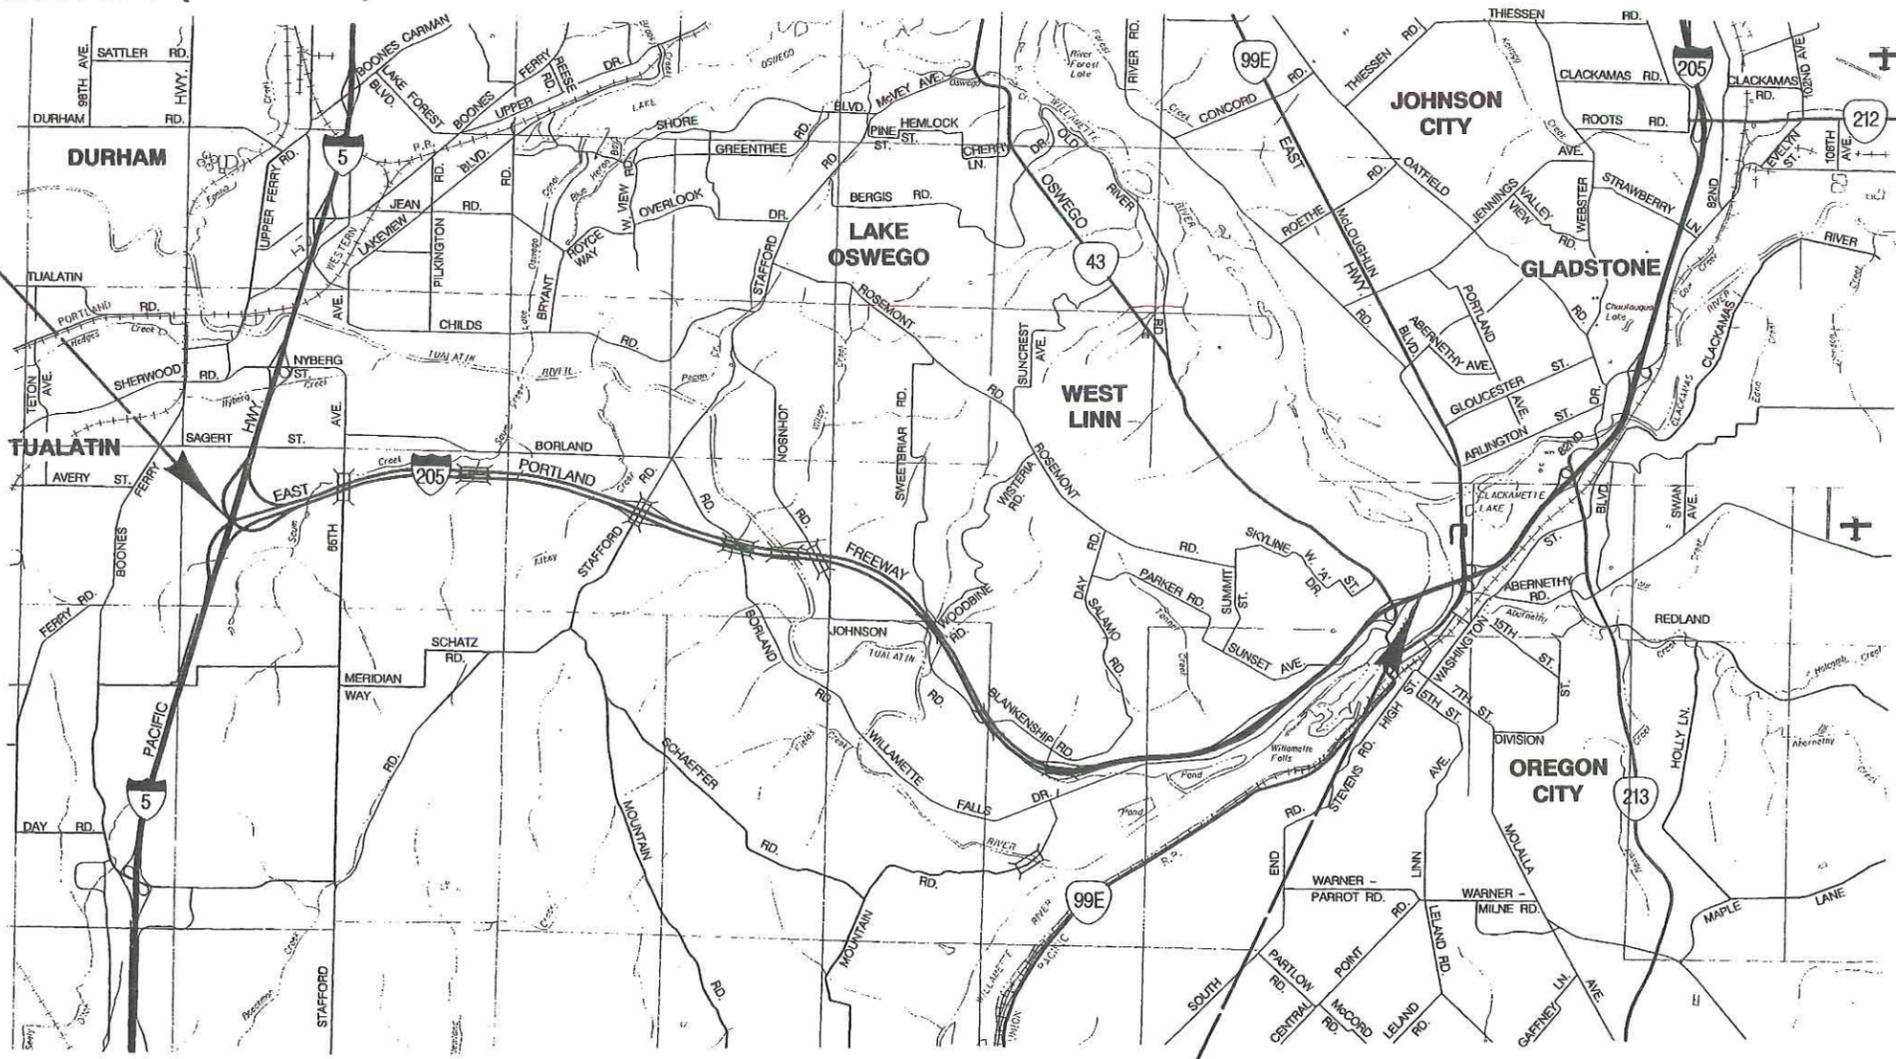

- OREGON TRANSPORTATION COMMISSION**
- |                   |                            |
|-------------------|----------------------------|
| Stuart Foster     | CHAIRMAN                   |
| Gail L. Achterman | COMMISSIONER               |
| Mike Nelson       | COMMISSIONER               |
| Randall Papé      | COMMISSIONER               |
| Janice J. Wilson  | COMMISSIONER               |
| Matthew Garrett   | DIRECTOR OF TRANSPORTATION |



EXPIRES: 12/31/07

LAWRENCE H. FOX  
 OBEC CONSULTING ENGINEERS - PROJECT MANAGER


OREGON DEPARTMENT OF TRANSPORTATION  
 CONCURRENCE  
*Harold E. Suley* 2/23/06  
 TECHNICAL SERVICES MANAGING ENGINEER DATE

**I-205: WILLAMETTE RIVER BR. -  
 PACIFIC HWY. (UNIT 3) SEC.  
 EAST PORTLAND FREEWAY  
 CLACKAMAS & WASHINGTON COUNTIES**

FEDERAL HIGHWAY ADMINISTRATION	PROJECT NUMBER	SHEET NO.
OREGON DIVISION	IM-OTIA-S064(032)	1

**BEGINNING OF PROJECT IM-OTIA-S064(032)  
 STA. "L" 735+41.85 (M.P. 8.80)**

T. 2 S., R. 1 W.,  
 R. 1 E. & R. 2 E., W.M.

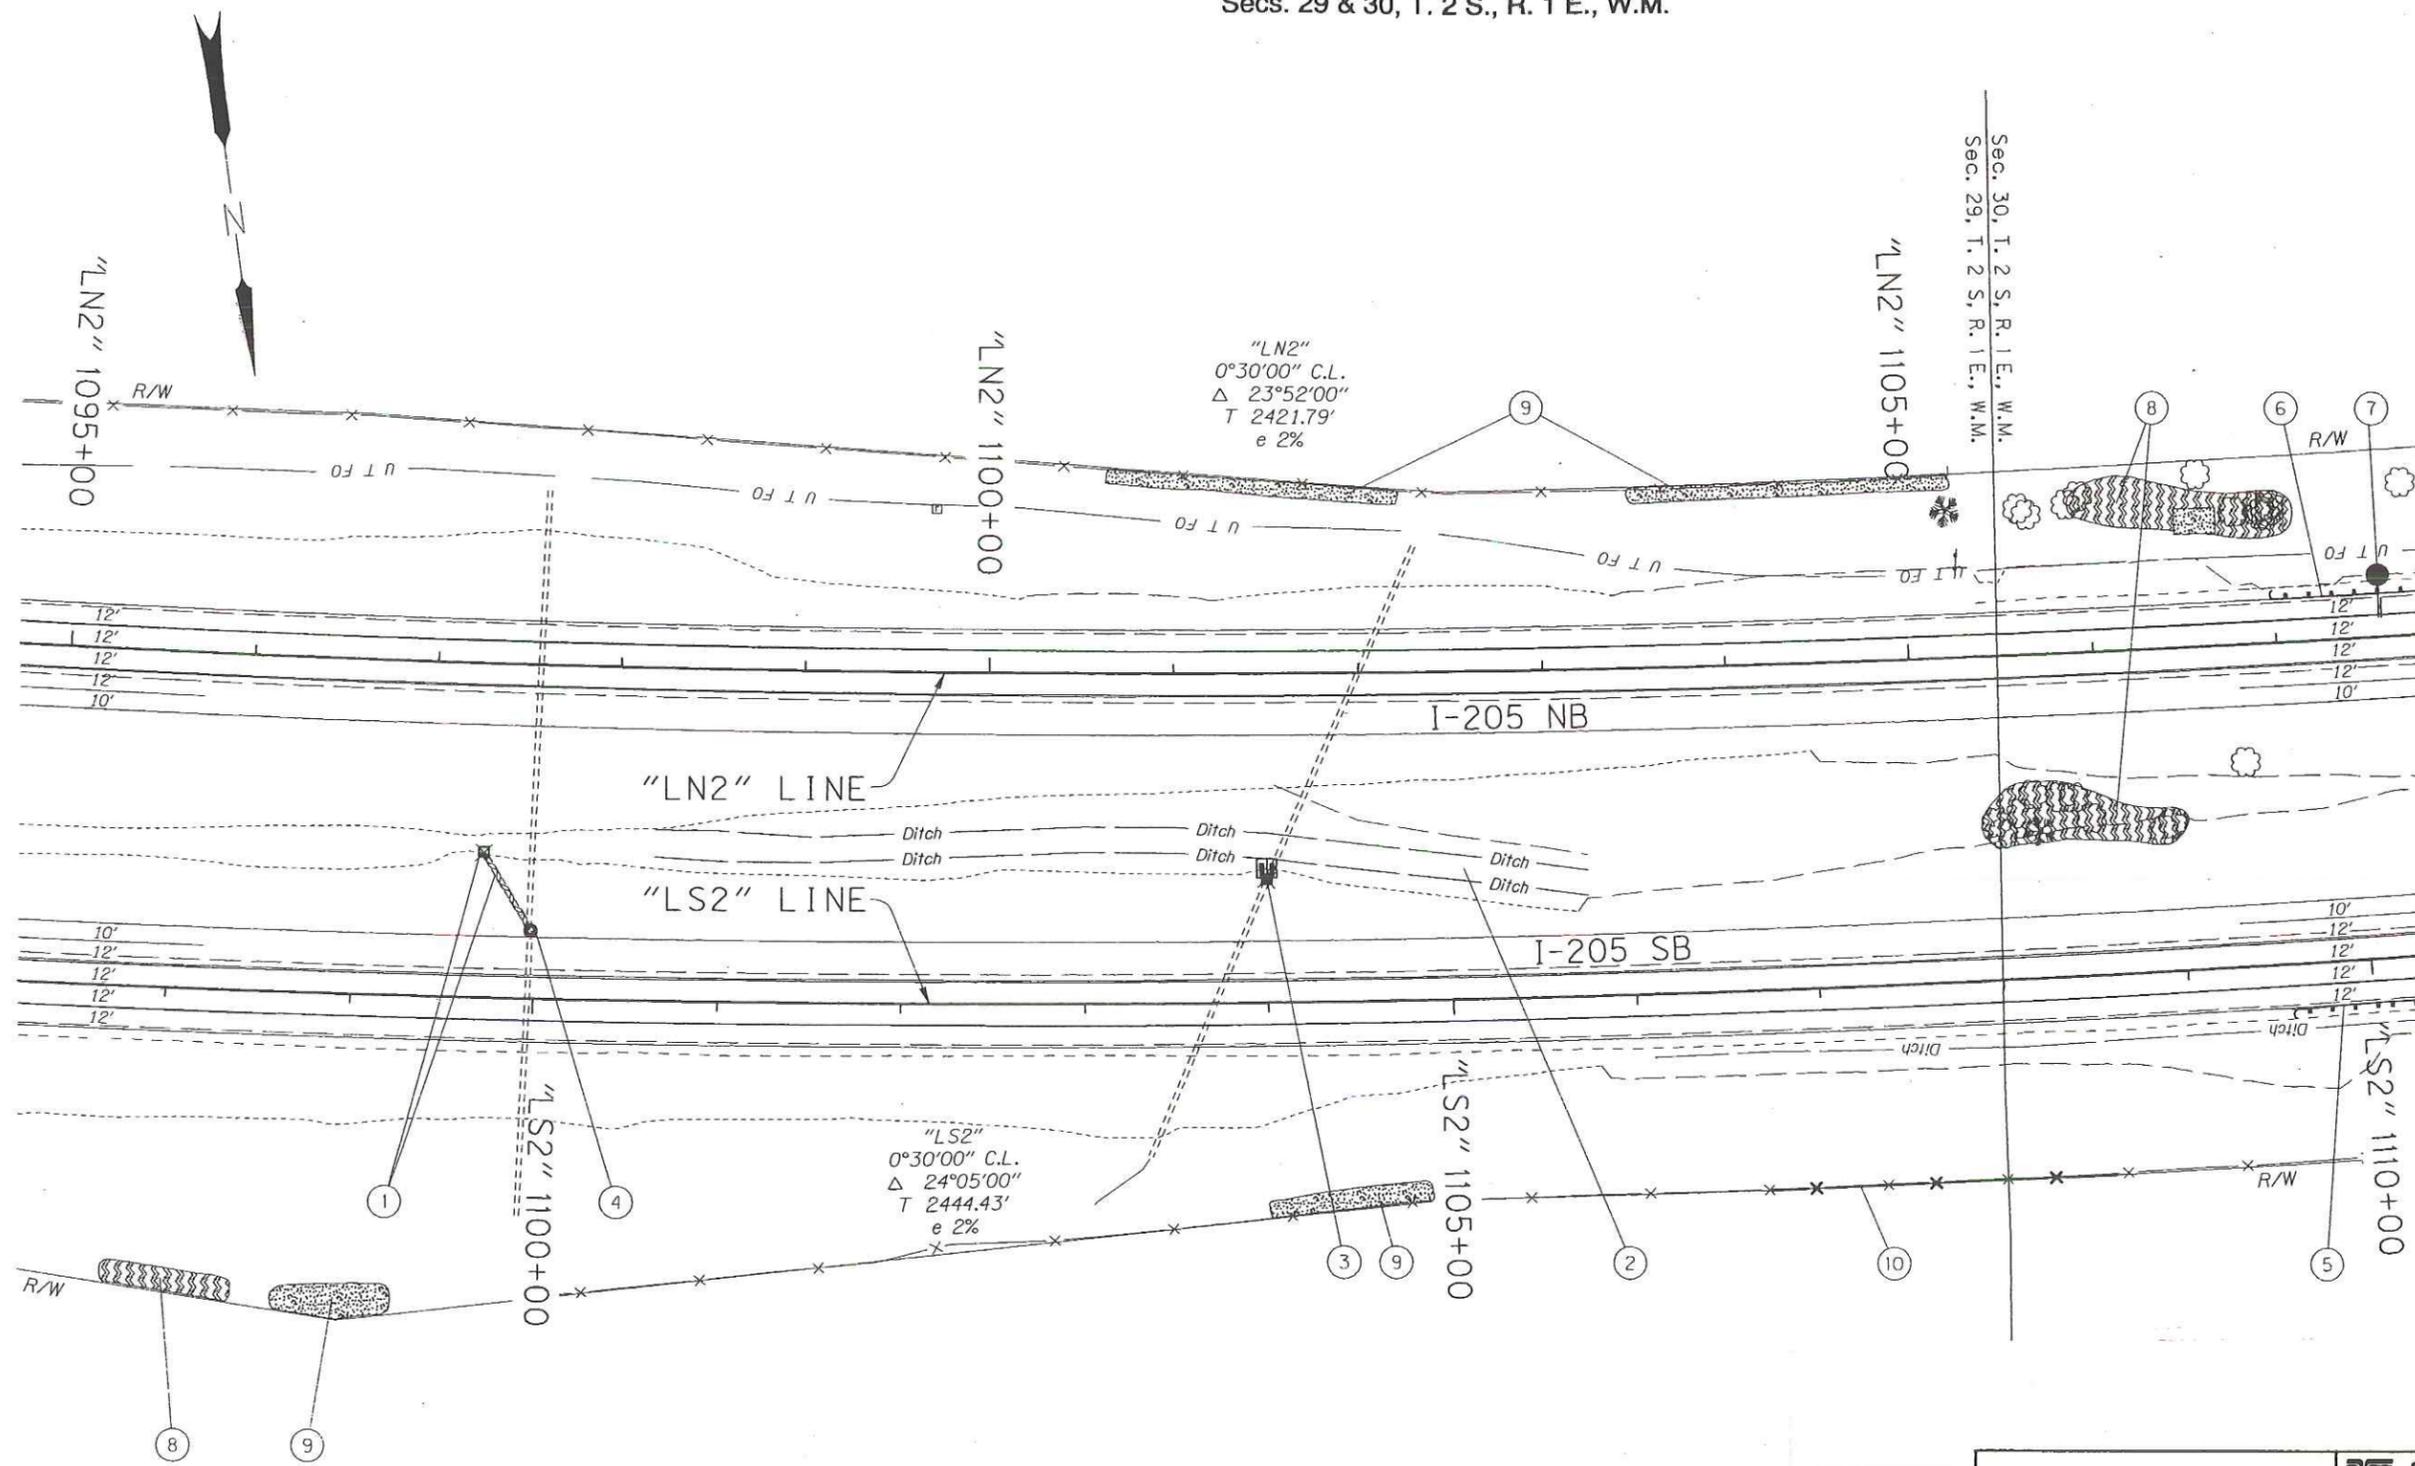

- ① Sta. "LS2" 1099+68.2, 84.9' Lt.  
Remove Inlet  
Remove Sew. Pipe - 48'
- ② Const. Bio-Swale/Detention Pond 2  
Ditch Exc. - 1135 Cu.Yd.  
⚠ (For Details, See Sht. GJ-3)
- ③ Sta. "LS2" 1104+03.8, 76.3' Lt.  
Remove Inlet  
Const. Outlet Structure  
Over Sew. Pipe  
(See Drg. No. RD368)  
(For Details, See Sht. GJ-3B)
- ④ Sta. "LS2" 1099+97.6, 34' Lt.  
Cap Inlet  
(See Drg. No. RD376)
- ⑤ Const. Guardrail - 775' (Type 2A)  
Const. Guardrail Terminal, Non-Flared (50')  
Flare Rate=0, W=1', E=0
- ⑥ Const. Guardrail - 900' (Type 2A)  
Const. Anchor (Type 1 Mod.)  
Inst. End Piece (Type B)
- ⑦ Sta. "LN2" 1107+50  
Const. Cantilever Sign & Foundation  
(For Drg. Nos., See Sht. 1A)
- ⑧ Type "A" Weed Control
- ⑨ Type "B" Weed Control
- ⑩ Sta. "LS2" 1106+69 To  
Sta. "LS2" 1108+55, Rt.  
Remove Type 2 Fence - 190'  
Const. Type 2 Fence - 190'

REVISIONS	
⚠	Revised 04-10-2006 Revised Note

**"AS CONSTRUCTED"**

*Mark Bevan*  
 Date 6/26/09 Project Mngr

**LEGEND**

Remove Extg. Pipe Shown Thus:	
Type "A" Weed Control Shown Thus:	
Type "B" Weed Control Shown Thus:	

REGISTERED PROFESSIONAL  
 ENGINEER  
 12295  
*Jerome D. Lane*  
 OREGON  
 JULY 5, 1983  
 JEROME D. LANE  
 EXPIRES: 12/31/06

**OREGON DEPARTMENT OF TRANSPORTATION**  
 ROADWAY ENGINEERING SECTION

**I-205: WILLAMETTE RIVER BR. -  
 PACIFIC HWY. (UNIT 3) SEC.**  
 EAST PORTLAND FREEWAY  
 CLACKAMAS & WASHINGTON COUNTIES


Design Team Leader - Jerry Lane  
 Designed By - Tom Metcalf  
 Drafted By - Serban Dinca

**ALIGNMENT AND  
 GENERAL CONSTRUCTION**


SHEET NO. 31

**OBE CONSULTING ENGINEERS**  
 Corporate Office: 920 COUNTRY CLUB ROAD, SUITE 100B EUGENE, OREGON 97401-0289  
 2208 MISSION STREET SE, SUITE 100 SALEM, OREGON 97302-1286  
 1335 POPLAR DRIVE, MEDFORD, OREGON 97504-5207

"LN2" LINE

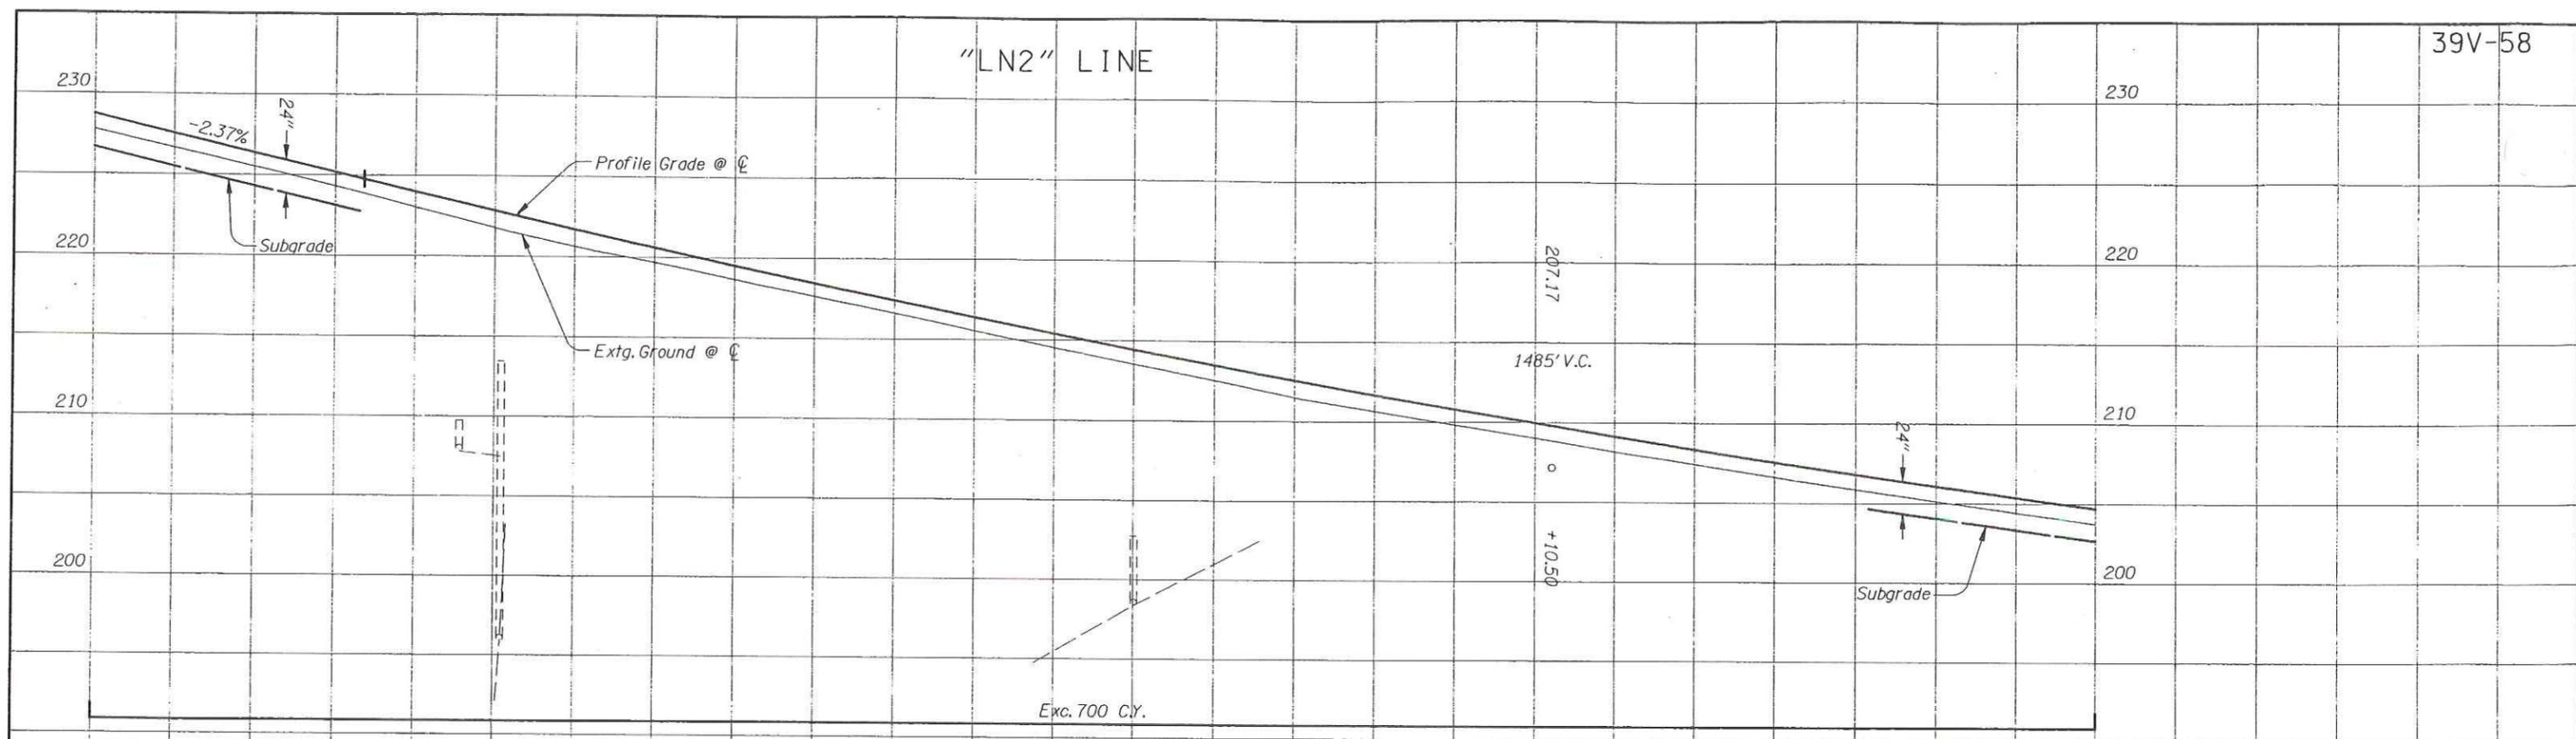


"LS2" LINE

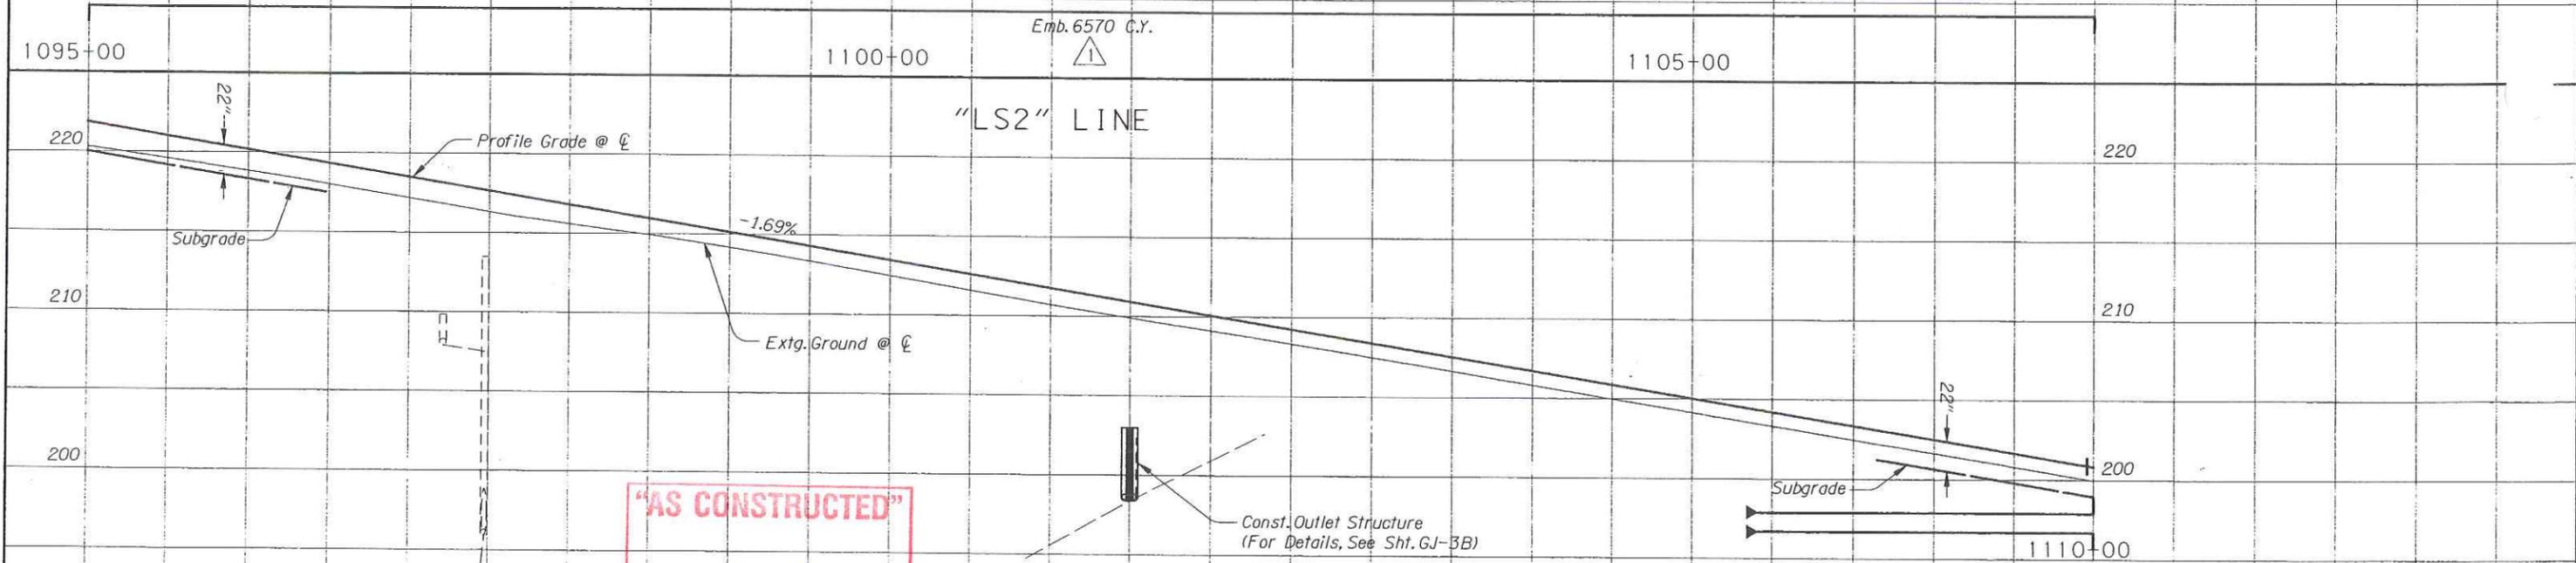

**"AS CONSTRUCTED"**  
*M. H. Beeson*  
 Date 4/24/09 Project Mngr

REVISIONS	
▲	Revised 04-10-2006 Revised Quantity

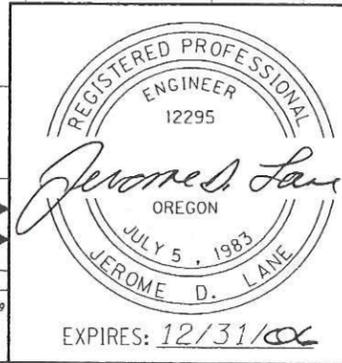



**OREGON DEPARTMENT OF TRANSPORTATION**  
 ROADWAY ENGINEERING SECTION

**I-205: WILLAMETTE RIVER BR. - PACIFIC HWY. (UNIT 3) SEC.**  
 EAST PORTLAND FREEWAY  
 CLACKAMAS & WASHINGTON COUNTIES

Design Team Leader - Jerry Lane  
 Designed By - Tom Metcalf  
 Drafted By - Serban Dinca

**PROFILES**

SHEET NO. 31A

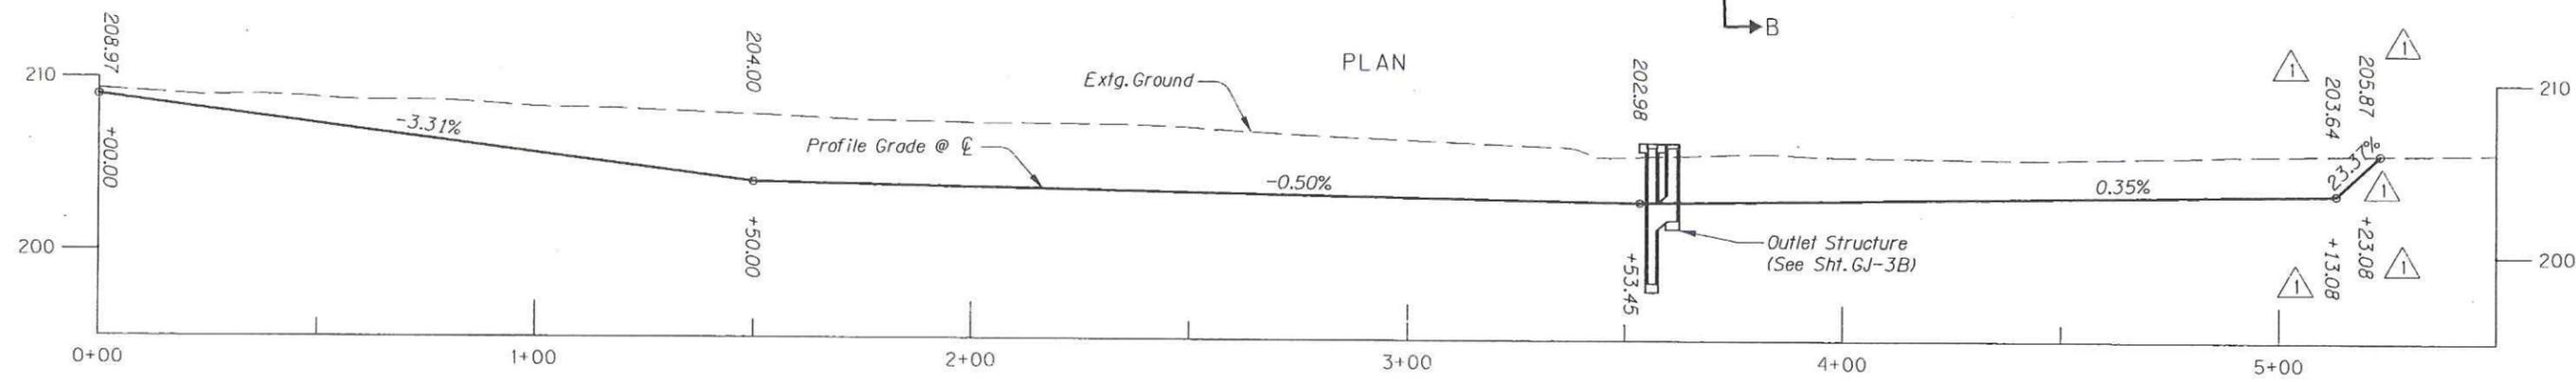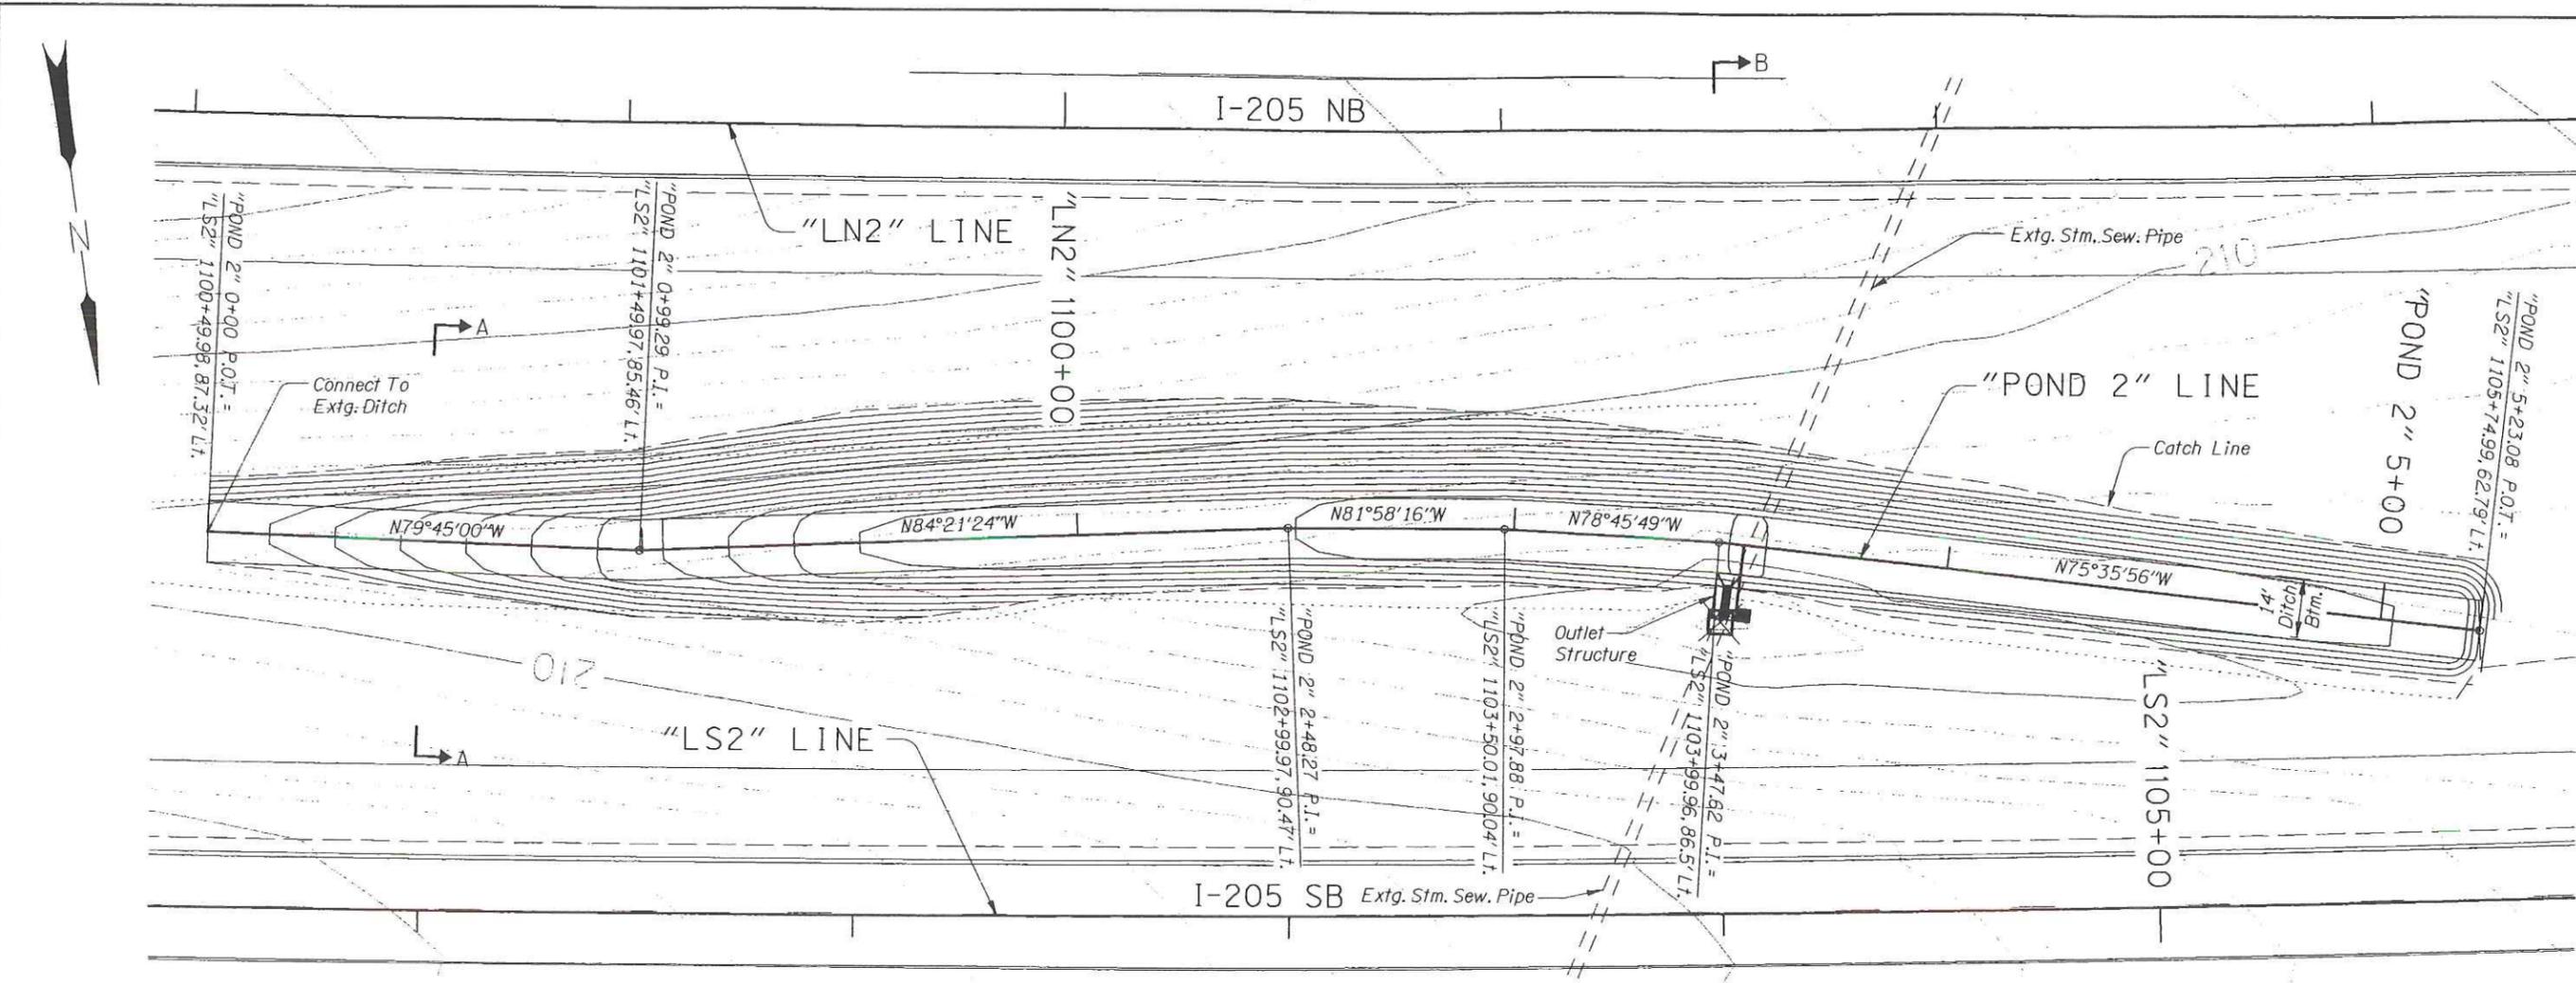

PROFILE  
(See Sht. 31, Notes 2 & 3)

**"AS CONSTRUCTED"**  
*Mark Bern*  
 Date 6/26/09 Project Mngr

NOTE:  
 For Sections Not Shown,  
 See Sht. GJ-3A.  
 For Outlet Structure Details,  
 See Sht. GJ-3B.

REVISIONS	
▲	Revised 04-10-2006
	Revised Profile

REGISTERED PROFESSIONAL  
 ENGINEER  
 12295  
*Jerome D. Lane*  
 OREGON  
 JULY 5, 1983  
 JEROME D. LANE  
 EXPIRES: 12/31/06

**OREGON DEPARTMENT OF TRANSPORTATION  
 ROADWAY ENGINEERING SECTION**



**I-205: WILLAMETTE RIVER BR. -  
 PACIFIC HWY. (UNIT 3) SEC.**  
 EAST PORTLAND FREEWAY  
 CLACKAMAS & WASHINGTON COUNTIES

Design Team Leader - Jerry Lane  
 Designed By - James Kent  
 Drafted By - Mathew Bunde

**POND 2  
 PLAN AND PROFILE**

SHEET NO.  
**GJ-3**

**OBEC CONSULTING ENGINEERS**  
 Corporate Office: 820 COUNTRY CLUB ROAD, SUITE 1008 EUGENE, OREGON 97401-8009  
 2235 MISSION STREET SE, SUITE 100 SALEM, OREGON 97302-1285  
 1335 POPLAR DRIVE MEDFORD, OREGON 97504-5207

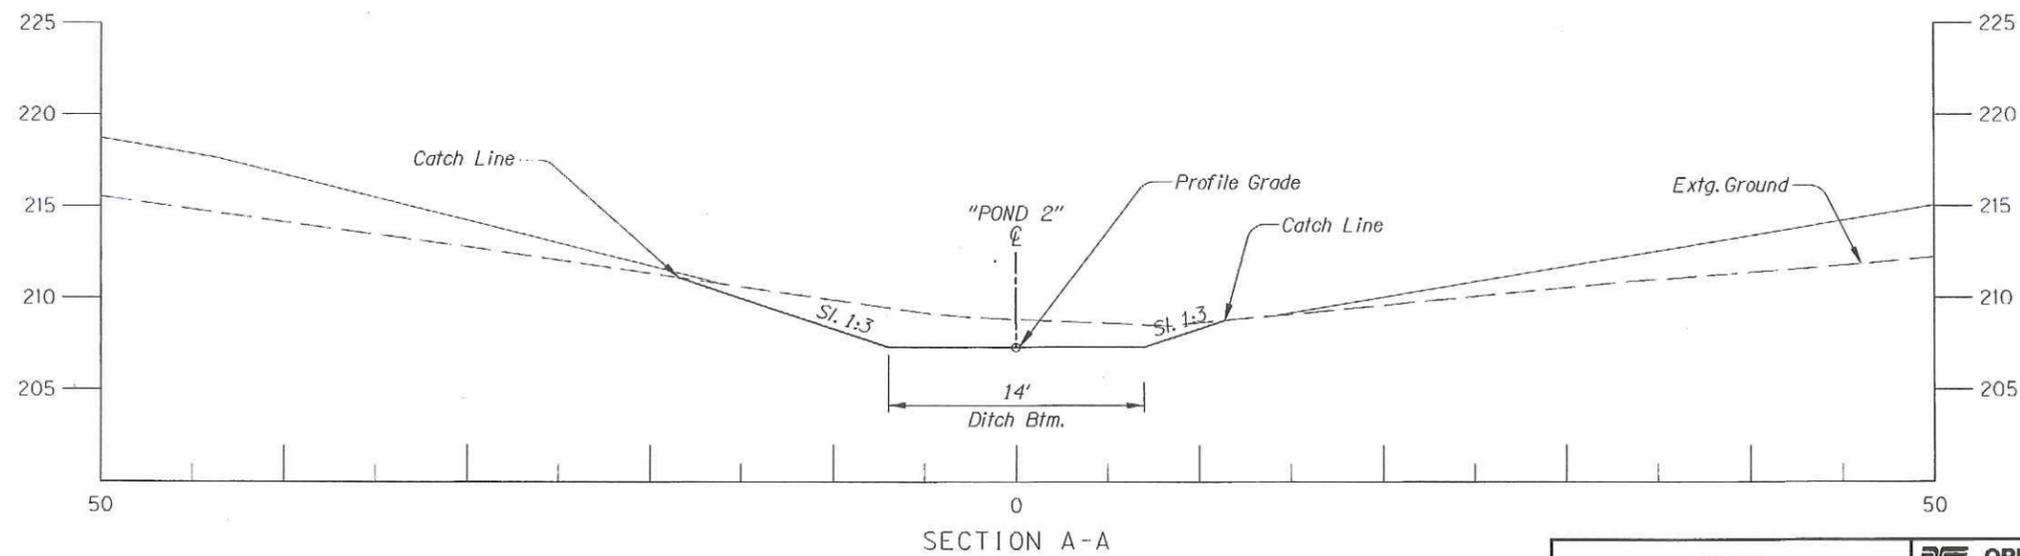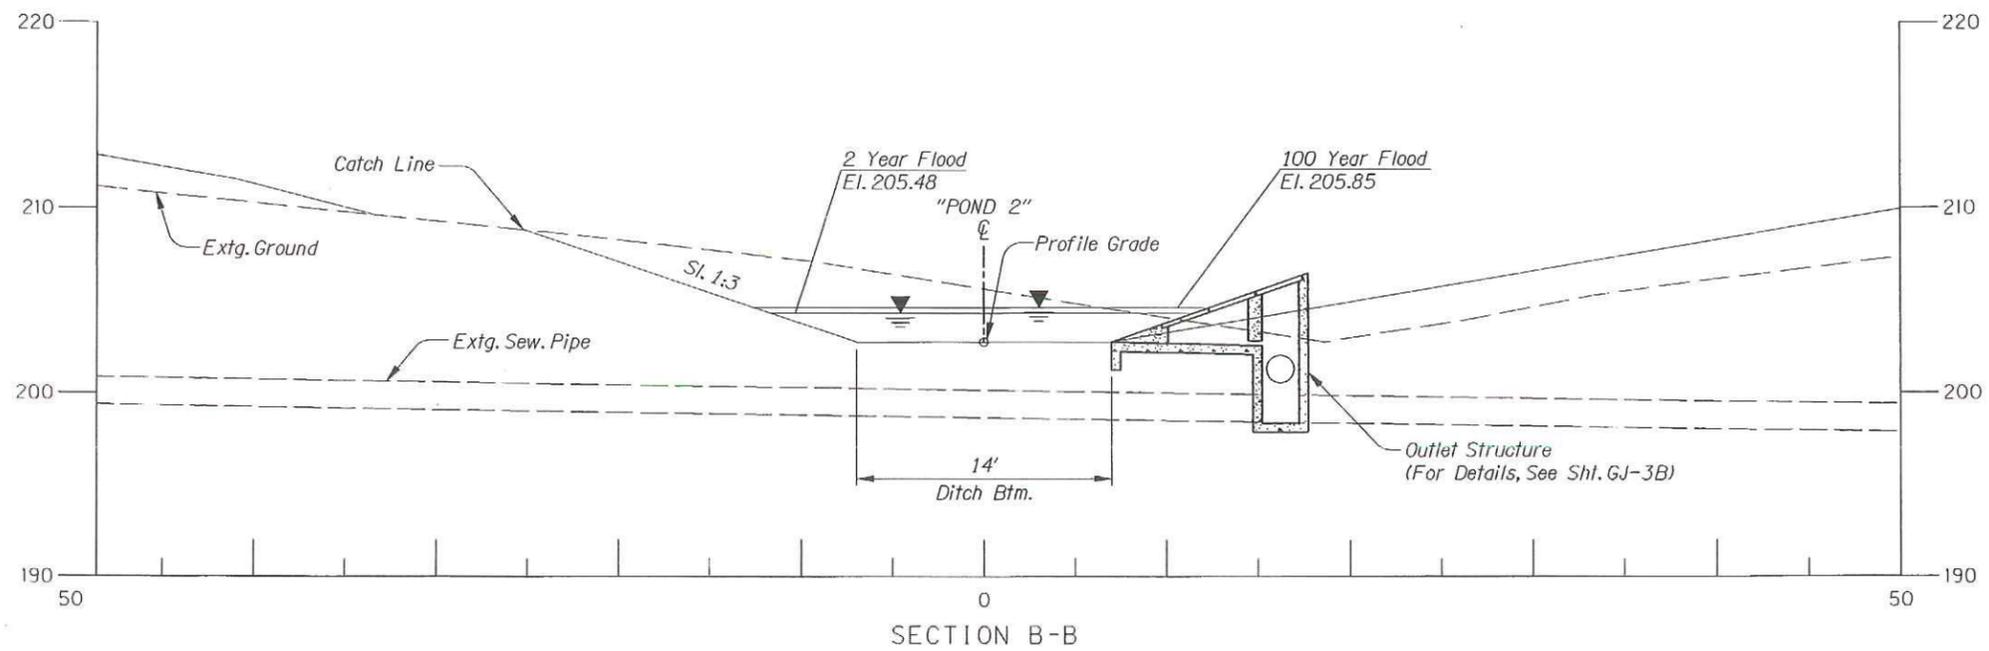

**"AS CONSTRUCTED"**  
*Mark Beon*  
 Date 6/26/09 Project Mngr

**CONSULTING ENGINEERS**  
 Corporate Office: 920 COUNTRY CLUB ROAD, SUITE 100B EUGENE, OREGON 97401-8089  
 2235 MISSION STREET SE, SUITE 100 SALEM, OREGON 97302-1295  
 1335 POPLAR DRIVE MEDFORD, OREGON 97504-5207

REGISTERED PROFESSIONAL ENGINEER  
 12295  
*Jerome D. Lane*  
 OREGON  
 JULY 5, 1983  
 JEROME D. LANE  
 EXPIRES: 12/31/06




**OREGON DEPARTMENT OF TRANSPORTATION**  
 ROADWAY ENGINEERING SECTION

1-205: WILLAMETTE RIVER BR. -  
 PACIFIC HWY. (UNIT 3) SEC.  
 EAST PORTLAND FREEWAY  
 CLACKAMAS & WASHINGTON COUNTIES

Design Team Leader - Jerry Lane  
 Designed By - James Kent  
 Drafted By - Mathew Bunde

**POND 2**  
**CROSS SECTIONS**

SHEET NO. GJ-3A

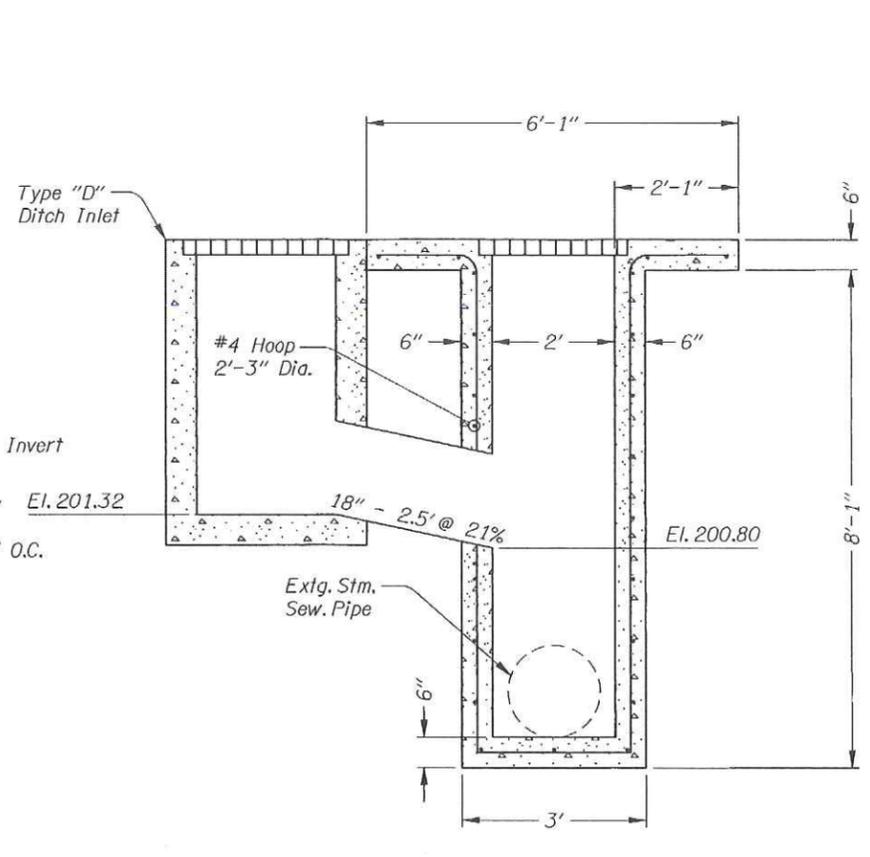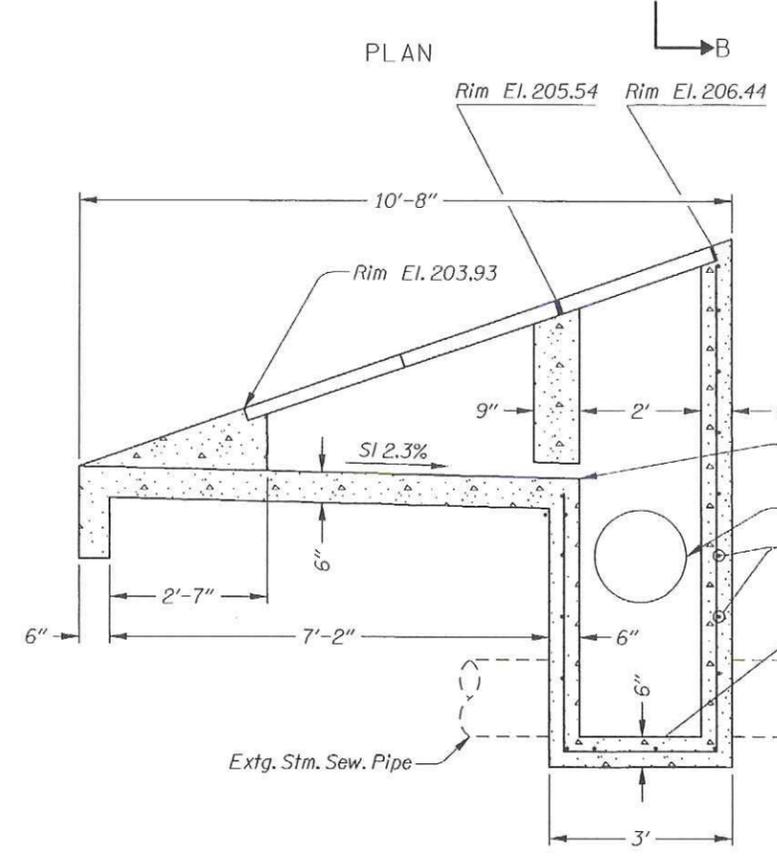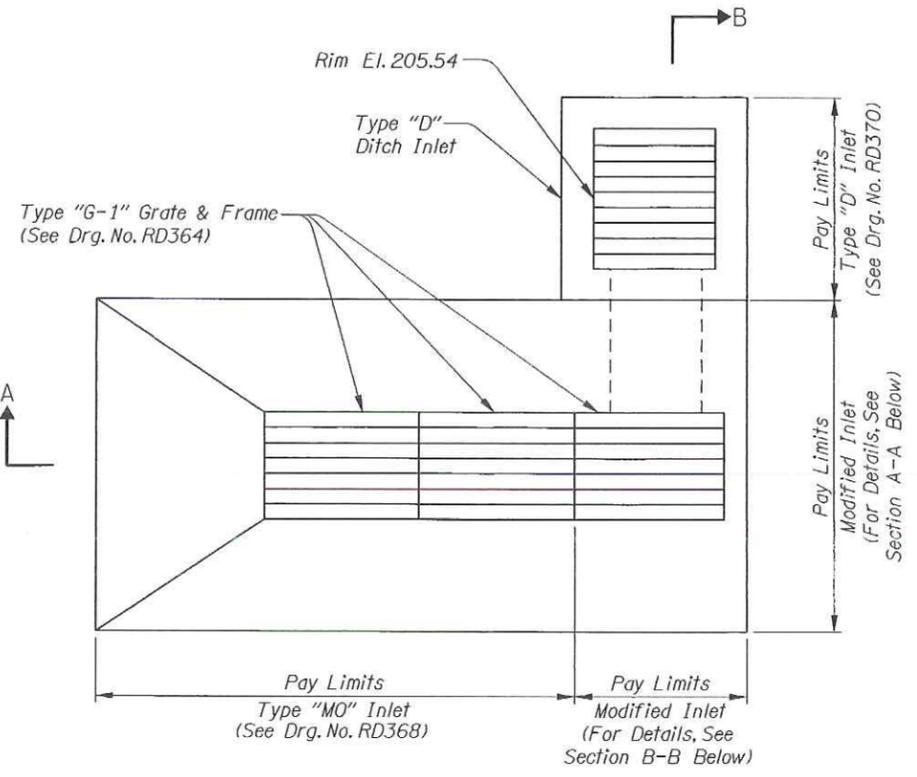

OUTLET STRUCTURE

GENERAL NOTES:

All Material And Workmanship Shall Conform To The 2002 Oregon Standard Specifications For Construction.

All Reinforcement Steel Shall Conform To Astm Specification A615, Grade 60 Or A706.


The Following Splice Lengths Shall Be Used.

Bar Size	3	4	5	6	7	8	9	10	11	
Splice Length	Uncoated	1'-0"	1'-4"	1'-8"	2'-0"	2'-8"	3'-6"	4'-4"	5'-7"	6'-9"
	Epoxy Coated	1'-5"	1'-10"	2'-4"	2'-10"	3'-9"	4'-11"	6'-1"	7'-10"	9'-6"

All Bars Shall Be Placed 2" Clear Of The Nearest Face Of Concrete Unless Shown Otherwise.

Concrete Shall Be Commercial Grade Concrete ODOT Section 00440.

**"AS CONSTRUCTED"**  
 Mathew Bunde  
 Date 6/26/09 Project Mngr

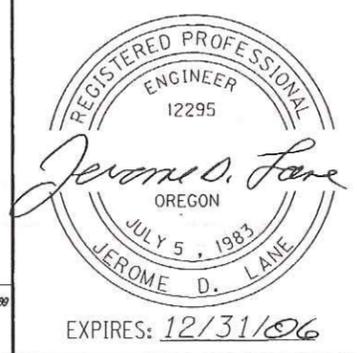

**OREGON DEPARTMENT OF TRANSPORTATION**  
 ROADWAY ENGINEERING SECTION

1-205: WILLAMETTE RIVER BR. -  
 PACIFIC HWY. (UNIT 3) SEC.  
 EAST PORTLAND FREEWAY  
 CLACKAMAS & WASHINGTON COUNTIES

Design Team Leader - Jerry Lane  
 Designed By - James Kent  
 Drafted By - Mathew Bunde

**POND 2**  
**DETAILS**

SHEET NO. GJ-3B

CONSULTING ENGINEERS  
 Corporate Office: 920 COUNTRY CLUB ROAD, SUITE 1008 EUGENE, OREGON 97401-6089  
 2235 MISSION STREET SE, SUITE 100 SALEM, OREGON 97302-1285  
 1335 POPLAR DRIVE MEDFORD, OREGON 97504-5207