

OPERATION & MAINTENANCE MANUAL

DFI No.: D00390

**Facility Type: Water Quality Biofiltration
Swale**



MARCH, 2011

1. Identification

Drainage Facility ID (DFI): **D00390**
Facility Type: Water Quality Biofiltration Swale
Construction Drawings: (V-File Number) 38V-055
Location: District: 7
Highway No.: 001
Mile Post: 130.46 / 130.48(beg./end)
Description: This facility is located in the median of I-5 (Hwy 001, Pacific Highway) on the south side of a railroad undercrossing. Access can be obtained from the inside lanes of I-5.

2. Facility Contact Information

Contact the Engineer of Record, Region Technical Center, or Geo-Environmental's Senior Hydraulics Engineer for:

- Operational clarification
- Maintenance clarification
- Repair or restoration assistance

Engineering Contacts:

Region Technical Center Hydraulics Engineer (541) 957-3693

Or

Geo-Environmental Senior Hydraulics Engineer (503) 986-3365.

3. Construction

Engineer of Record: ODOT Designer – Region 3 Tech. Center, James Bauman, 541-957-3573

Facility construction: 2007
Contractor: CH2M Hill, Inc., (Design – Build)

4. Storm Drain System and Facility Overview

A water quality swale is a flat-bottomed open channel designed to treat stormwater runoff from highway pavement areas. This type of facility is lined with grass. Treatment by trapping sedimentation occurs when stormwater runoff flows through the grass.

Stormwater is conveyed to the facility by two separate storm sewer systems that collect water from the railroad overcrossing structures. These independent storm systems relay stormwater to a riprap pad located at the beginning of the swale. Refer to the Operational Plan in Appendix A for further information. Water conveyed into the swale undergoes treatment as it flows through the length of the channel. The treated water flows out of the swale and into a roadside ditch that is located in the I-5 median. The stormwater continues to flow in a southerly direction.

A. Maintenance equipment access:

Maintenance crew can access the facility from the left shoulder of northbound I-5 just prior to a guardrail flare and Bridge No. 20213.

B. Heavy equipment access into facility:

- Allowed (no limitations)
- Allowed (with limitations)
- Not allowed

C. Special Features:

- Amended Soils
- Porous Pavers
- Liners
- Underdrains

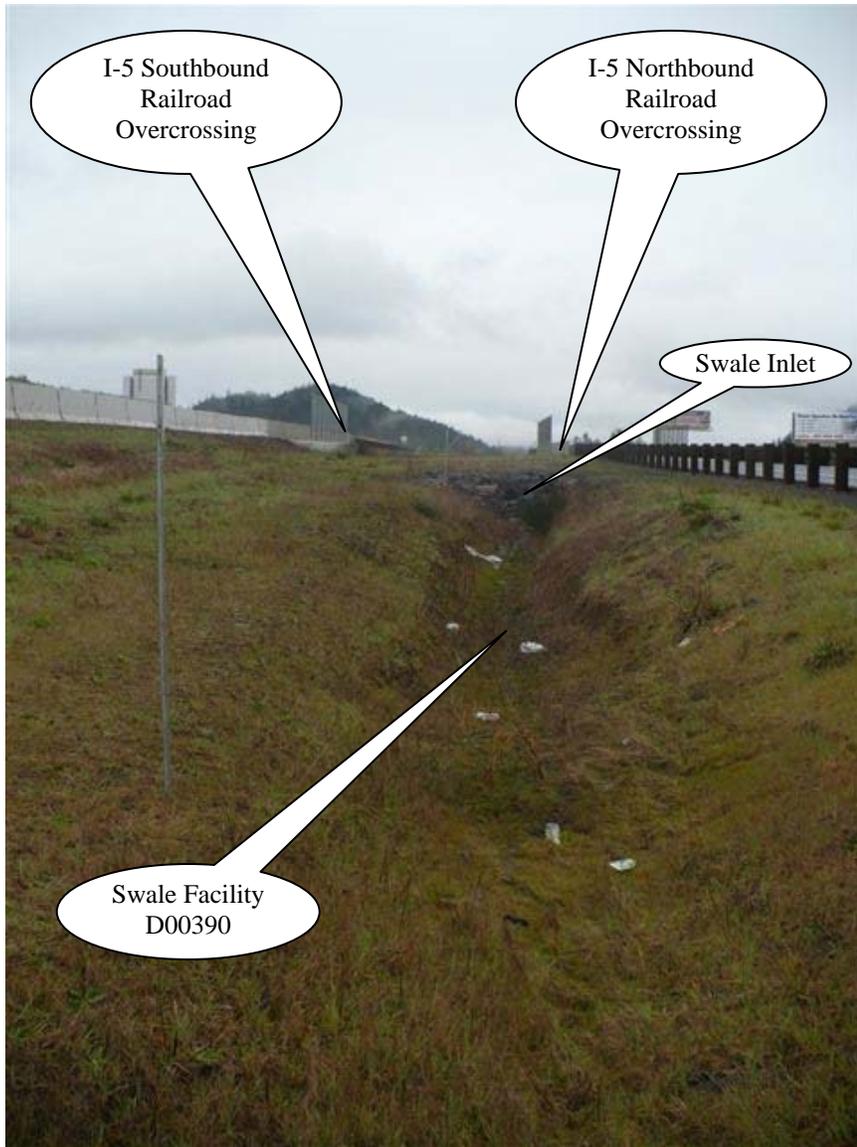


Photo 1: Looking north, flow into the swale is generated from the railroad overcrossing structures shown in the upper portion of the picture. Water is flowing towards the bottom of the picture.

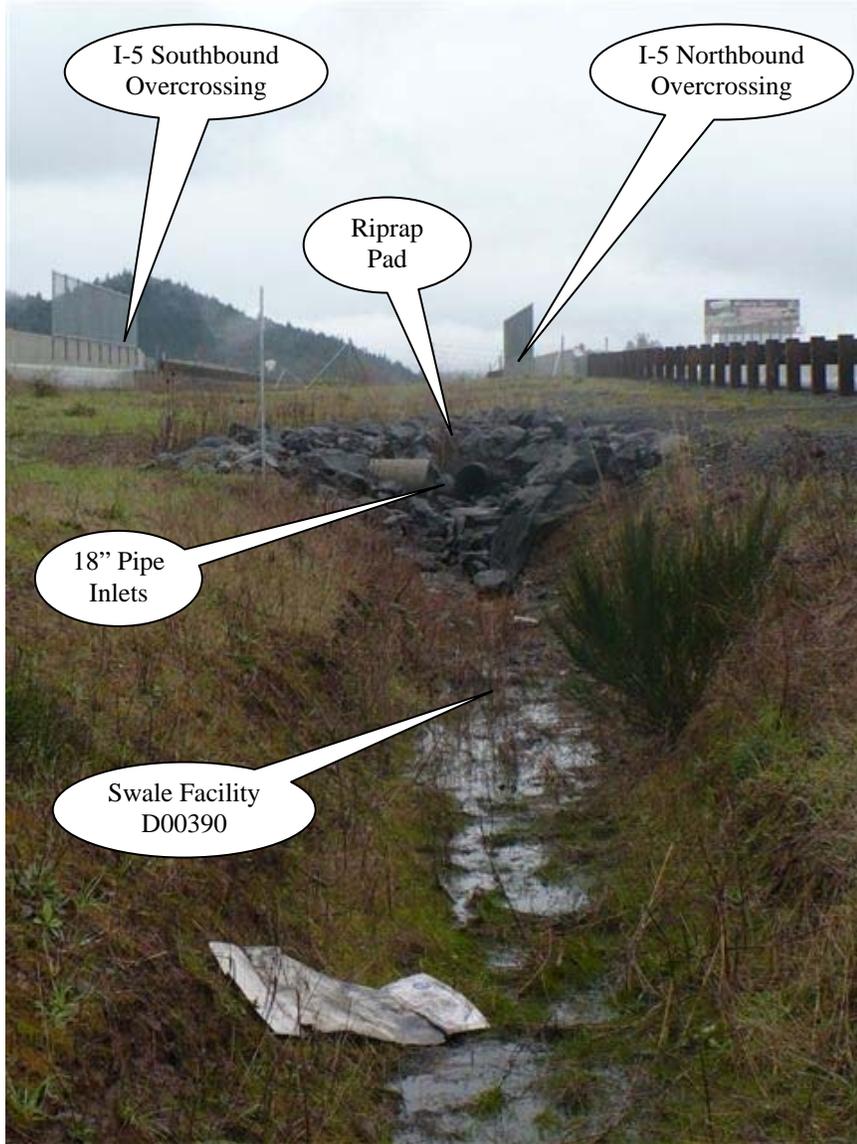


Photo 2: Looking north, flow into the swale is generated from the two 18-inch pipe inlets. Water is collected at the riprap pad and flows towards the bottom of the picture.



Photo 3: Looking south toward the facility access. Water flows toward the top of the picture.

5. Facility Haz Mat Spill Feature(s)

The water quality biofiltration swale can be used to store a volume of liquid by blocking the flow path and outlet channel of the water quality biofiltration swale. Constructing a sandbag dam near the outlet may help facilitate this process; see Photo 3.

6. Auxiliary Outlet (High Flow Bypass)

Auxiliary Outlets are provided if the primary outlet control structure can not safely pass the projected high flows. Broad-crested spillway weirs and over flow risers are the two most common auxiliary outlets used in

stormwater treatment facility design. The auxiliary outlet feature is either a part of the facility or an additional storm drain feature/structure.

The auxiliary outlet feature for this facility is:

- Designed into facility
- Other, as noted below
There is no auxiliary outlet for this facility.

7. Maintenance Requirements

Routine maintenance table for non-proprietary stormwater treatment and storage/detention facilities have been incorporated into ODOT's Maintenance Guide. These tables summarize the maintenance requirements for ponds, swales, filter strips, bioslopes, and detention tanks and vaults. Special maintenance requirements in addition to the routine requirements are noted below when applicable.

The ODOT Maintenance Guide can be viewed at the following website:

<http://www.oregon.gov/ODOT/HWY/OOM/MGuide.shtml>

Maintenance requirements for proprietary structures, such as underground water quality manholes and/or vaults with filter media are noted in Appendix C when applicable.

The following stormwater facility maintenance table (See ODOT Maintenance Guide) should be used to maintain the facility outlined in this Operation and Maintenance Manual or follow the Maintenance requirements outlined in Appendix C when proprietary structure is selected below:

- Table 1 (general maintenance)
- Table 2 (stormwater ponds)
- Table 3 (water quality biofiltration swales)
- Table 4 (water quality filter strips)
- Table 5 (water quality bioslopes)
- Table 6 (detention tank)
- Table 7 (detention vault)
- Appendix C (proprietary structure)
- Special Maintenance requirements:

Note: Special maintenance Requirements Require Concurrence from ODOT SR Hydraulics Engineer.

8. Waste Material Handling

Material removed from the facility is defined as waste by DEQ. Refer to the roadwaste section of the ODOT Maintenance Yard Environmental Management System (EMS) Policy and Procedures Manual for disposal options: <http://egov.oregon.gov/ODOT/HWY/OOM/EMS.shtml>


Contact any of the following for more detailed information about management of waste materials found on site:

ODOT Clean Water Unit	(503) 986-3008
ODOT Statewide Hazmat Coordinator	(503) 229-5129
ODOT Region Hazmat Coordinator	(541) 957-3594
ODEQ Northwest Region Office	(503) 229-5263

Appendix A




Content:

- **Operational Plan and Profile Drawing(s)**

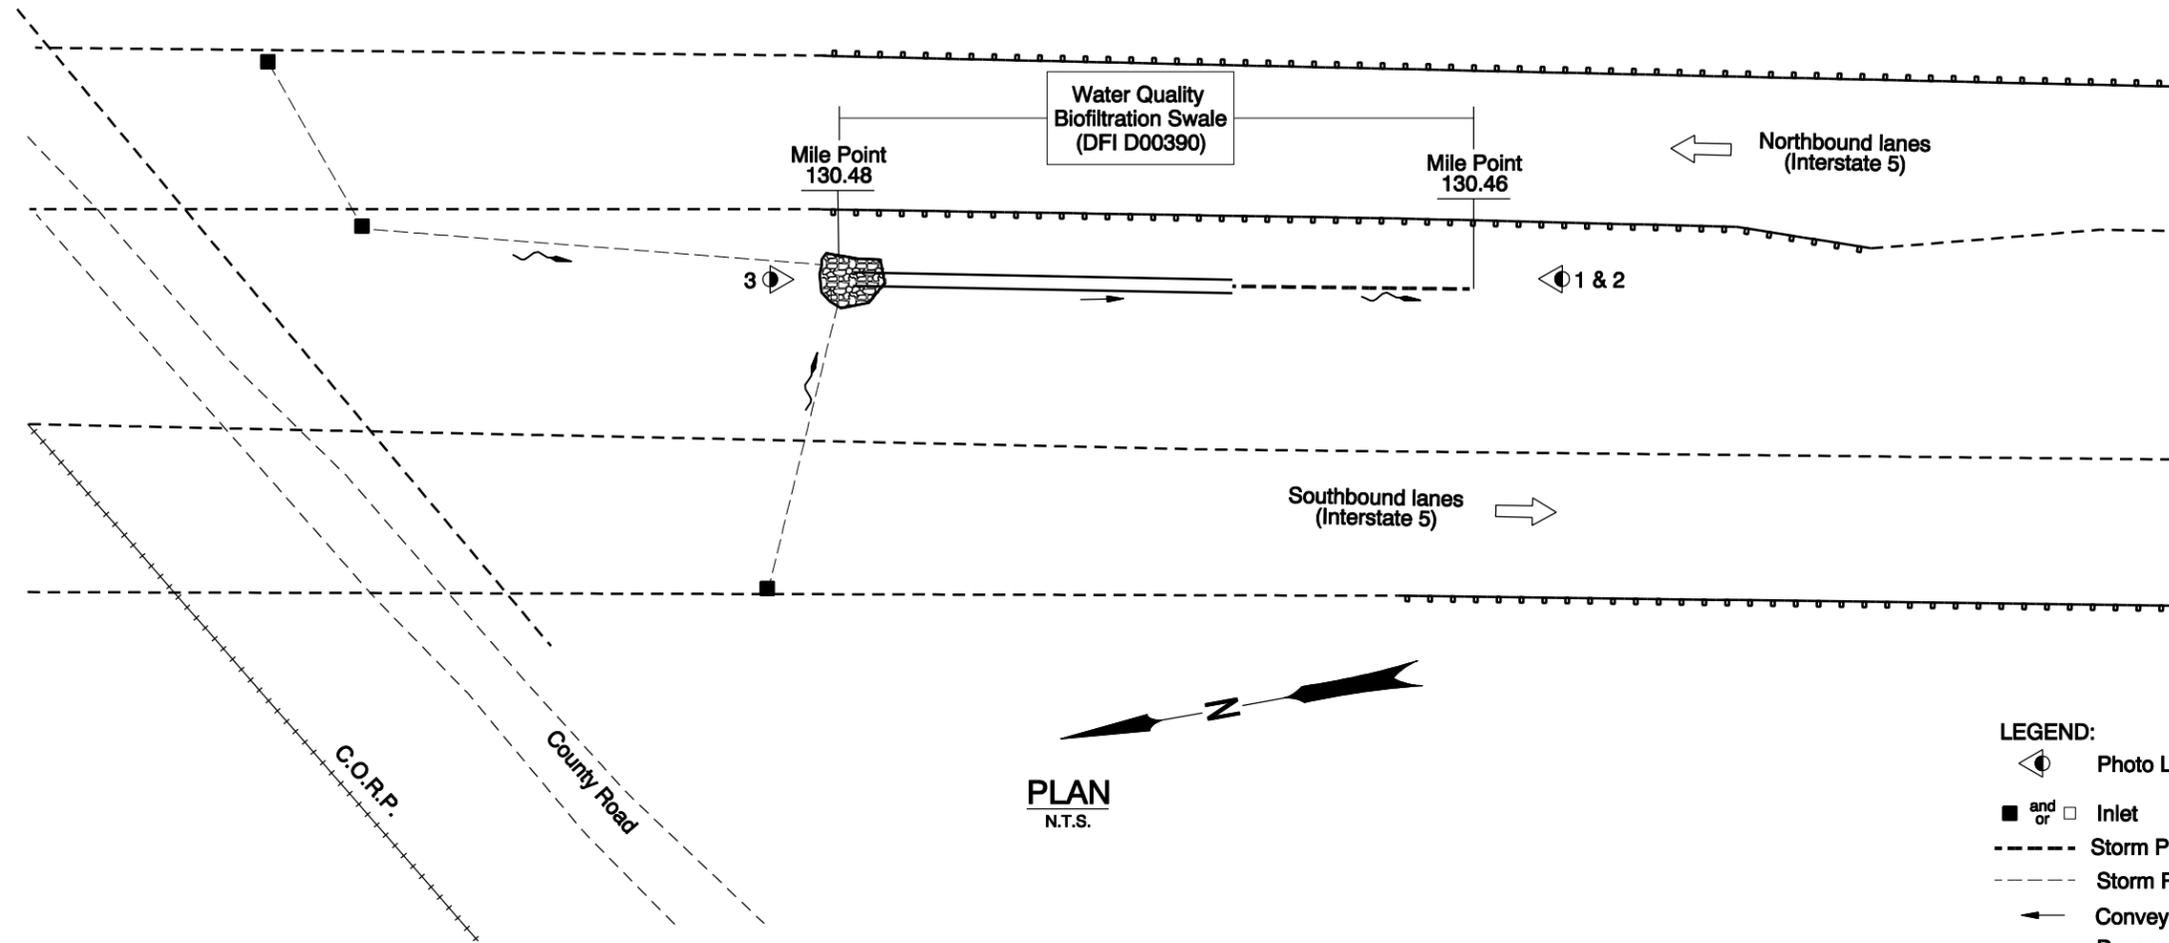

LEGEND:

- Photo Location / Direction
- Inlet
- Storm Pipe (Facility)
- Storm Pipe
- Conveyance Direction
- Pavement / Facility Flow Path

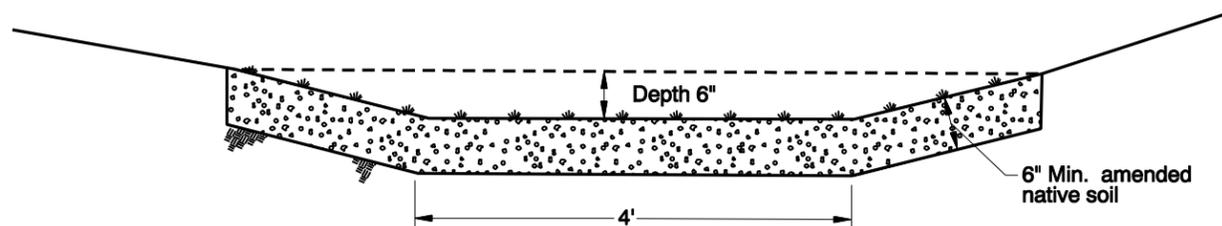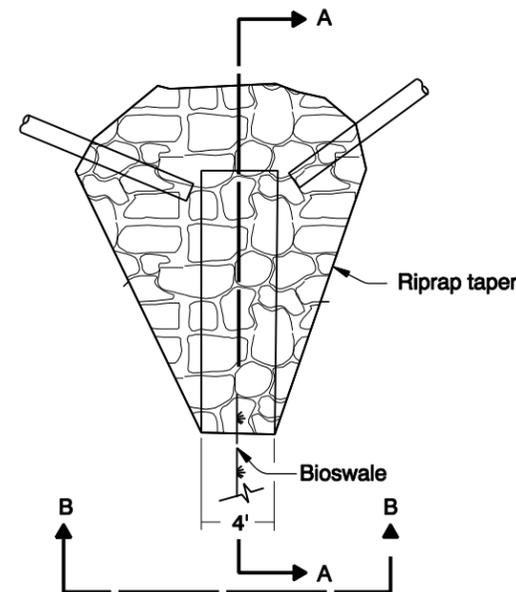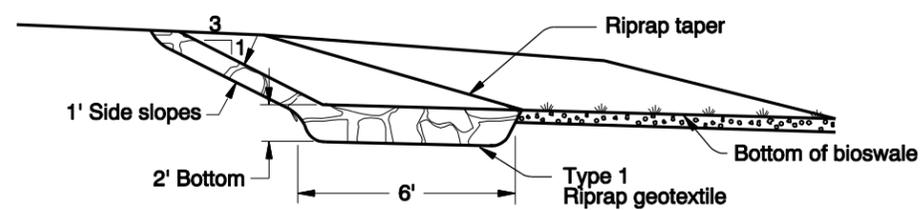

Prepared By: J. Carpenter

Drafted By: B. Shafer

OREGON DEPARTMENT OF TRANSPORTATION

DFI D00390
MAINTENANCE DISTRICT 7 HWY 001
WATER QUALITY BIOFILTRATION SWALE
 PACIFIC HIGHWAY MP 130.46/130.48
 DOUGLAS COUNTY

Appendix B

Content:

- **ODOT Project Plan Sheets**
 - *Cover/Title Sheet*
 - *Water Quality/Detention Plan Sheets*
 - *Other Details*

Index Of Roadway And Bridge Drawings On Sheet 1A Thru 1N
Standard Drg. Nos.


- BR140 Expansion Joint with Compression Seal or Poured Sealant
- BR145 Single Strip Seal Expansion Joint
- BR155 Bridge Joint Details (Joints A through F)
- BR203 Transition Concrete Bridge Rail to Guardrail
- BR236 Trailing End Br. Connection Concrete Rail to Guardrail
- BR240 Protective Fencing
- BR241 Protective Fencing
- BR350 Temporary Diaphragm Beam for Prestressed Concrete Beams
- RD300 Trench Backfill, Bedding, Pipe Zone and Multiple Installations
- RD302 Street Cut
- RD312 Subsurface Drain
- RD314 Open Grade HMAC Drainage Details
- RD318 Sloped Ends For Concrete Pipe
- RD320 Paved End, Slope For Culverts
- RD336 Standard Storm Sewer Manhole
- RD348 Manhole With Inlet
- RD356 Manhole Covers And Frames
- RD364 Concrete Inlets Types G-1, G-2 & G-2M
- RD368 Concrete Inlets, Type ME, M-O, And B-SL
- RD370 Ditch Inlet, Type D
- RD374 Area Drainage Basin or Field Inlet
- RD376 Miscellaneous Drainage Structures, Siphon Box and Inlet Adj. Cap
- RD386 Circular Concrete Pipe Fill Height Table
- RD400 Guardrail And Metal Median Barrier
- RD405 Guardrail And Metal Median Barrier Parts
- RD410 Guardrail Parts (Thrie Beam)
- RD415 Guardrail And Metal Median Barrier Parts
- RD425 2'6" - 4'0" Flared Terminal
- RD440 Guardrail Installation At Bridge Ends
- RD450 Guardrail Anchors (Steel)
- RD500 Precast Concrete Barrier Pin And Loop Assembly
- RD530 Guardrail Connection To Concrete Barrier
- RD545 Precast Tall (42") Concrete Barrier
- RD550 Cast In Place Tall Concrete Barrier Transition To Bridge Rail
- RD560 Cast In Place Tall Barrier Transition To Standard Concrete Barrier
- RD610 Asphalt Pavement Details
- RD700 Curbs
- RD720 Sidewalks
- RD755 Sidewalk Ramp Details
- RD760 Sidewalk Ramp Placement
- RD800 Traffic Delineators
- RD805 Traffic Delineator Installations
- RD810 Barbed And Woven Wire Fences
- RD900 Traffic Control Plans (Details)
- RD905 Traffic Control Plans (Intersection Details)
- RD906 Traffic Control Plans (Signalized Intersection Details)
- RD907 Traffic Control Plans (Multi-Lane Signalized Intersection Details)
- RD910 Traffic Control Plans (2-Lane, 2-Way and 3-Lane, 2-Way Roadways)
- RD915 Traffic Control Plans (Non-Freeway, Multi-Lane Sections)
- RD920 Traffic Control Plans (Freeway Section)
- RD925 Traffic Control Plans (Freeway Section)
- RD930 Traffic Control Plans (Freeway Section)
- RD945 Traffic Control Plans (Details)
- RD950 Barricades
- RD955 Temporary Impact Attenuators
- RD960 Temporary Impact Attenuators
- RD1005 Check Dams
- RD1010 Inlet Protection (Type 1, 2, & 3)
- RD1040 Sediment Fence, Supported Sediment Fence, Unsupported
- TM100 Temporary Wood Post Sizing Chart
- TM105 Orange Flag Board Mounting Details
- TM200 Sign Installation Details
- TM201 Sign Installation Details for Secondary Signs
- TM205 Aluminum Panels And Installation
- TM206 Sign Bracing Details Sign Mountain Details
- TM207 Additional Mountain Details
- TM211 Sign Details US And Interstate Route Shields
- TM212 Signing Details Oregon Route Shields

STATE OF OREGON DEPARTMENT OF TRANSPORTATION

PLANS FOR PROPOSED PROJECT GRADING, DRAINAGE, STRUCTURE AND PAVING I-5: SUTHERLIN - ROSEBURG SEC. DESIGN-BUILD PROJECT


**PACIFIC HIGHWAY
DOUGLAS COUNTY**

MAY 2007

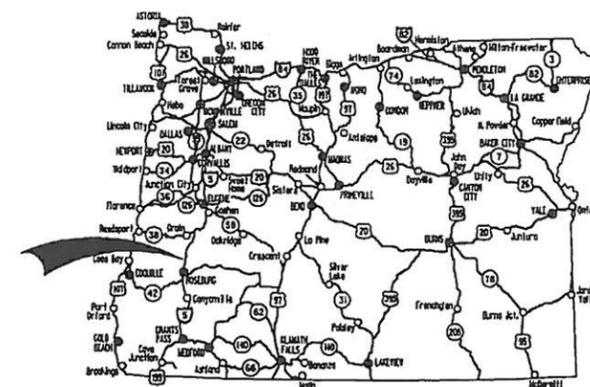

Overall Length Of Project - 13.33 Miles

ATTENTION:
Oregon Law Requires You To Follow Rules Adopted By The Oregon Utility Notification Center. Those Rules Are Set Forth In OAR 952-001-0010 Through OAR 952-001-0090. You May Obtain Copies Of The Rules By Calling The Center. (Note: The Telephone Number For The Oregon Utility Center Is (503) 232-1987.)

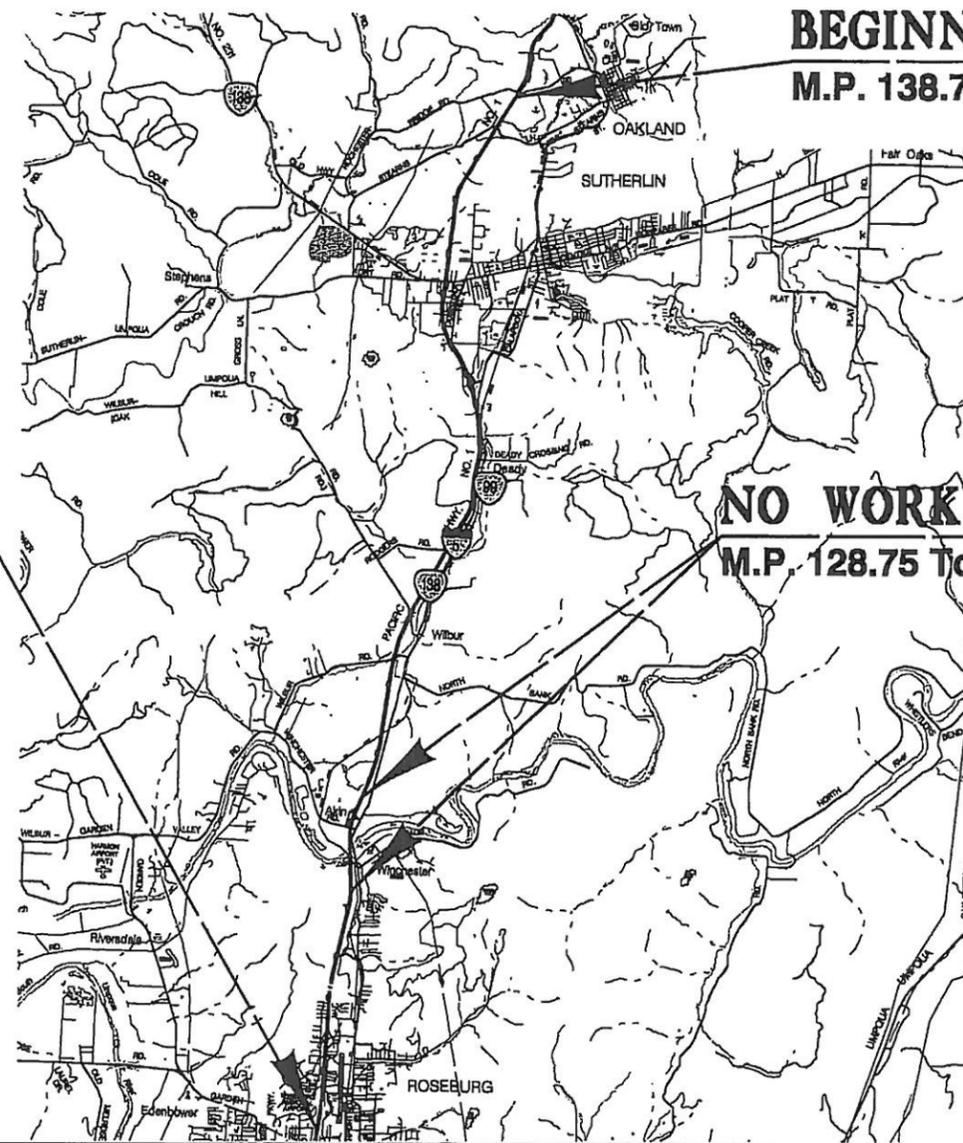

BEGINNING OF PROJECT

M.P. 138.71

END OF PROJECT

M.P. 125.38

NO WORK ZONE

M.P. 128.75 To. M.P. 129.80

REVISED AS CONSTRUCTED
5/06 CONTRACT 13070
DESIGN MGR. James Bauman



T. 25 S., R. 5 W., W.M.
T. 26 S., R. 5 W., W.M.
T. 26 S., R. 6 W., W.M.
T. 27 S., R. 6 W., W.M.



OREGON TRANSPORTATION COMMISSION
Stuart Foster CHAIRMAN
Gail L. Achterman COMMISSIONER
Mike Nelson COMMISSIONER
Randall Pape COMMISSIONER
Janice J. Wilson COMMISSIONER
Matt Garrett DIRECTOR OF TRANSPORTATION



PLANS PREPARED FOR
ODOT
BY:
CH2MHILL



EXPIRES: 12/31/07

OREGON DEPARTMENT OF TRANSPORTATION
CONCURRENCE


TECHNICAL SERVICES MANAGING ENGINEER _____ DATE _____

**I-5: SUTHERLIN-ROSEBURG SEC.
DESIGN-BUILD PROJECT
PACIFIC HIGHWAY
DOUGLAS COUNTY**

FEDERAL HIGHWAY ADMINISTRATION	PROJECT NUMBER	SHEET NO.
OREGON DIVISION	OTIA-IM-SOOI(192)	1

Note: See Sht. 1A For Additional Standard Drawings


▲	11/21/06	As Constructed							
Rev. No.	Date	Revision							

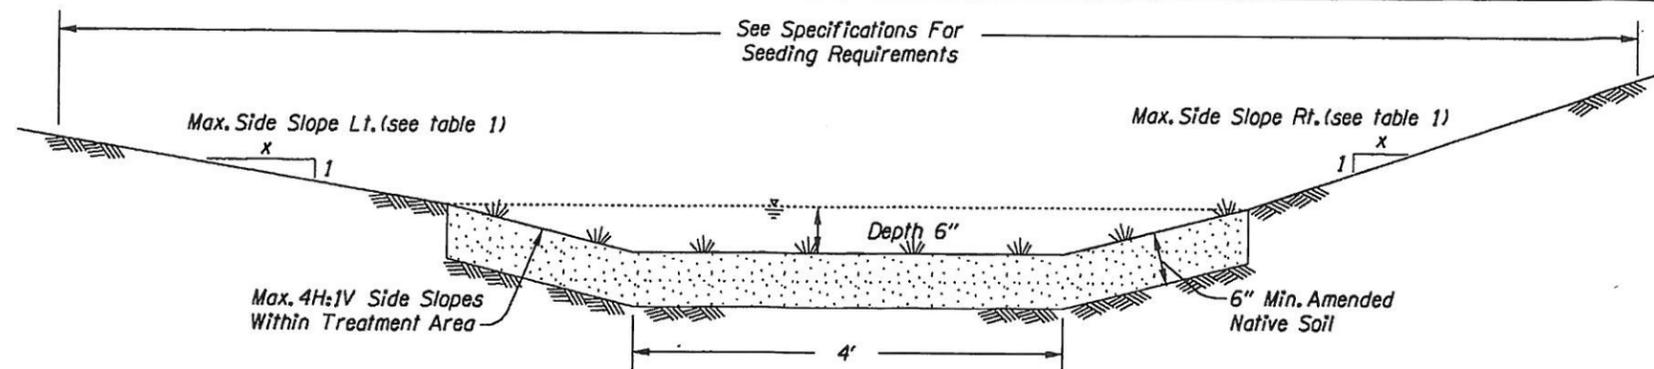


BIOSWALE SECTION B-B

Table 1. Max. Side Slopes

Bridge No.	Lt.	Rt.
07631	6	3
07628	3	3

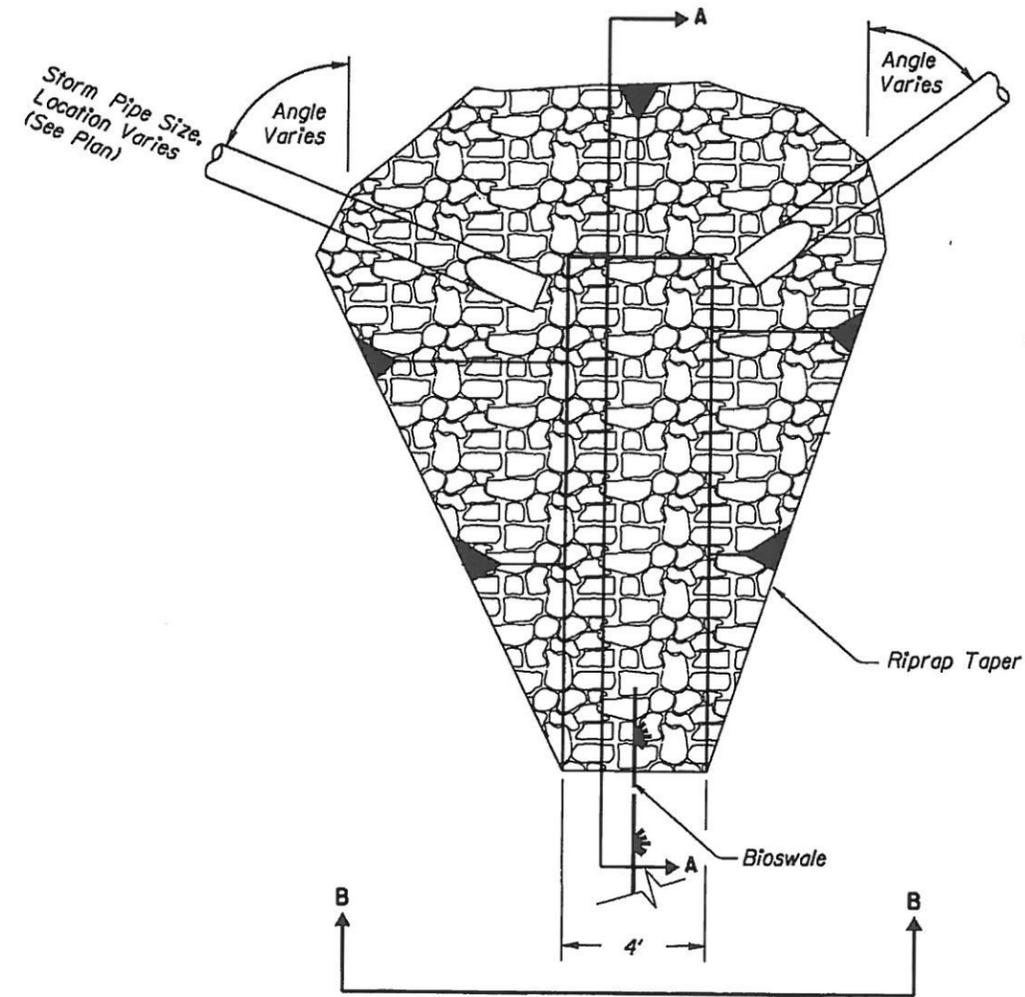

PLAN

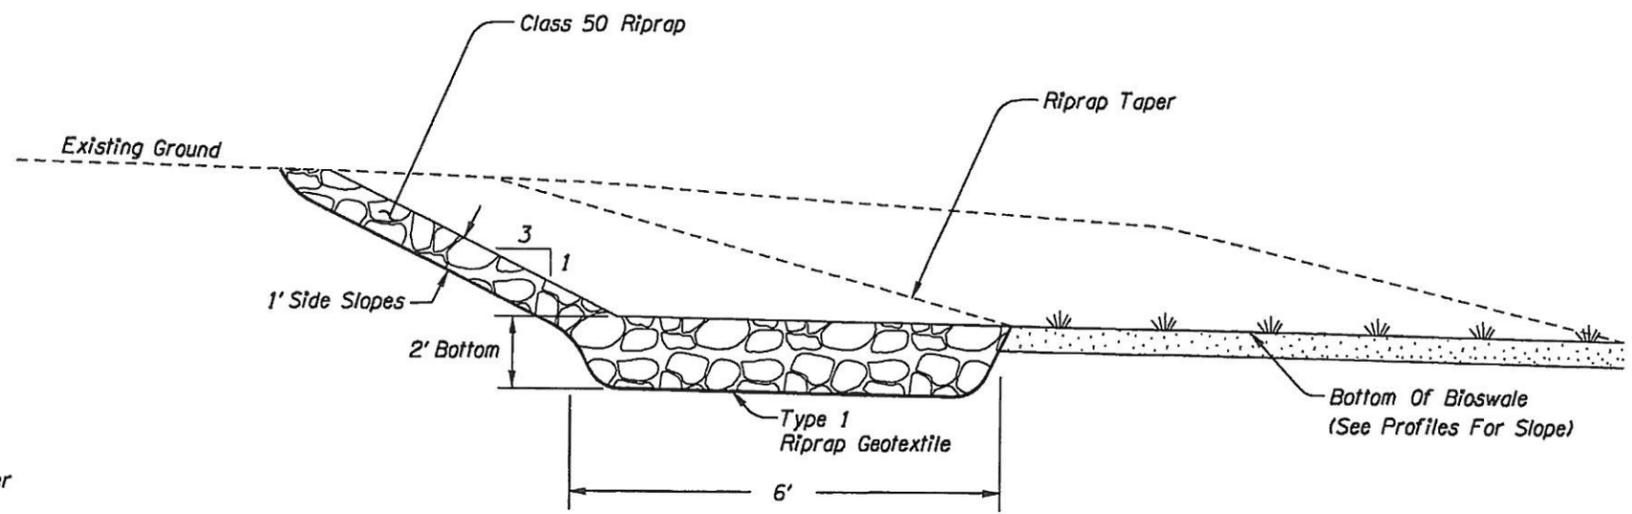

SECTION A-A

ROCK SPLASH PAD DETAIL
N.T.S.

OREGON DEPARTMENT OF TRANSPORTATION
ROADWAY ENGINEERING SECTION

1-5: SUTHERLIN-ROSEBURG SEC.
DESIGN-BUILD PROJECT
PACIFIC HIGHWAY
DOUGLAS COUNTY

Reviewed By - Mark Anderson
Designed By - Ryan Mitchell
Drafted By - Robert Luke

DRAINAGE DETAILS

SHEET NO.
2B-2


Rev. No.	Date	Revision

Sec. 18, T. 26 S., R. 5 W., W.M.

38V-55 ENGLISH

CH2MHILL



REVISED AS CONSTRUCTED
11/06 CONTRACT 13070

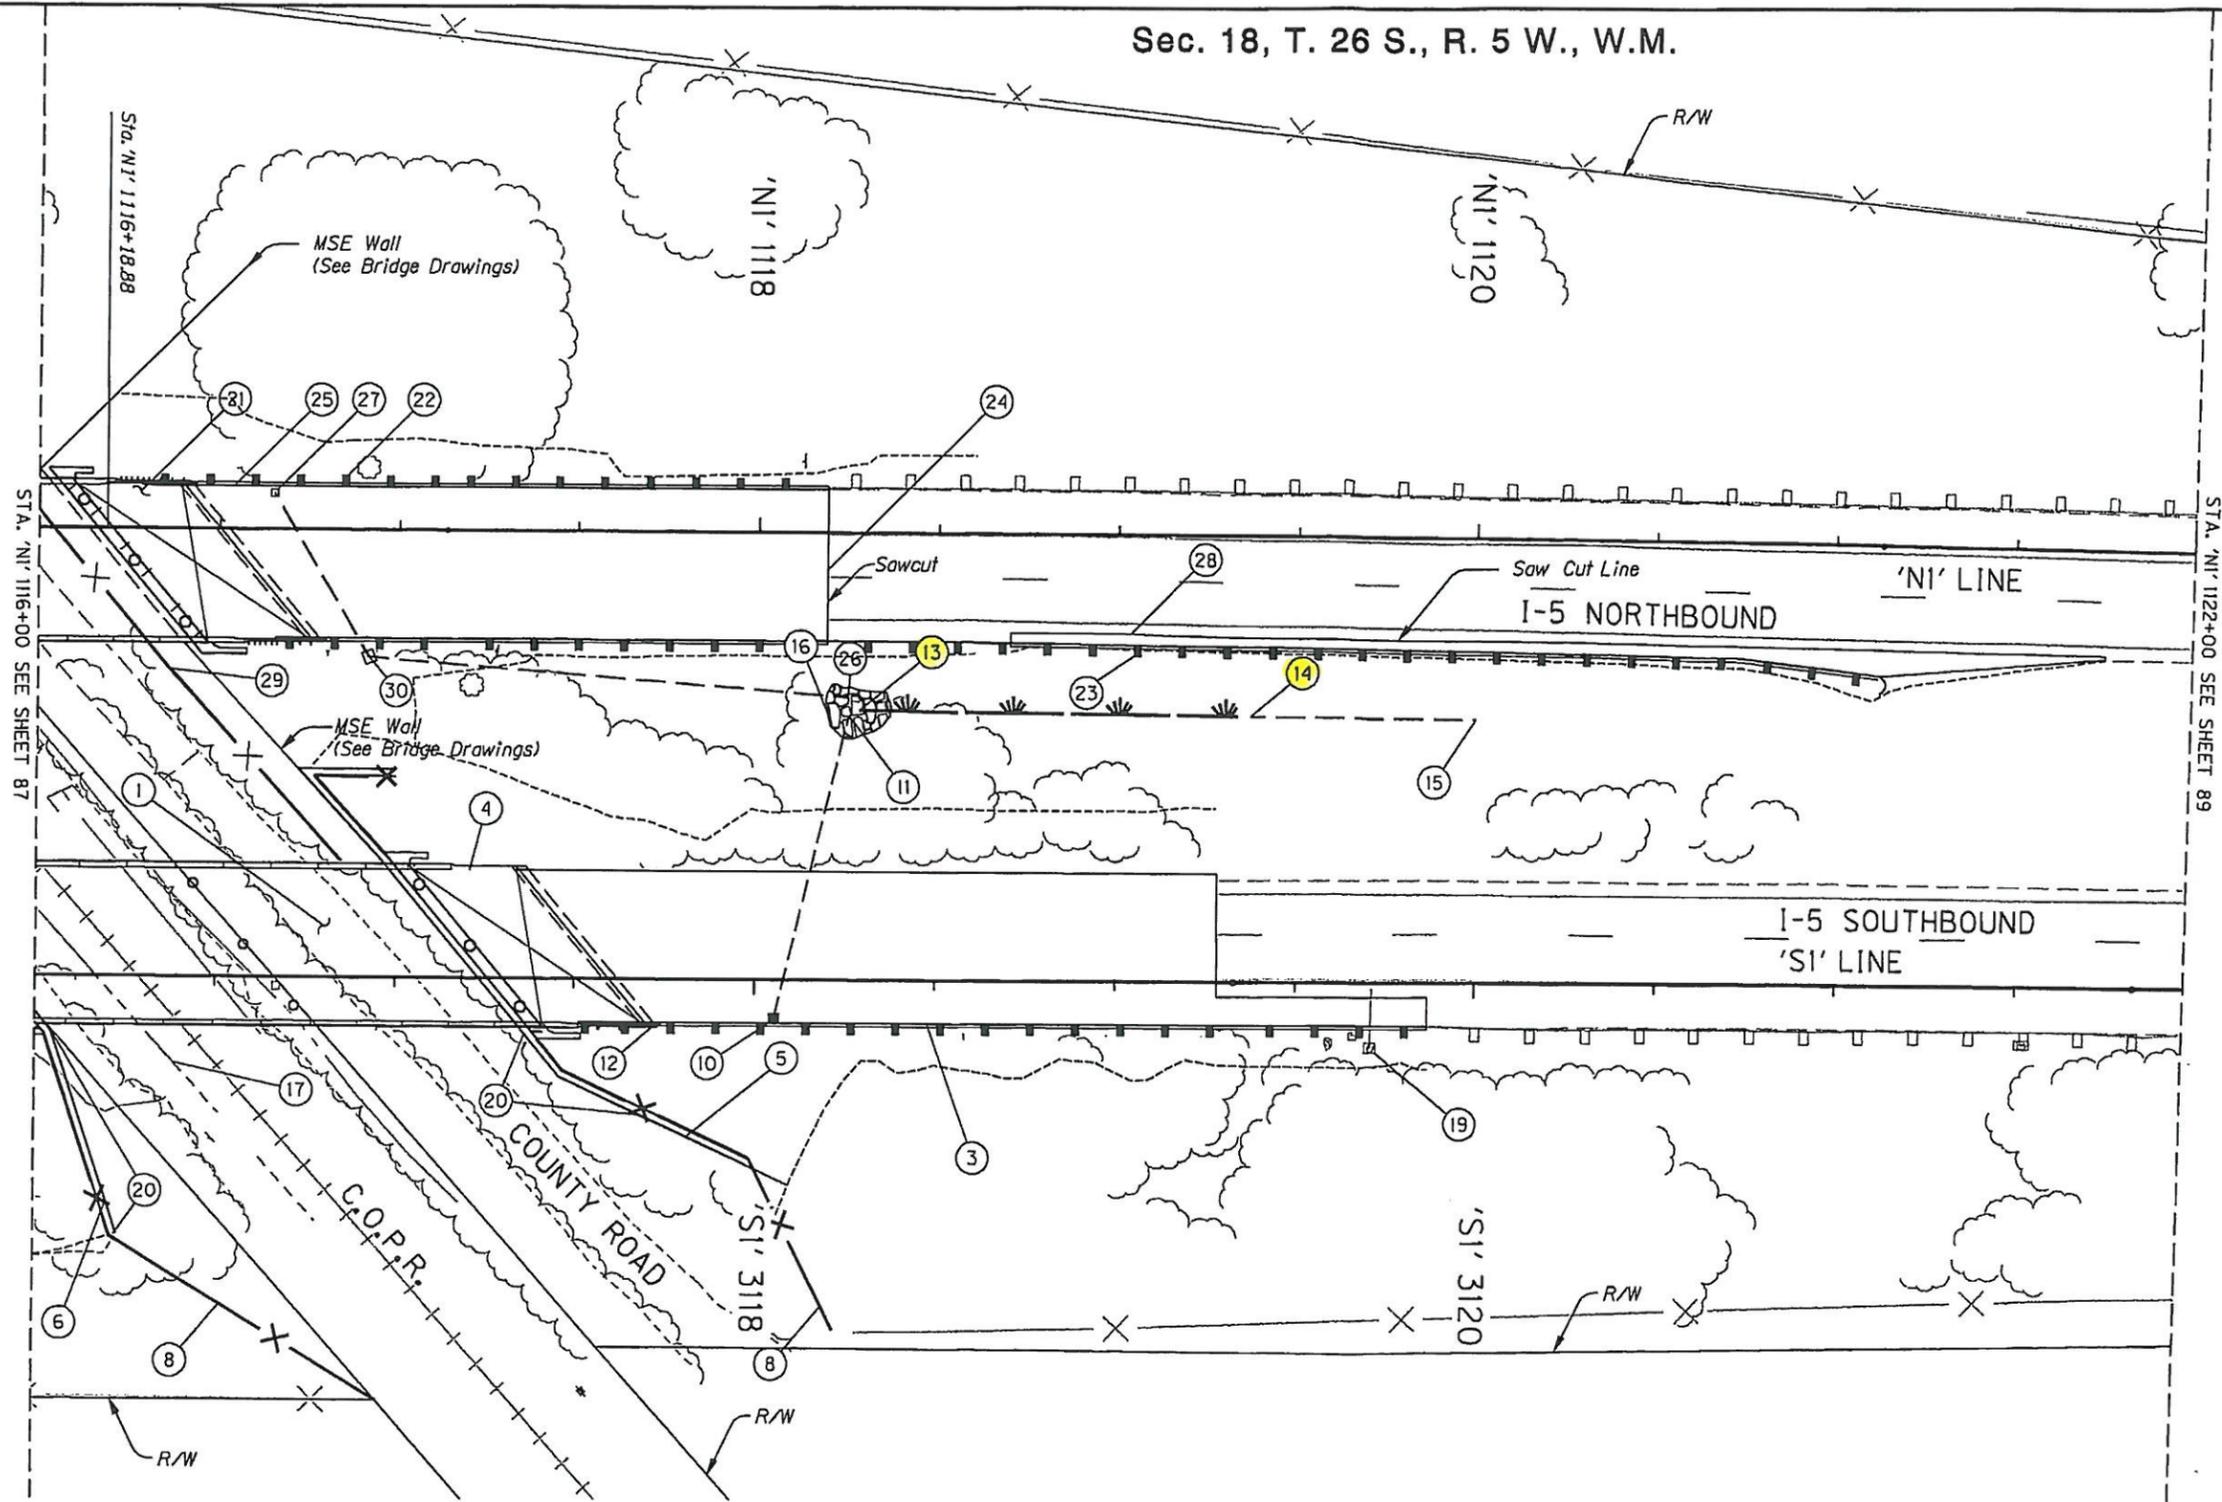

STA. 'N1' 1116+00 SEE SHEET 87

STA. 'N1' 1122+00 SEE SHEET 89

Rev. No.	Date	Revision
3	09/2006	As Constructed
2	06/02/2006	Replaced SB Guardrail With Median Barrier
1	10/20/2005	Northbound Construction Added

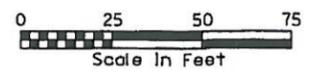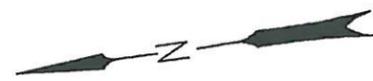

OREGON DEPARTMENT OF TRANSPORTATION ROADWAY ENGINEERING SECTION	
I-5: SUTHERLIN-ROSEBURG SEC. DESIGN-BUILD PROJECT PACIFIC HIGHWAY DOUGLAS COUNTY	
Reviewed By - Steve Katko Designed By - Ryan Brown Drafted By - Robert Luke	
B1 SB/NB STA. 'N1' 1116+00 TO STA. 'N1' 1122+00 ROADWAY PLAN	SHEET NO. 88

- ① Bridge No. 20212
Const. Structure - 141.5'
- ③ Sta. 'S1' 3117+51.27 Rt. To
Sta. 'S1' 3119+86.91 Rt.
Const. Guardrail Trailing
End Bridge Connection
Const. Guardrail (Type 2A) - 235.64'
Connect To Extg. Guardrail
(See Std. Drg. Nos. BR236, RD400,
RD405 & RD415)
- ⚠ ④ Const. Tall F Bridgerail To
Tall Conc. Barrier Transition
(For Details, See Shts. B1S-21A, 2G-7,
And 2A-32)
- ⑤ Sta. 'W2' 1+91.37 To Sta. 'W2' 3+58.97
Const. MSE Wall - 167.26'
(For Details, See Sht. B1S-301)
- ⑥ Const. MSE Wall
See Note 5, Sht. 87
- ⑧ Const. Type 1 Wire Fence
Place Fence On Top Of Retaining Wall
And Tie Into Extg. Fence
- ⑨ Weigh In Motion Junction Box &
Conduit Relocated By Others
- ⑩ Sta. "S1" 3118+05.45, Rt.
Const. Type "G-2" Inlet
Grate Elev. 541.36
- ⑪ Sta. "S1" 3118+25.60, Lt. 73.13'
F.L. Elev. 535.00' (See Drg. No.
RD318) Inst. 12" Storm Sew. Pipe
- 87' Provide Temporary Drainage
Facilities As Needed Until Const.
Of Rock Splash Pad
- ⑫ Sta. "S1" 3117+69.44, Rt. 12.0' To
Sta. "S1" 3118+08.44, Rt. 12.0'
Const. Conc. Or Asphalt Drainage Curb
(See Drg. No. RD700)
- ⑬ Sta. 'S1' 3118+28, Lt. 74.5'
Begin Bioswale
For Bioswale Typical Section,
See Sht. 2B-2
- ⑭ Sta. 'S1' 3119+38, Lt. 73.5'
End Bioswale
- ⑮ Sta. 'S1' 3119+39, Lt. 73.5' To
Sta. 'S1' 3120+00, Lt. 73.0'
Const. Ditch
Tie Into Bioswale And Regrade
Extg. To Drain
- ⑯ Sta. 'S1' 3118+28, Lt. 74.5' (+/-)
Const. Rock Splash Pad
For Detail, Sht. 2B-2
- ⑰ Reconst. Extg. Drainage Ditch
- ⑱ Protect Weigh-In Motion Equipment
- ⑳ Area Allowed For MSE Drain Pipe
Outfall Location
- ㉑ Bridge No. 20213
Const. Structure
(See Sht. 87B, Note 13)
- ㉒ Sta. 'N1' 1116+19.33 To
Sta. 'N1' 1118+18.88
Const. Guardrail Transition - 1
Const. Guardrail (Type 2A) - 163.5'
Const. Guardrail (Type 3) - 12.5'
Tie To Extg. Guardrail
(See Drg. Nos. BR203, RD400,
RD405, RD415 & RD440)
- ㉓ Sta. 'N1' 1116+55.09 To
Sta. 'N1' 1121+14.16
Const. Guardrail (Type 2A) - 425'
Const. Guardrail (Type 3) - 12.5'
Const. Guardrail Transition - 1
Const. Flared Terminal - 1
W=4', E=0
(See Drg. Nos. RD400, RD405
RD415, RD425 & RD440)
- ㉔ Sta. 'N1' 1118+18.88
Match Extg. Pymt.
- ㉕ Sta. 'N1' 1116+21.10 To
Sta. 'N1' 1116+71.60, Lt.
Const. Drainage Curb - 51'
(See Drg. No. RD700)
- ㉖ Sta. 'N1' 1118+24.79, 45.50' Rt.
Inst. 12" CPEP Storm Sew. Pipe - 134'
F.L. Elev. 535.00'
(See Drg. No. RD318)
- ㉗ Sta. 'N1' 1116+65.84, 11.00' Lt.
Const. Type "G-2" Inlet
Grate Elev. 540.86'
F.L. Elev. 536.44'
(See Drg. No. RD364)
- ㉘ Construct Full Depth Pavement And
New Type 2A Guardrail (See Note
23). Match Extg. Pavement.
- ㉙ Type 2 Fence
(See Drg. No. RD810)
- ㉚ Sta. 'N1' 1116+91.57, 35.20' Rt.
Const. Type "G2" Inlet ⚠
Grate Elev. 539.60
Inst. 12" CPEP Storm Sew. Pipe - 53'
F.L. Elev. 535.20 (Inlet & Outlet Pipes)
(See Drg. No. RD368)

Rev. No.	Date	Revision
2	09/2006	As Constructed
1	06/02/2006	Replaced SB Guardrail With Median Barrier

 OREGON DEPARTMENT OF TRANSPORTATION ROADWAY ENGINEERING SECTION	
I-5: SUTHERLIN-ROSEBURG SEC. DESIGN-BUILD PROJECT PACIFIC HIGHWAY DOUGLAS COUNTY	
Reviewed By - Steve Katko Designed By - Ryan Brown Drafted By - Robert Luke	
B1 SB/NB STA. 'N1' 1116+00 TO STA. 'N1' 1122+00 ROADWAY PLAN NOTES	SHEET NO. 88B