

WASHINGTON

★
PORTLAND

PACIFIC OCEAN

IDAHO

OREGON

GOLD BEACH AREA

● **MEDFORD**

CALIFORNIA

NEVADA


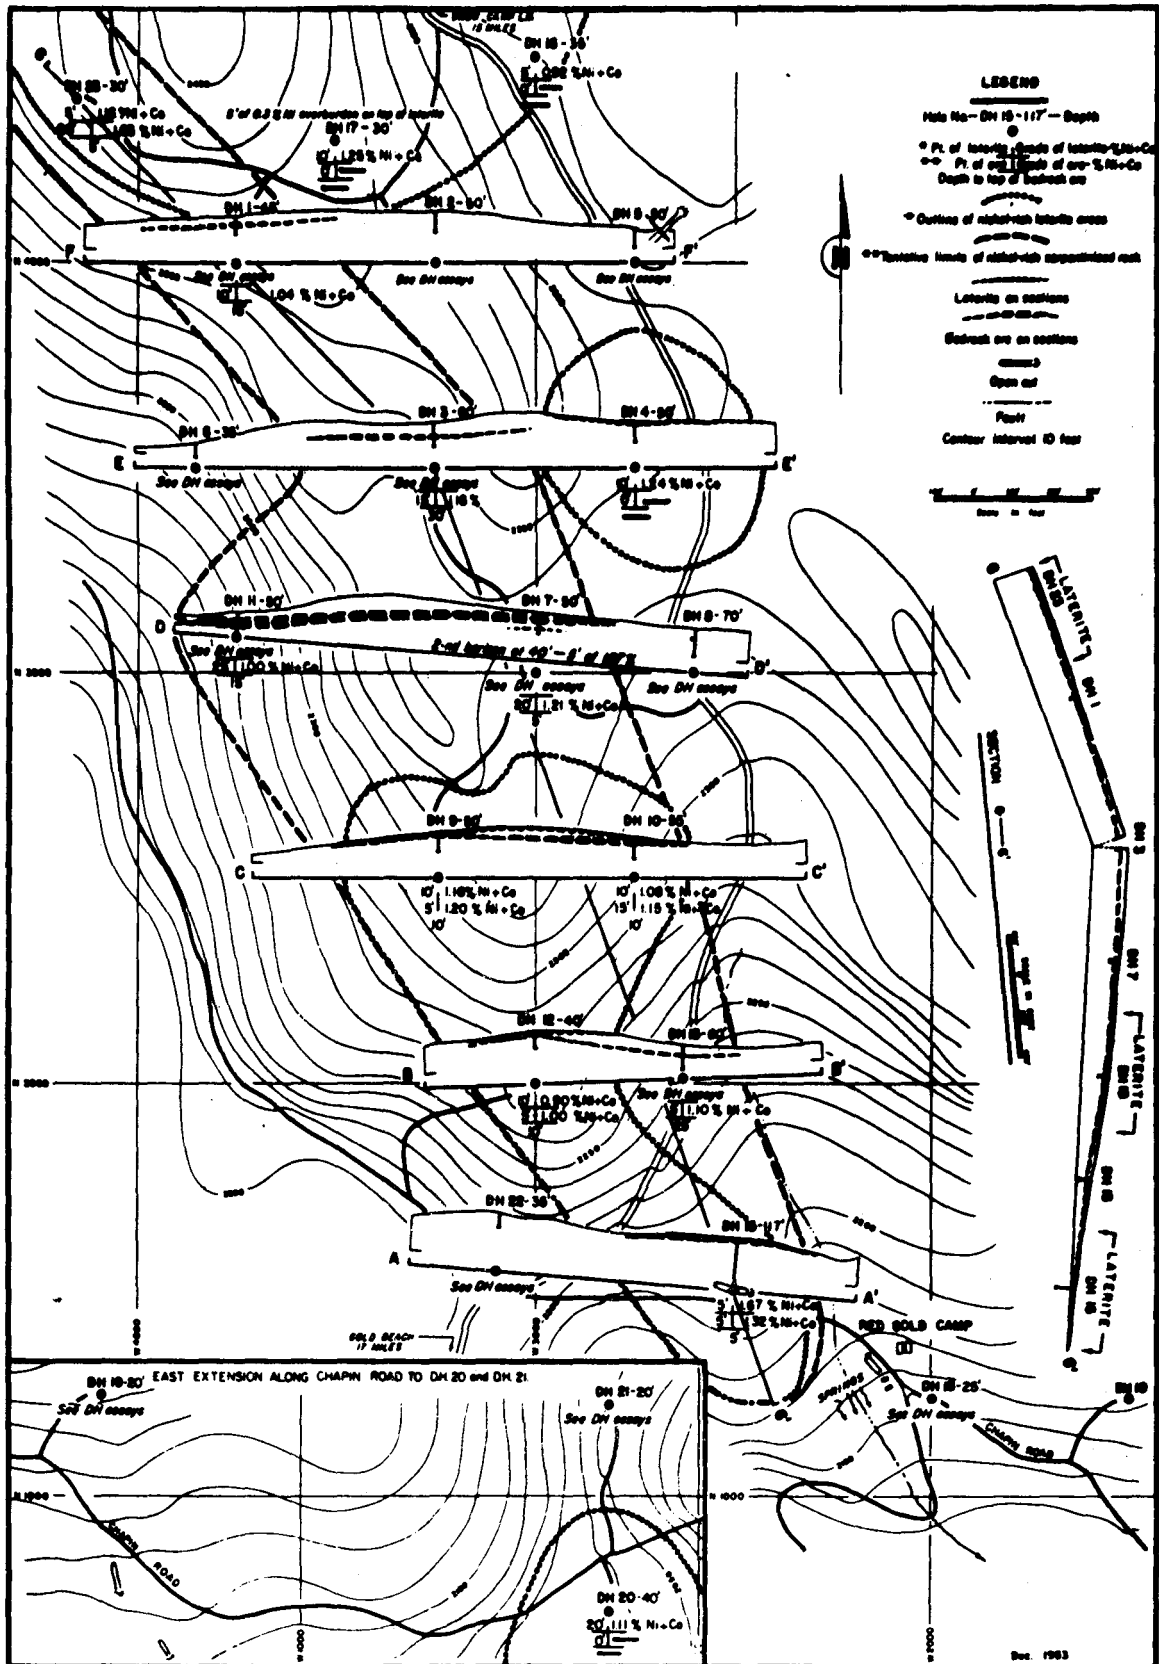


Figure 2. - Red Flats nickel deposit, Curry County, Oreg.

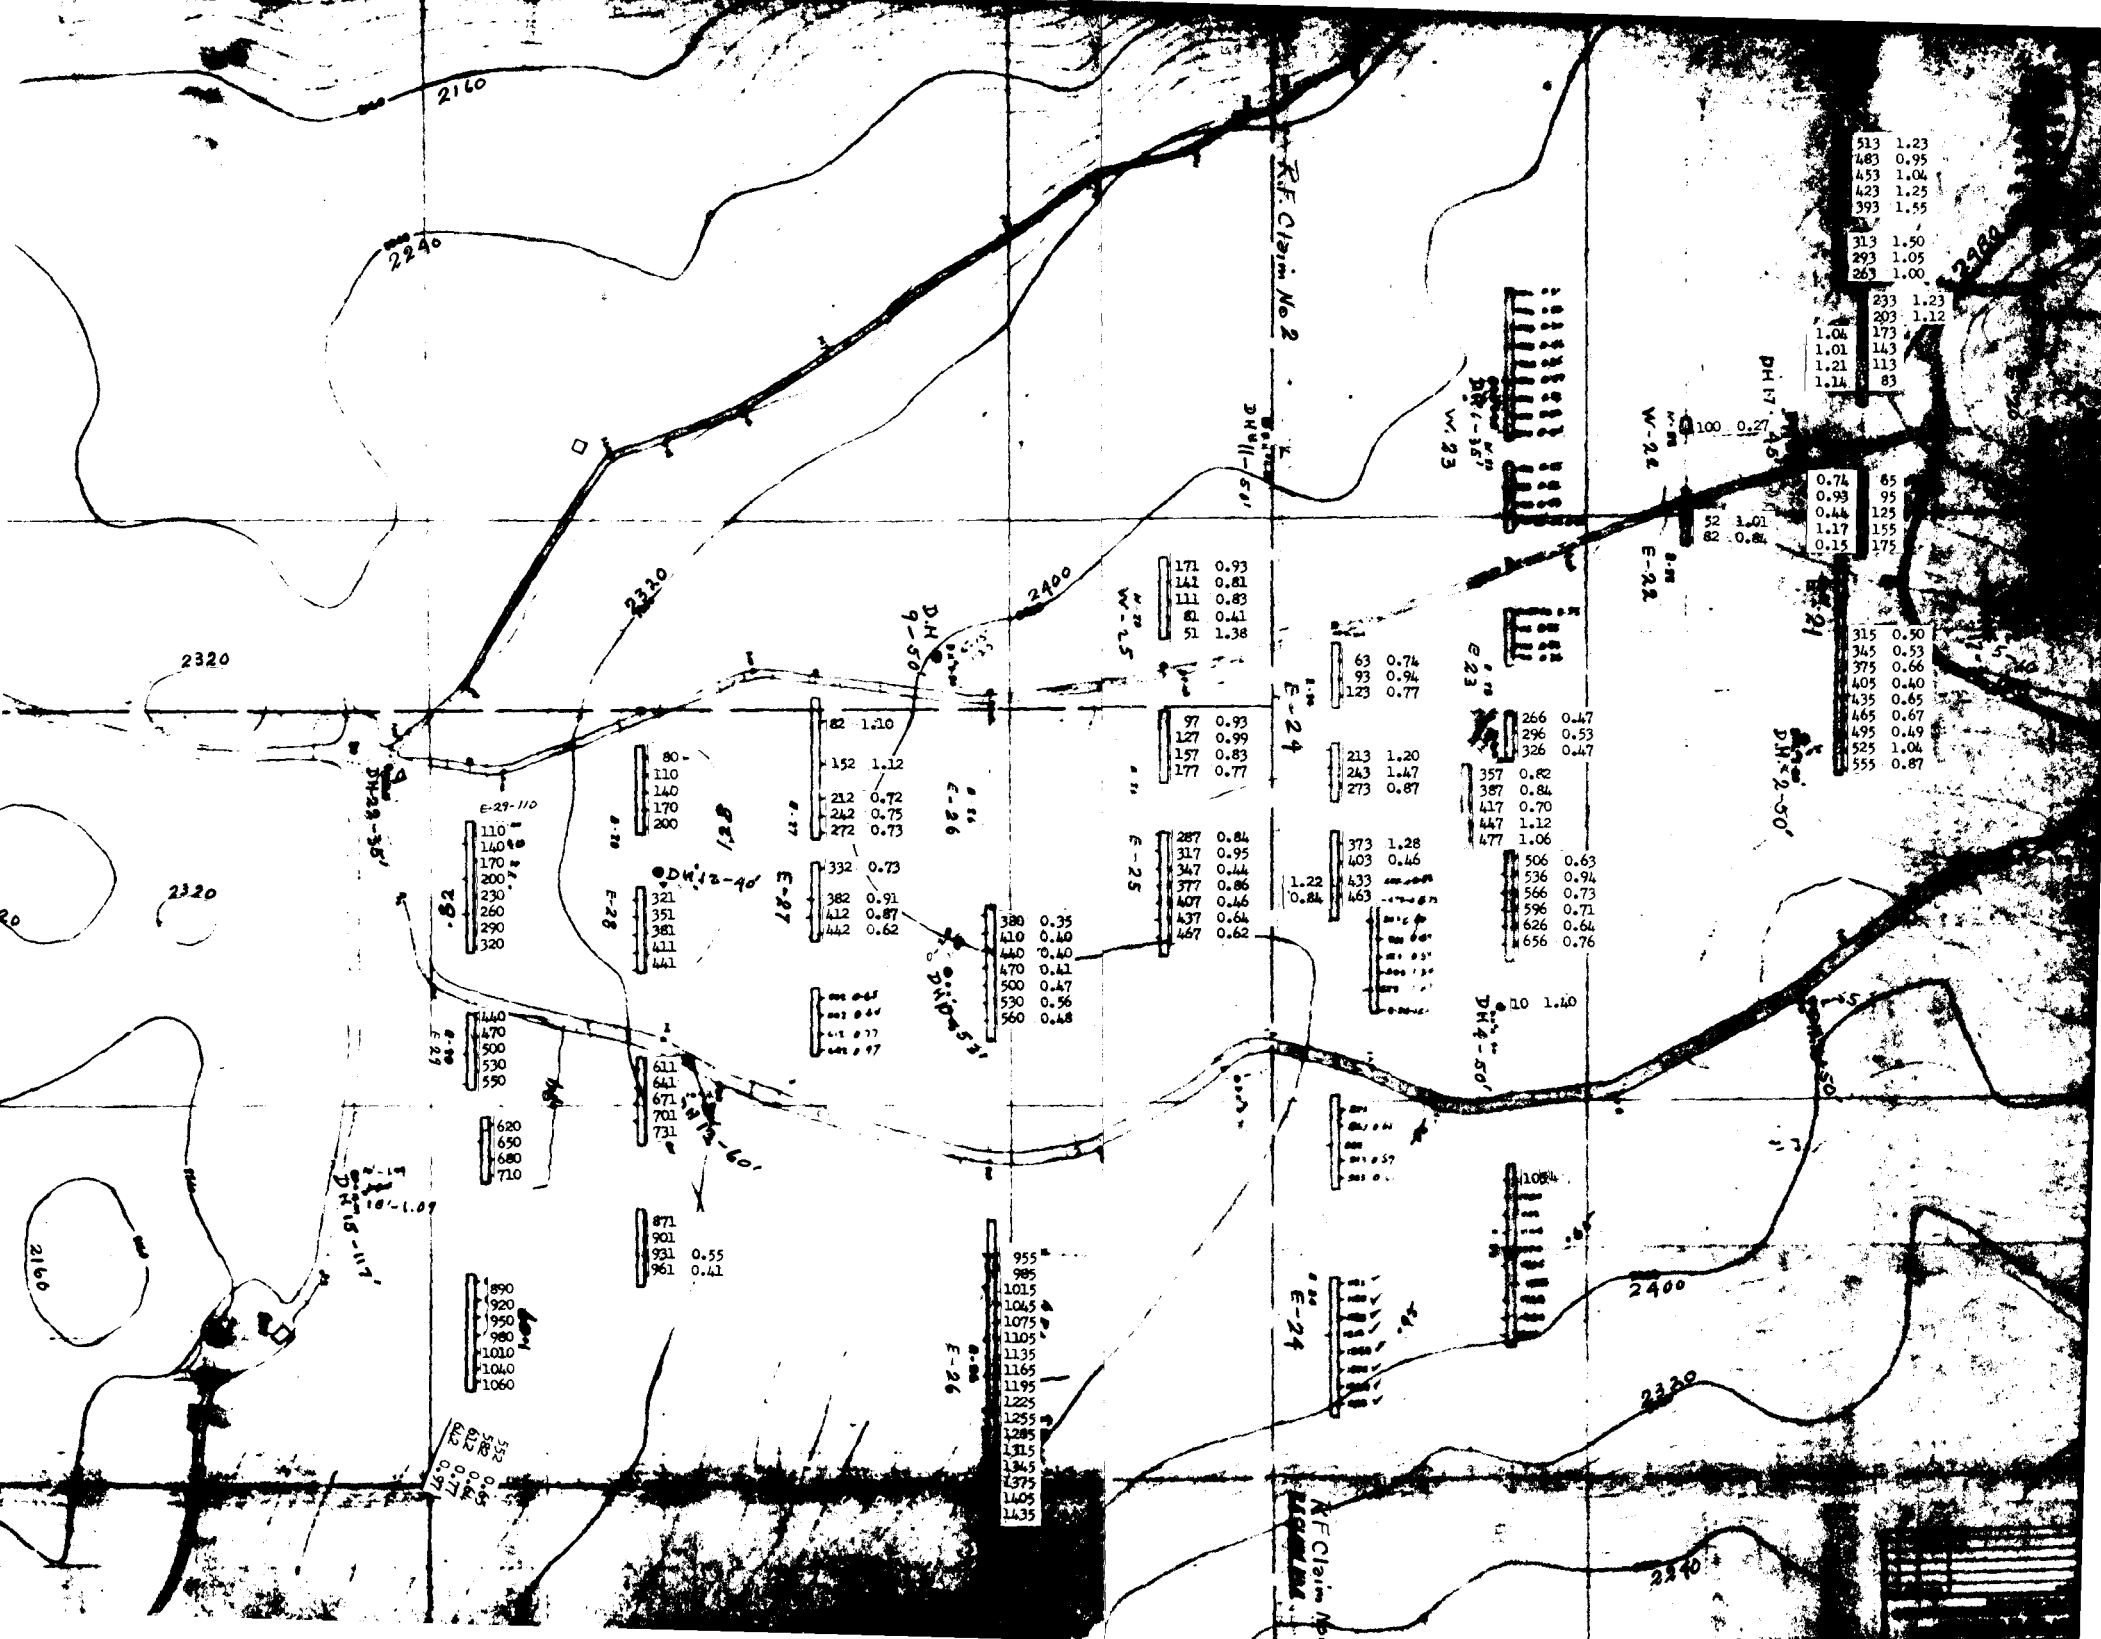

513	1.23
483	0.95
453	1.04
423	1.25
393	1.55
313	1.50
293	1.05
263	1.00

233	1.23
203	1.12
173	1.04
143	1.01
113	1.21
83	1.14

65	0.74
95	0.93
125	0.44
155	1.17
175	0.15

65	0.50
95	0.53
125	0.66
155	0.40
175	0.65
266	0.47
296	0.53
326	0.47
357	0.82
387	0.84
417	0.70
447	1.12
477	1.06
506	0.63
536	0.94
566	0.73
596	0.71
626	0.64
656	0.76

171	0.93
141	0.81
111	0.83
81	0.41
51	1.38

97	0.93
127	0.99
157	0.83
177	0.77

287	0.84
317	0.95
347	0.44
377	0.86
407	0.46
437	0.64
467	0.62

63	0.74
93	0.94
123	0.77

213	1.20
243	1.47
273	0.87

373	1.28
403	0.46
433	0.84
463	0.84

266	0.47
296	0.53
326	0.47
357	0.82
387	0.84
417	0.70
447	1.12
477	1.06

506	0.63
536	0.94
566	0.73
596	0.71
626	0.64
656	0.76

955	0.41
985	0.41
1015	0.41
890	0.41
920	0.41
950	0.41
980	0.41
1010	0.41
1040	0.41
1060	0.41

871	0.55
901	0.55
931	0.41
961	0.41

380	0.35
410	0.40
440	0.40
470	0.41
500	0.47
530	0.56
560	0.68

82	1.10
152	1.12
212	0.72
242	0.75
272	0.73

332	0.73
382	0.91
412	0.87
442	0.62

110	0.41
140	0.41
170	0.41
200	0.41
230	0.41
260	0.41
290	0.41
320	0.41

440	0.41
470	0.41
500	0.41
530	0.41
550	0.41

620	0.41
650	0.41
680	0.41
710	0.41

871	0.55
901	0.55
931	0.41
961	0.41

871	0.55
901	0.55
931	0.41
961	0.41

SKETCH MAP

RED FLAT AREA

Curry County, Oregon


Secs. 19,30 T.37 S. R.13 W.

Elevations Shown Obtained
From Altimeter Readings

To Pyramid Rock
X Hole No. 1 Elev. 2380'



SCALE

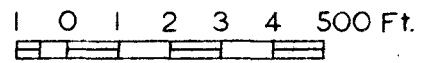

Hole No. 2
Elev. 2360' X

14 Mile Post

U.S.F.S.
Road

X Hole No. 3 Elev. 2265'

Dead End Road

14 mi To Pistol River P.O.
To Pistol River →


Spring Camp

Sawmill

X Hole No. 4
Elev. 2175'

To Chapin Property →

**INDEX MAP OF THE RED FLAT NICKEL CORP.
CLAIMS, CURRY COUNTY, OREGON.**

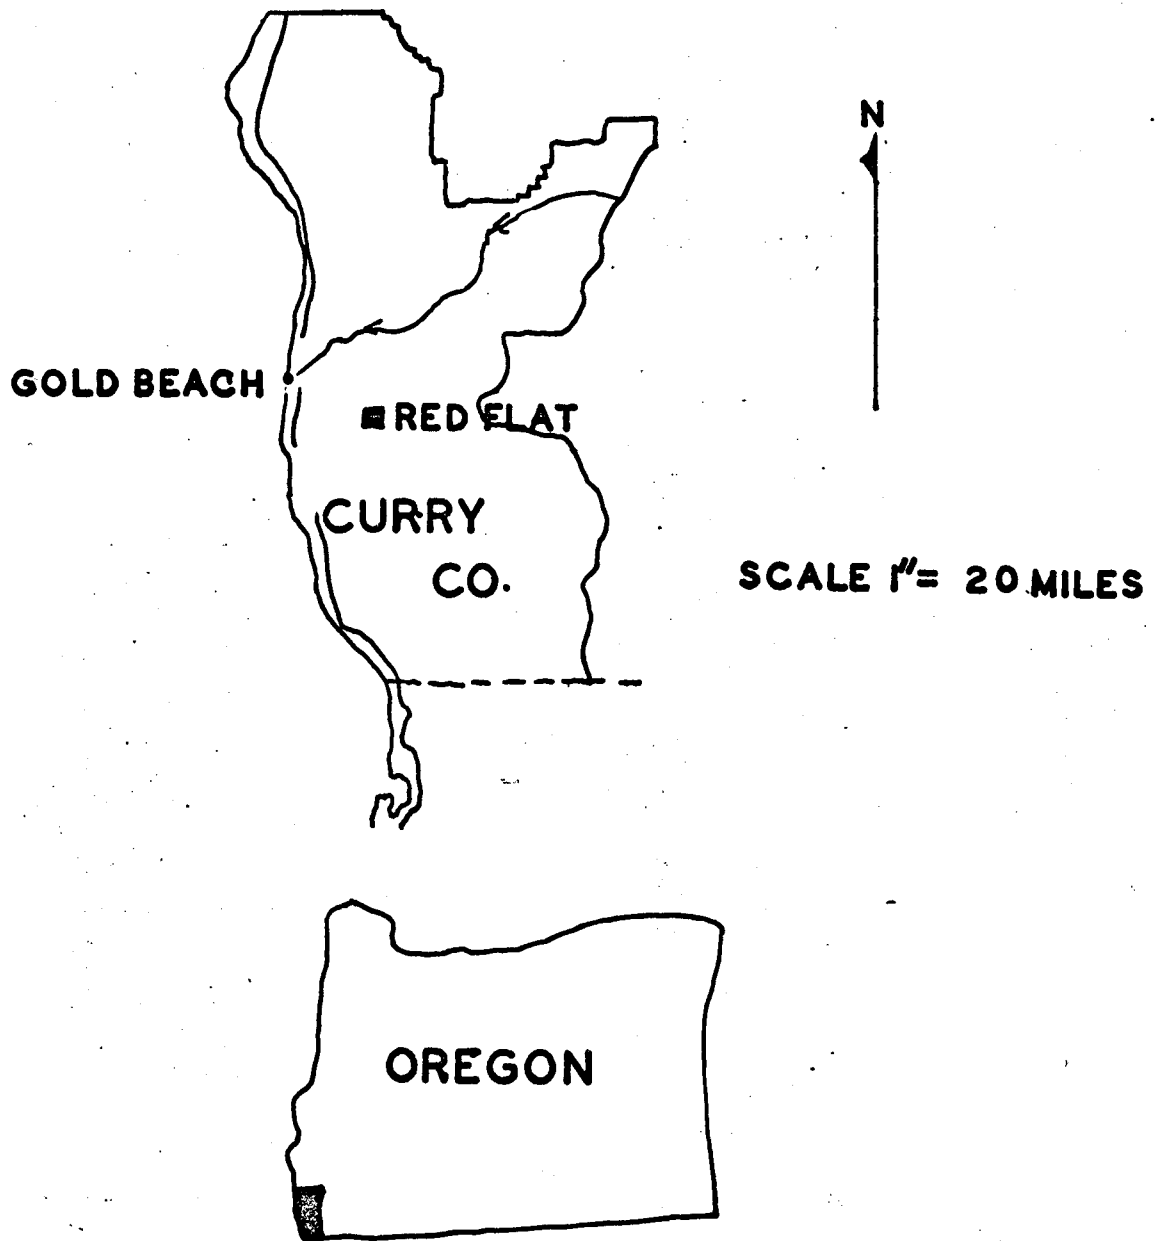

SKETCH MAP

RED FLAT AREA

Curry County, Oregon

Secs. 19,30 T.37 S. R.13 W.


Elevations Shown Obtained
From Altimeter Readings

Hole No. 1 Elev. 2380'

Pyramid Rock



SCALE

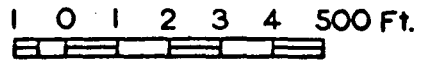

Hole No. 2 Elev. 2360'

14 Mile Post

U.S.F.S. Road

Dead End Road

Hole No. 3 Elev. 2265'

14 mi. To Pistol River PO

Spring Camp

Sawmill

Hole No. 4 Elev. 2175'

To Chappen Property

PACIFIC OCEAN

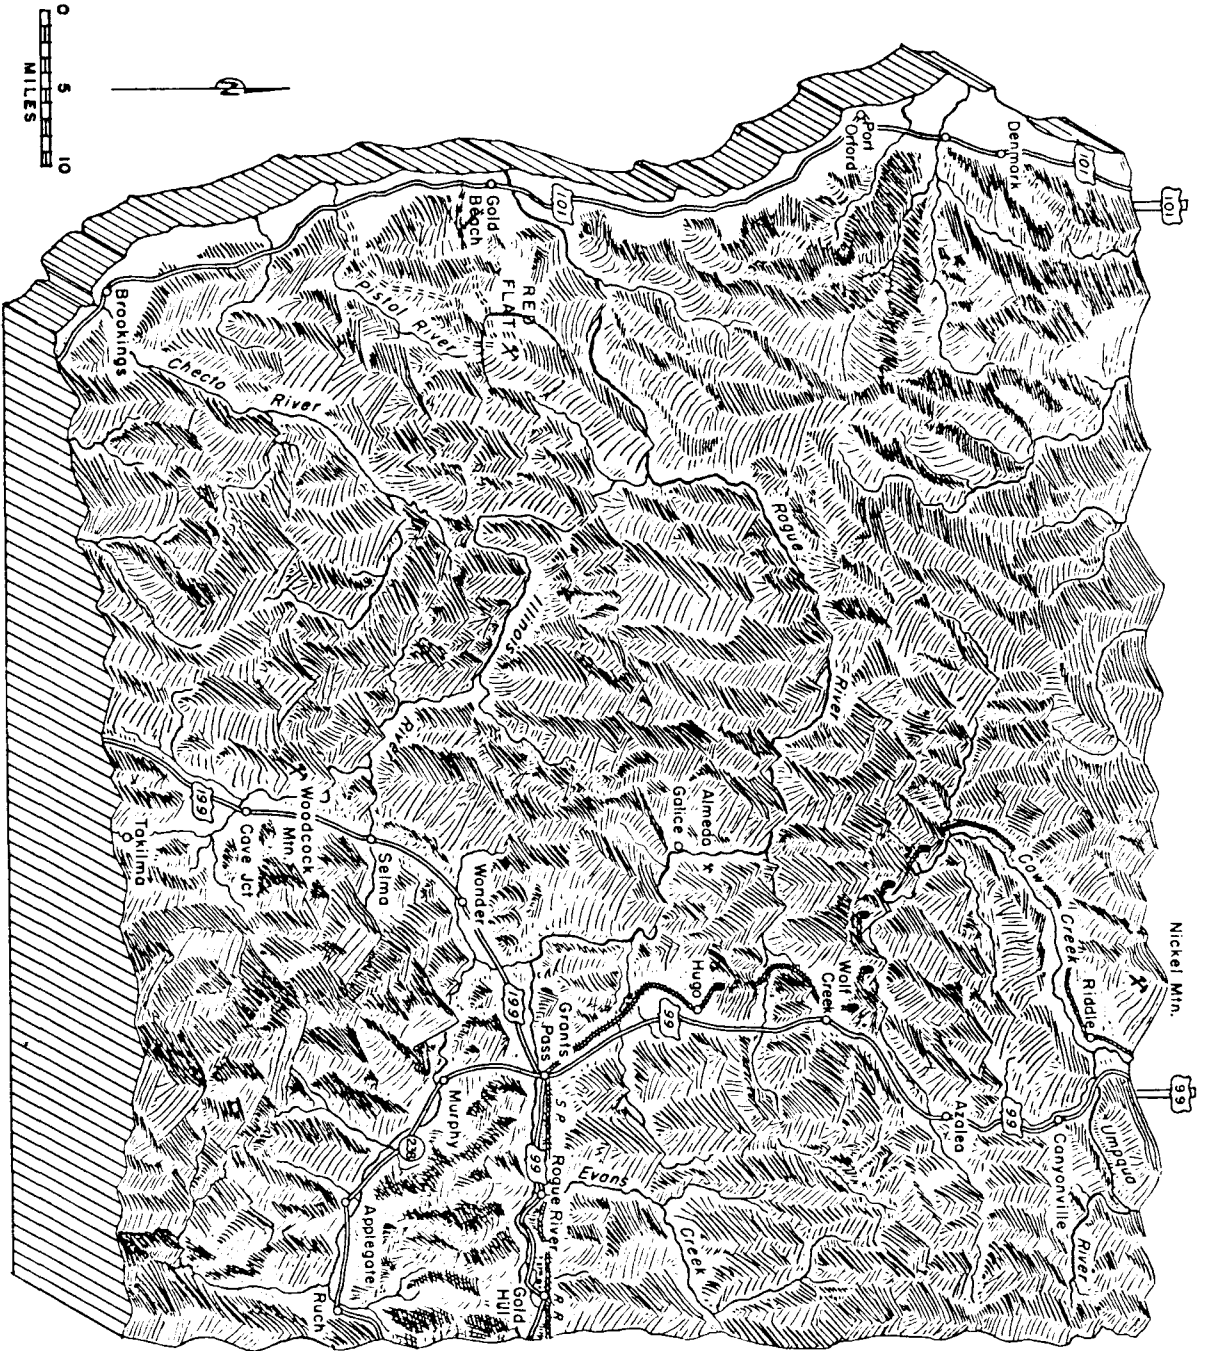


Figure 1. - Relief map of southwestern Oregon showing Red Flats nickel deposit.

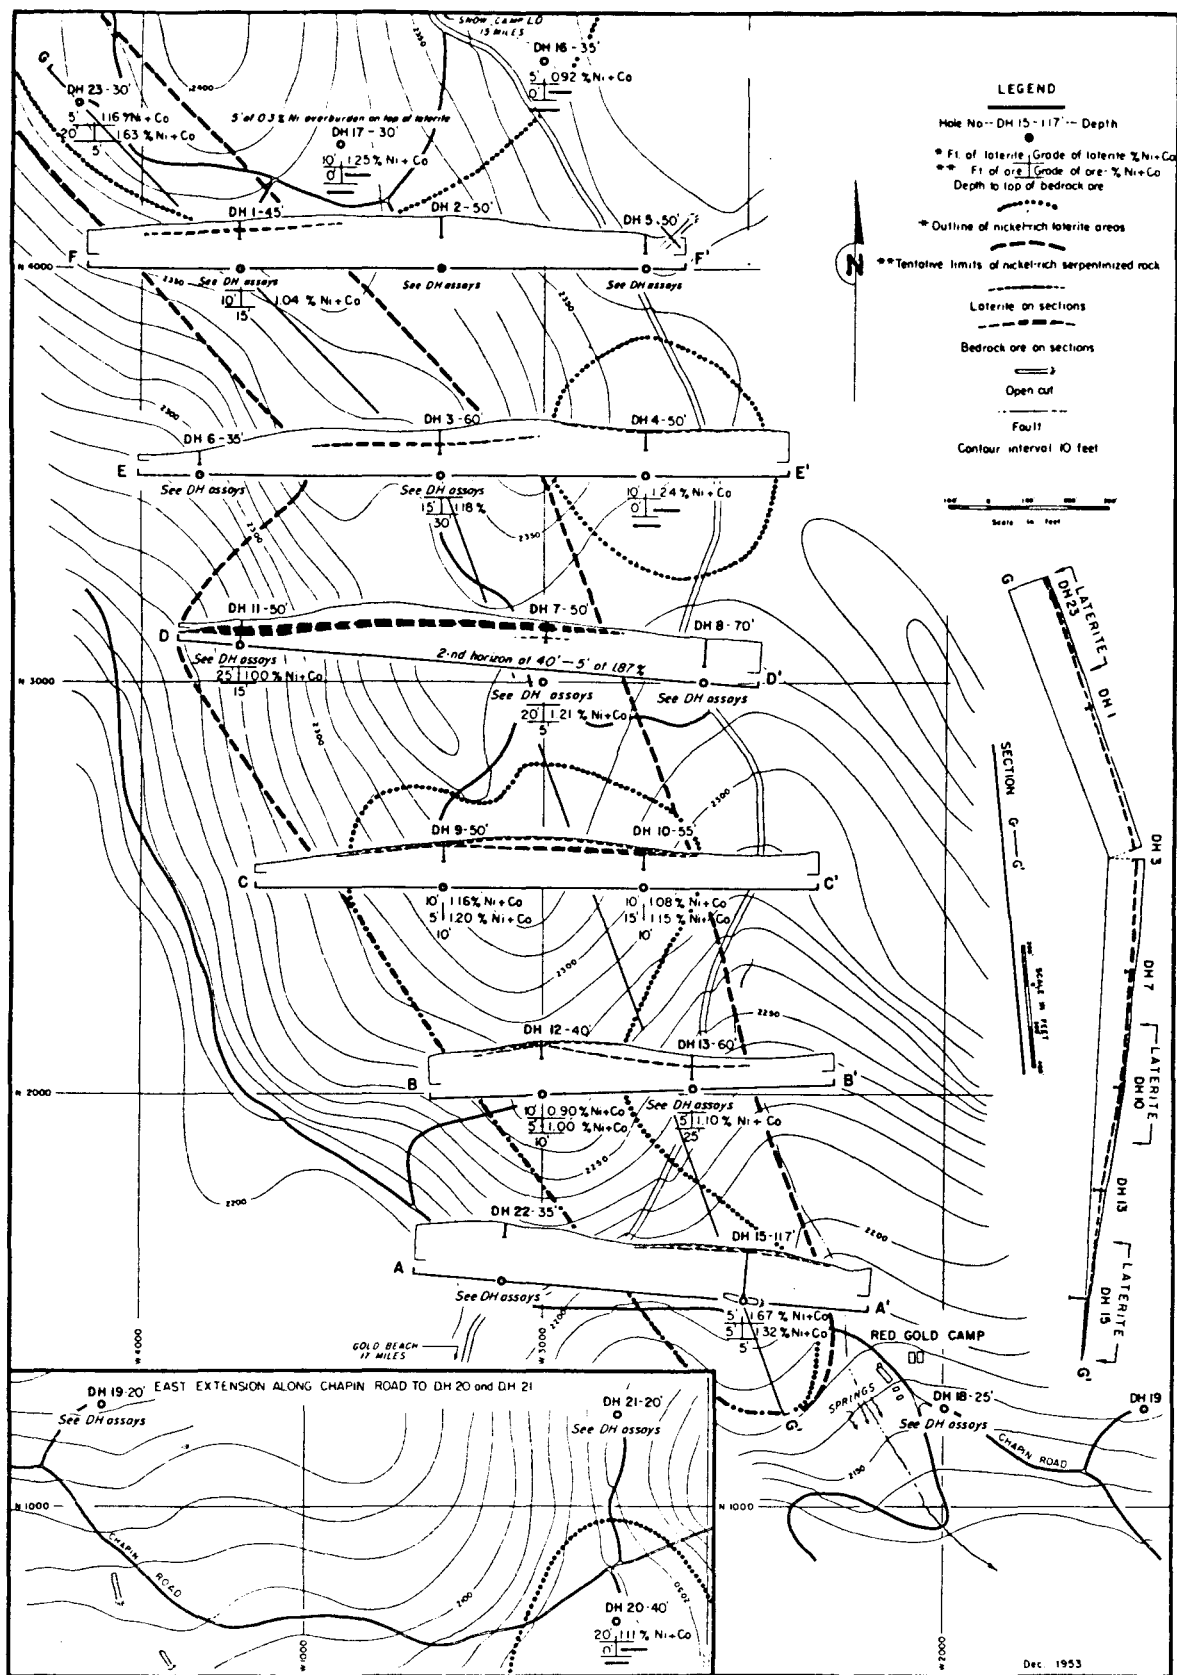


Figure 2. - Red Flats nickel deposit, Curry County, Oreg.

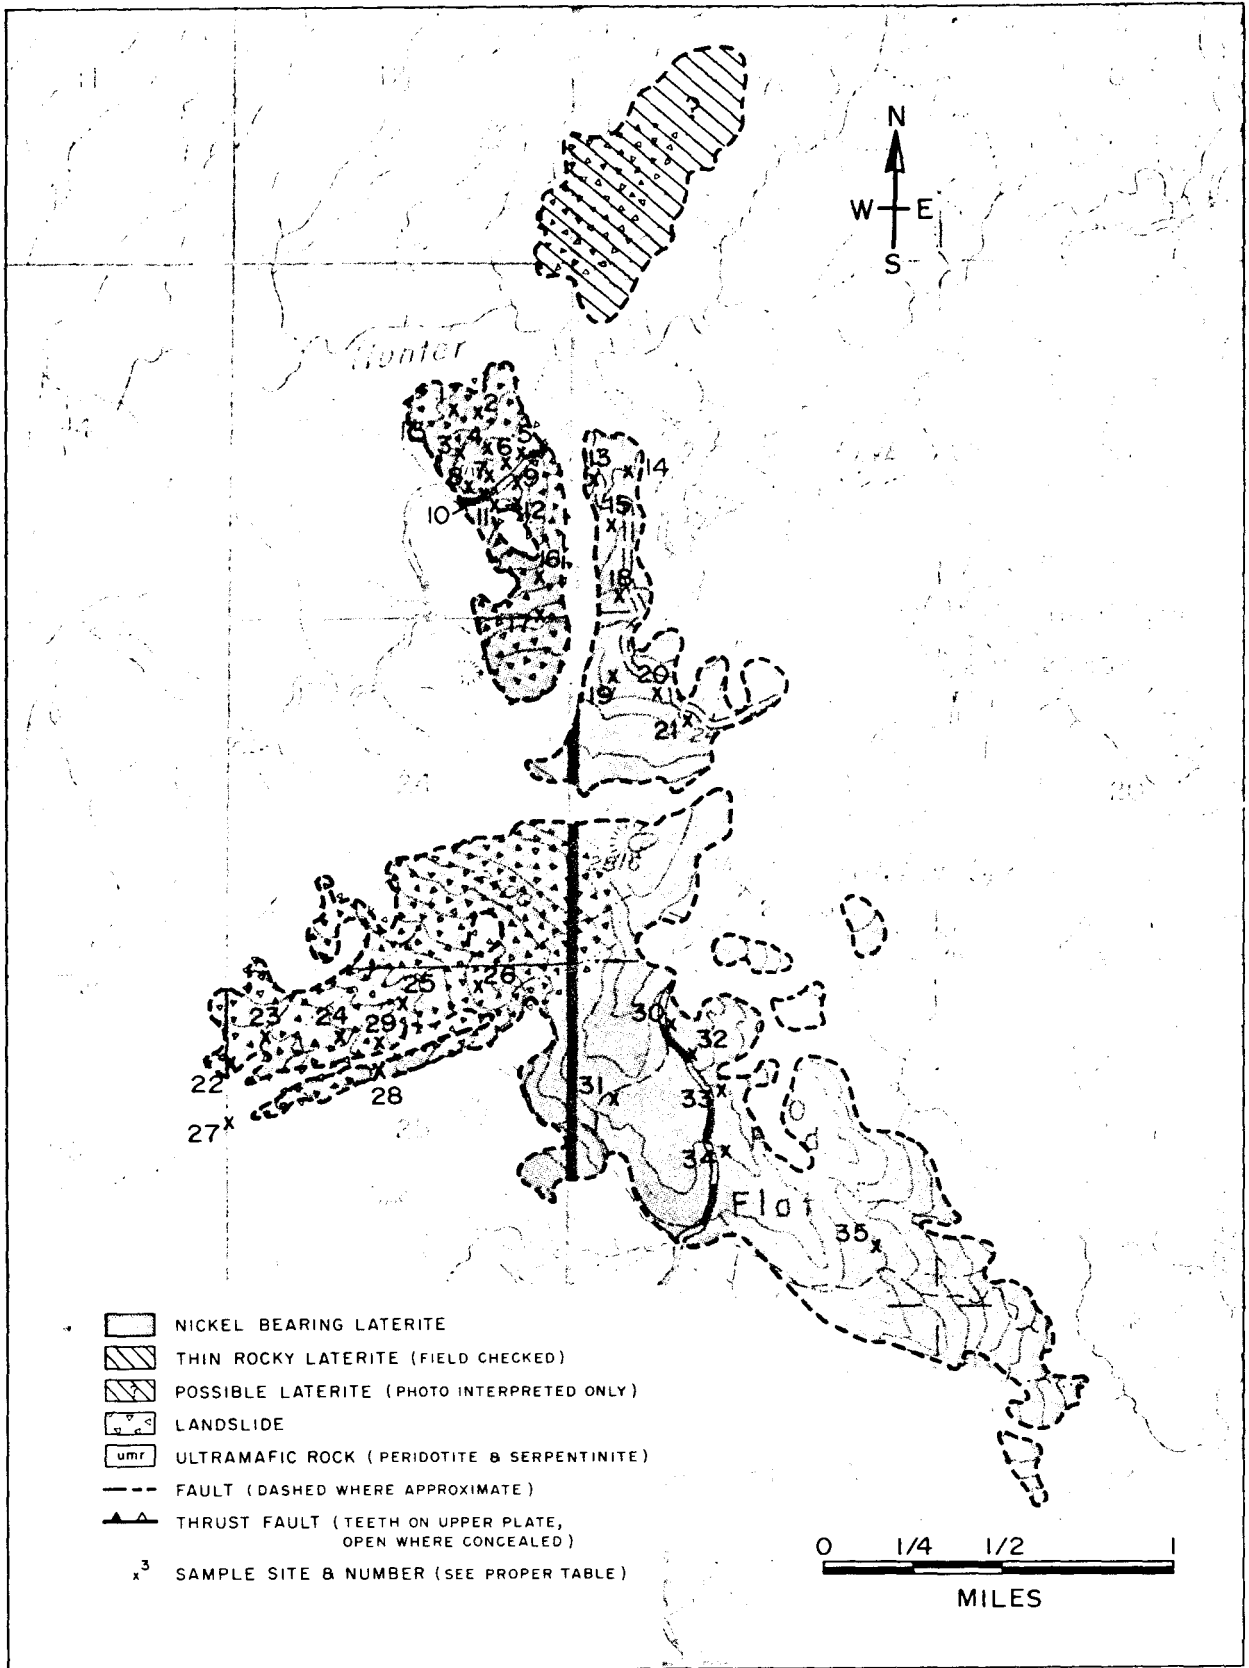


Figure 5. Geologic map of Red Flat and vicinity. Sample assay results appear in Table 5.

STATE OF OREGON

SKETCH MAP

RED FLAT AREA

Curry County, Oregon


Secs. 19, 30 T. 37 S. R. 13 W.

Elevations Shown Obtained
From Altimeter Readings

To ↑
Pyramid Rock
Hole No. 1 Elev. 2380'




SCALE

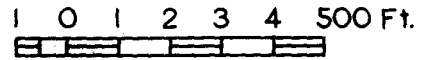

Hole No. 2 Elev. 2360'

14 Mile Post

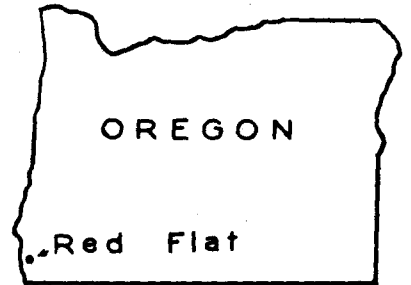

End Road

U.S.F.S. Road

Hole No. 3 Elev. 2265'

14mi. To Pistol River P.O.
To Pistol River →

Spring ○ Camp □

Sawmill □ Hole No. 4 Elev. 2175'


To Chapin Property →

OWNSHIP 37 S. TOWNSHIP 37 S.
RANGE 14 W. W. M. RANGE 13 W. W. M.

LAND BIDS, PORTLAND, OREGON
CITY ST. TACOMA, WASHINGTON
BIRD AVE SEATTLE, WASHINGTON

SEATTLE, WASHINGTON
SEATTLE, WASHINGTON

JULY 1955

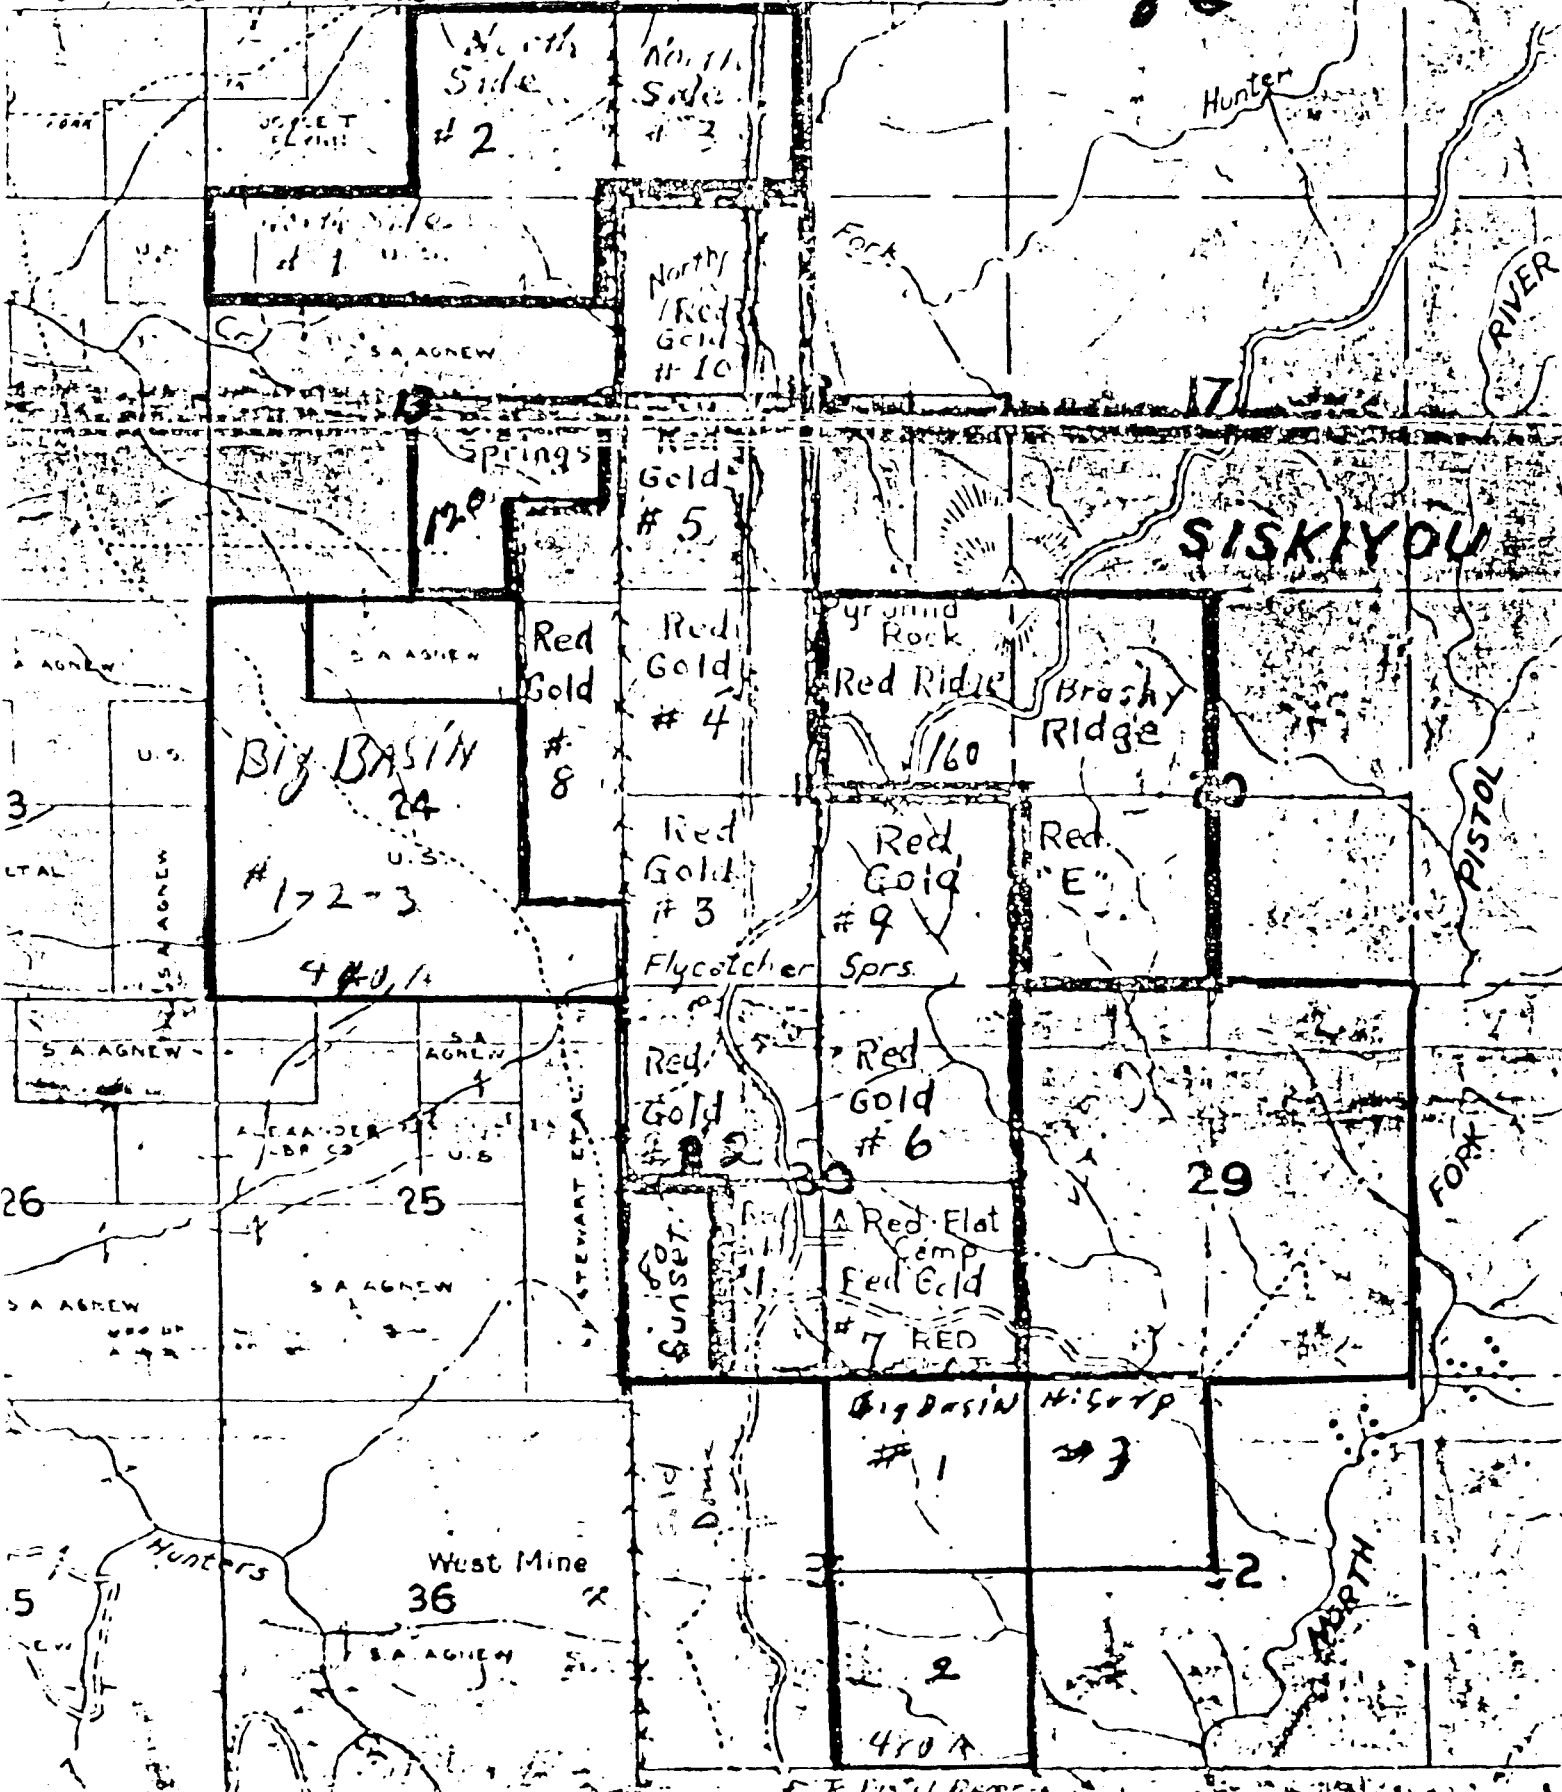



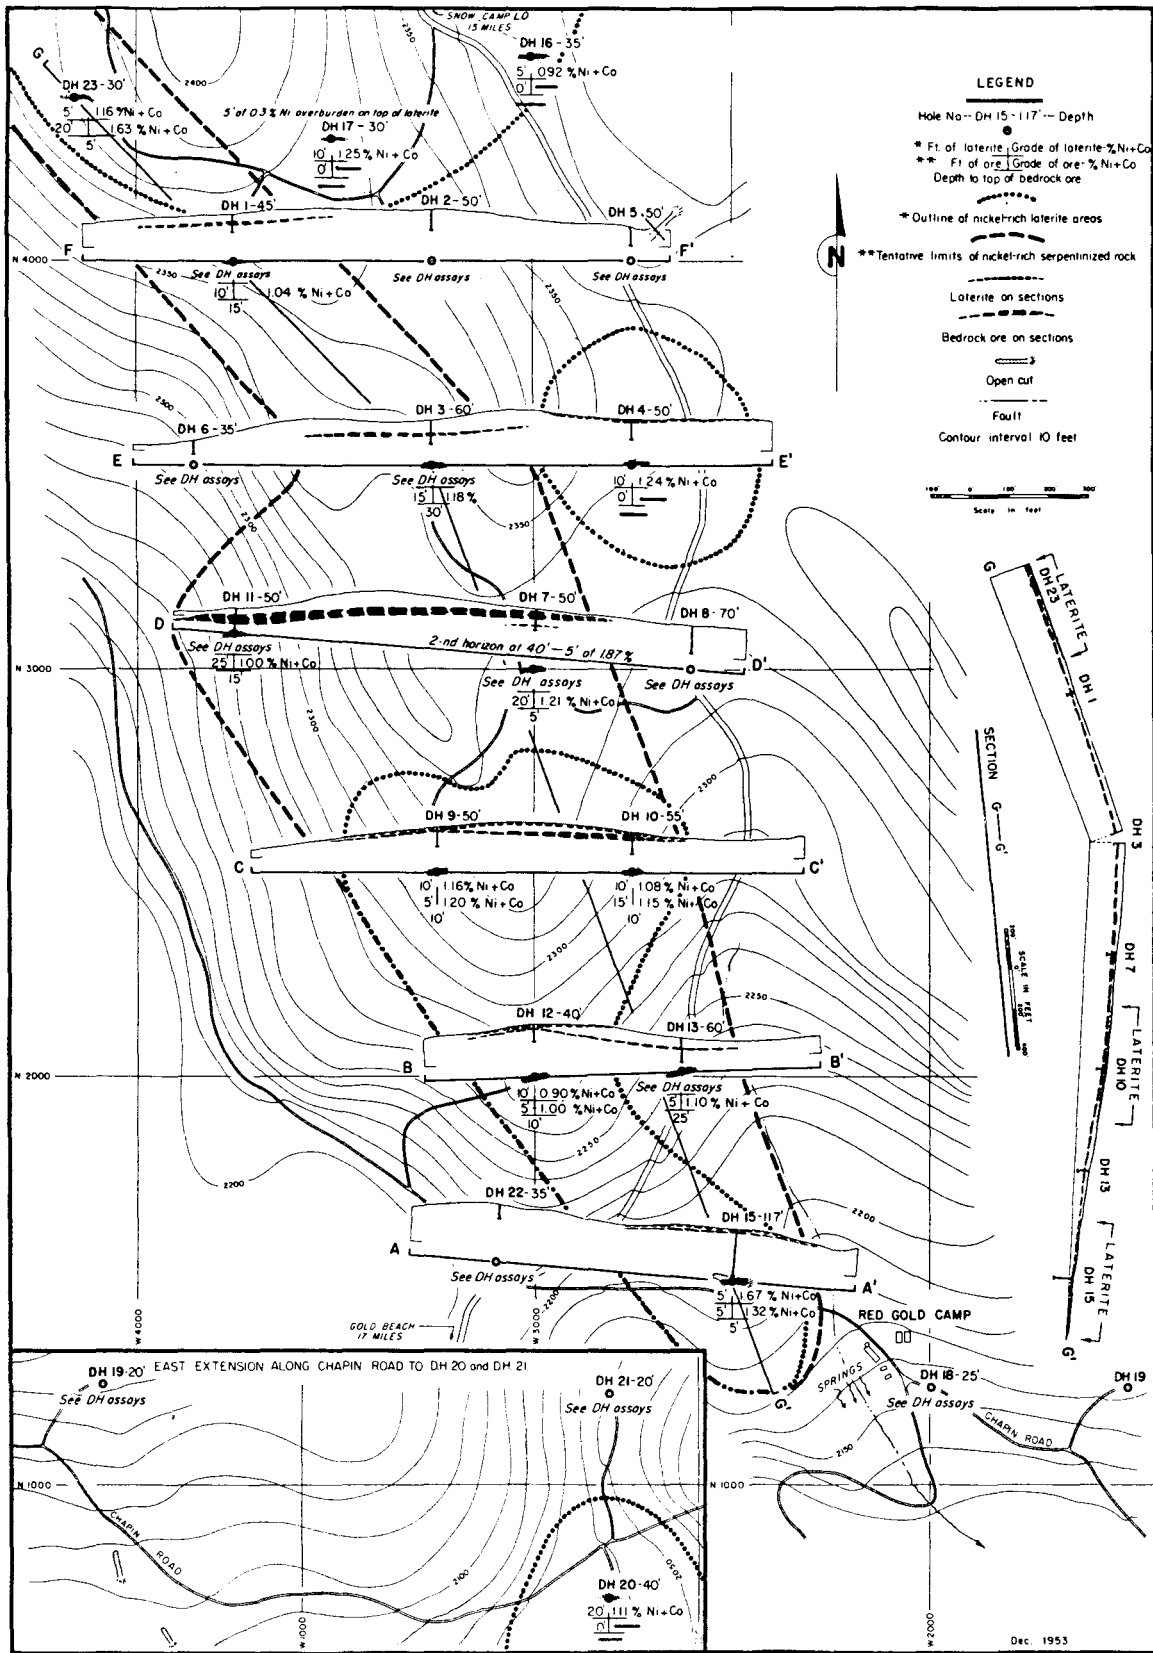



Figure 2. - Red Flats nickel deposit, Curry County, Oreg.

Placer claims as they were in 1932

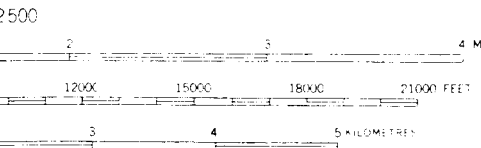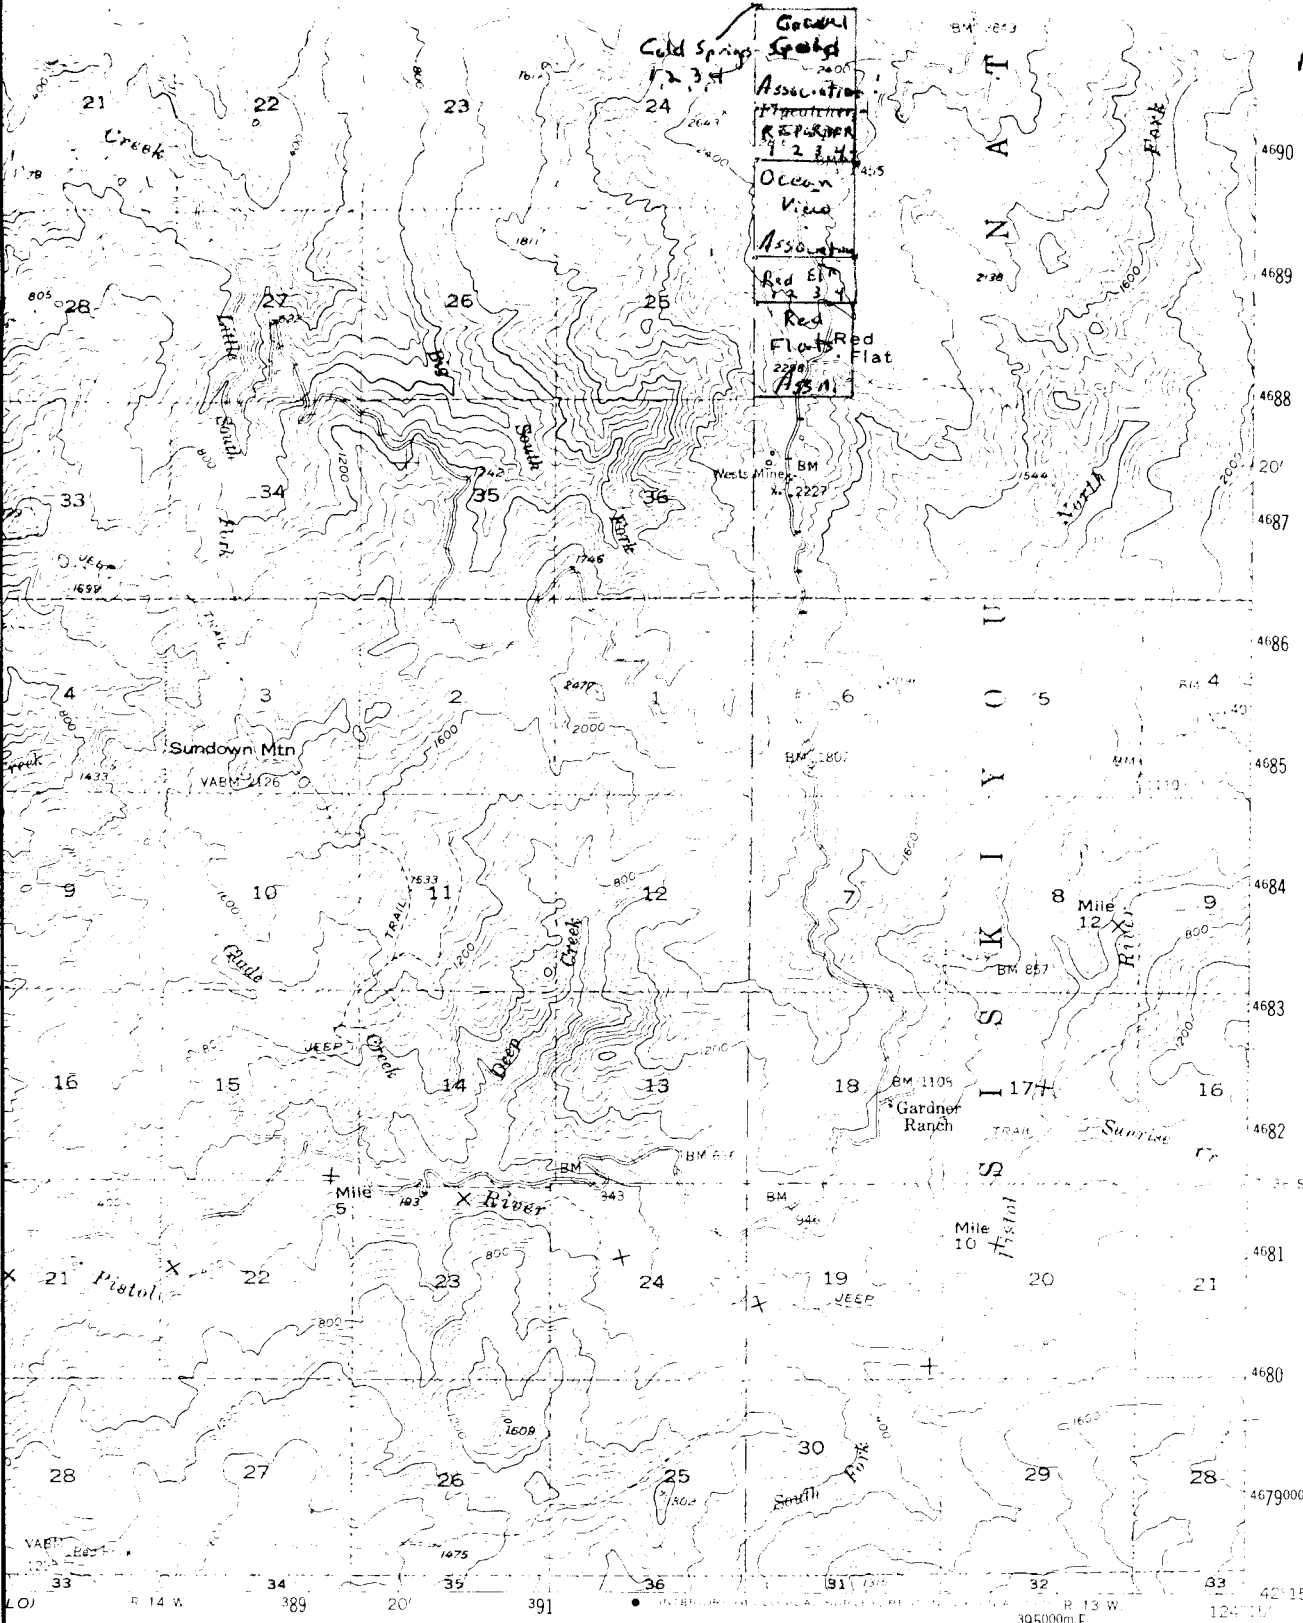

AL 50 FEET
AL DATUM OF 1929
MEAN LOWER LOW WATER
DATE LINE OF MEAN HIGH WATER
AREAS IN ITALIC 4 FEET

MAP ACCURACY STANDARDS
COLORADO 80229 OR RESTON VIRGINIA 22092
NO SYMBOLS IS AVAILABLE ON REQUEST

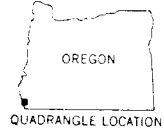

ROAD CLASSIFICATION


Medium-duty ——— Light-duty - - - - -
Unimproved dirt - - - - -
U.S. Route

GOLD BEACH, OREG.
N 4215 - W 12415/16
1954
AMS 1168 IV—SERIES V792


(M) 1:50,000 (1:100,000)

OREGON

SCALE OF MILES
0 10 20 30 50 75
ONE INCH EQUALS APPROXIMATELY 49 MILES

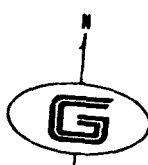

PACIFIC OCEAN

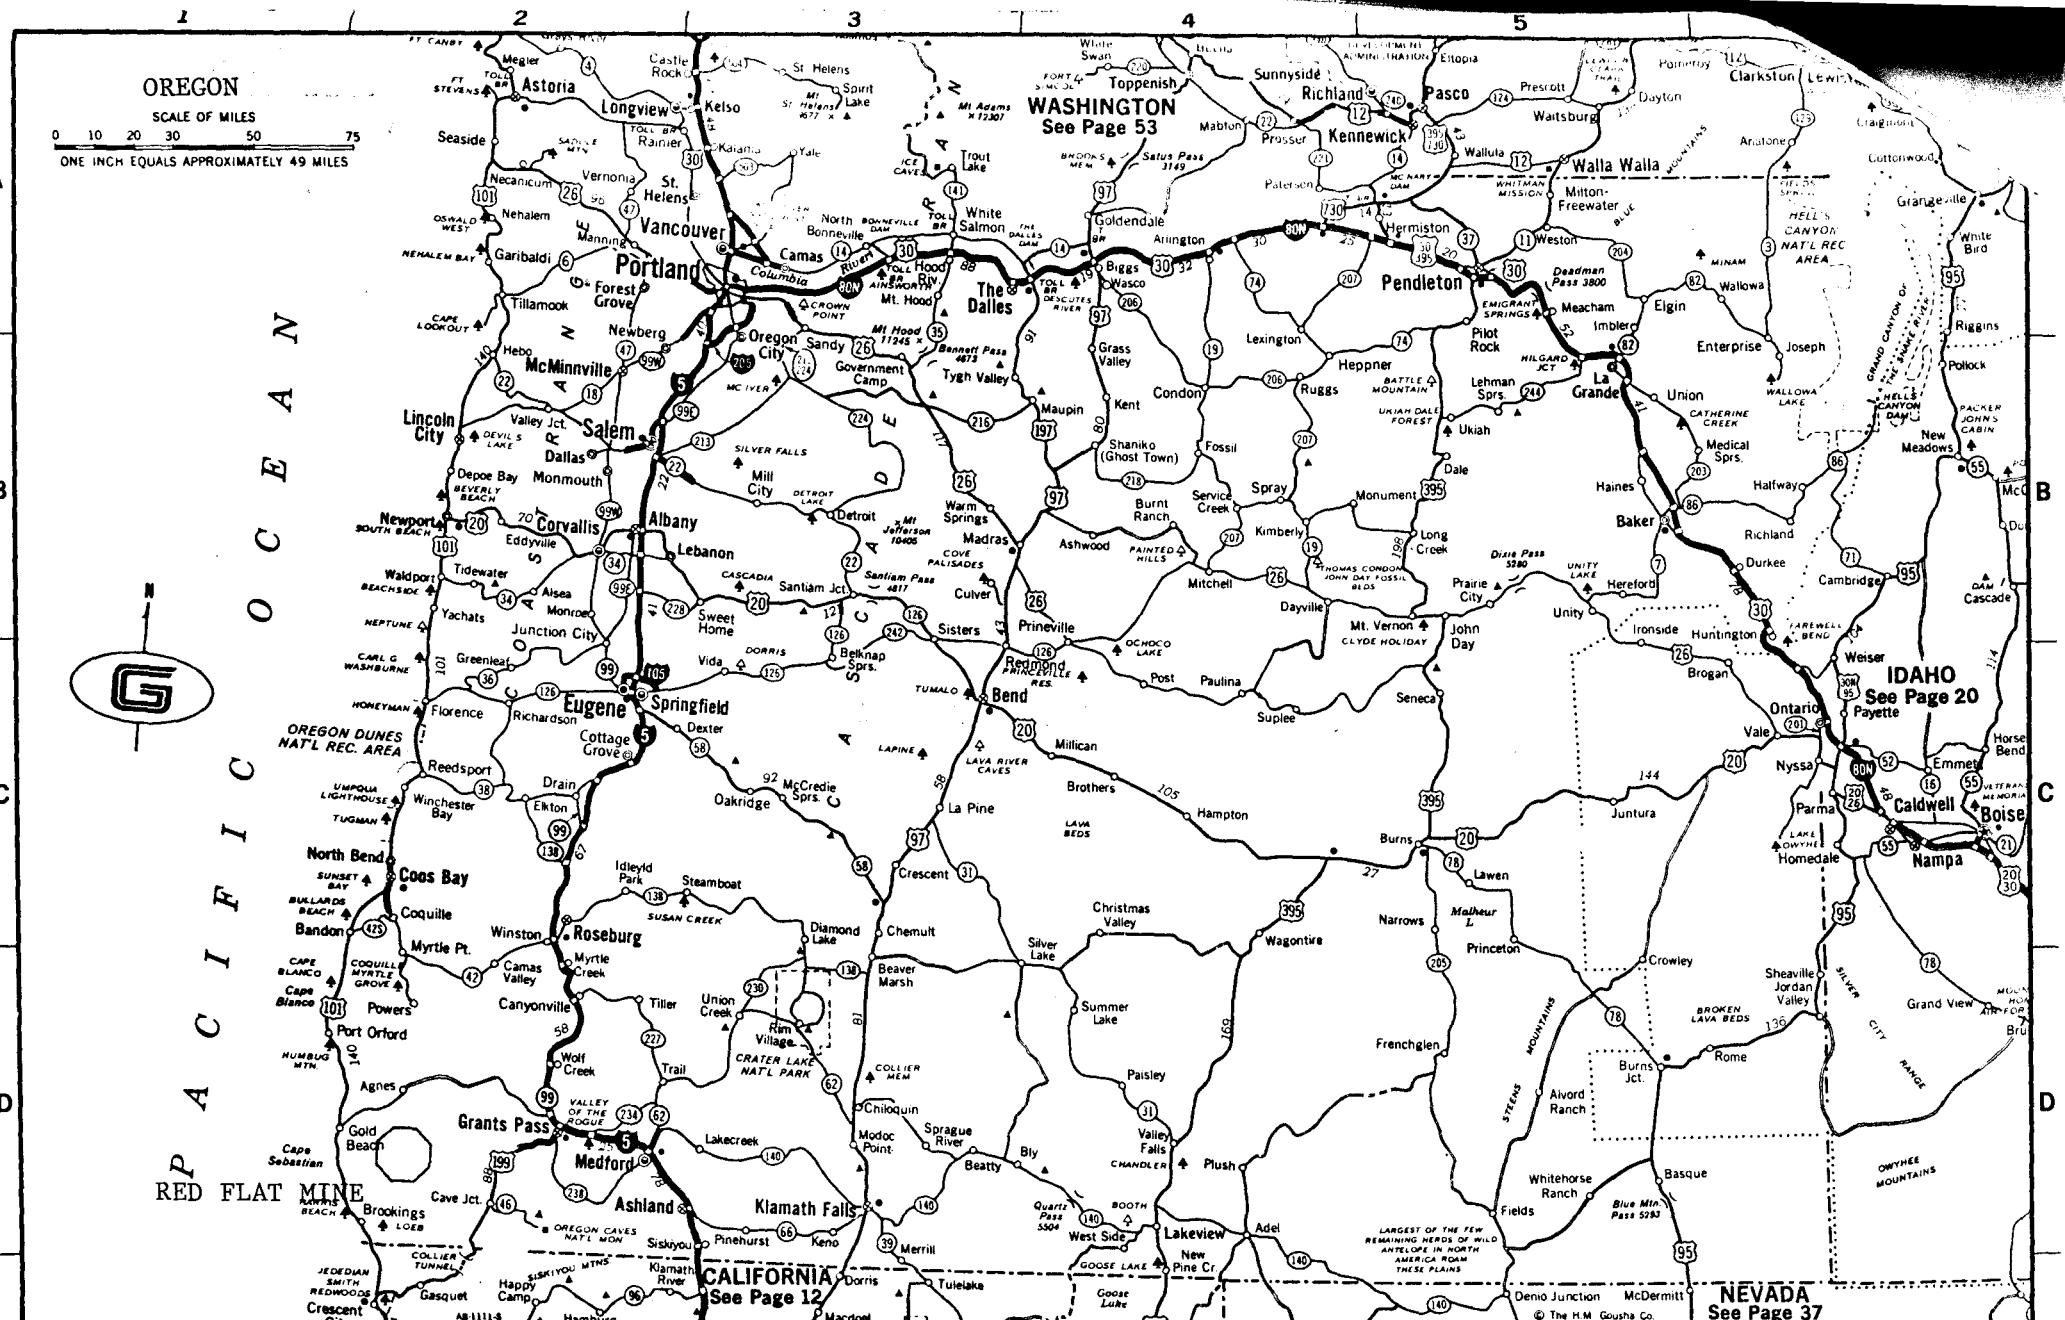

WASHINGTON
See Page 53

IDAHO
See Page 20


CALIFORNIA
See Page 12

NEVADA
See Page 37

PARTIAL INDEX TO
CITIES AND TOWNS
WITH CENSUS FIGURES
State Population 2,091,385

Albany 18,181	A-2	Bandon 1,832	D-1	Brookings 2,720	D-2	Crescent	C-3	Dallas	C-5	Canyonville 940	D-2	Chiloquin 826	D-3	Condon 973	B-4	Coos Bay 13,466	D-3	Corvallis 35,153	B-2	Biggs 4,444	A-4	Cottage Grove	C-2	Florence 2,246	C-2	Forest Grove 8,275	A-2	Garibaldi 1,083	A-2	Gold Beach 1,584	D-1	Government Camp	B-3	Juneau 56	C-5	Kimberly	B-4	Klamath Falls 153	B-4	Greenleaf	C-2	Haines 212	B-5	Hebo	B-2	Heppner 1,661	B-4	Hermiston 4,893	A-5	Lebanon 5,636	B-2	Lexington 230	B-2	Lincoln City	B-2	Long Creek 196	B-5	Madras 1,689	B-3	Maupin 428	B-4	McMinnville 10,125	B-2	Medford 28,454	D-2	Merrill 722	E-2	Mill City 1,481	B-3	Milton-Freewater	A-5	4,105	A-5	Monmouth	B-2	5,237	B-2	Ontario 6,523	C-6	Oregon City 9,176	B-3	Pendleton 13,197	A-5	Pilot Rock 1,612	A-5	Portland 382,619	A-3	Necanicum	C-5	New Pine Creek	E-4	Newberg 6,507	B-4	Newport 5,188	B-2	Rainier 1,731	A-2	Redmond 3,721	C-3	Reedsport 4,099	C-2	Richland 133	B-6	Rim Village	D-3	Roseburg 14,461	C-2	Spray 161	B-4	Ruggs	B-4	Springfield 27,047	C-2	Salem 68,296	B-2	St. Helens 5,022	A-3	Sandy 1,544	A-3	Santiam Junction	B-3	Seaside 4,402	A-2	Seneca	C-5	Shaniko 58	B-4	Sheaville	D-6	Silver Lake	D-3	Siskiyou	D-3	Sisters 516	B-3	Sweet Home 3,799	B-3	Tillamook 3,968	A-2	Trail	D-2	Tygh Valley	B-3	Ukiah	B-5	Union 1,331	B-5	Unity	B-5	Vale 1,448	C-6	Valley Falls	D-4	Valley Junction	B-2	Vernonia 1,643	A-2	Waldport 700	B-2	Walla Walla 811	A-6	Wasco 412	A-4	Weston 660	A-5	Winchester	B-3	Winston 2,468	C-2
---------------	-----	--------------	-----	-----------------	-----	----------	-----	--------	-----	-----------------	-----	---------------	-----	------------	-----	-----------------	-----	------------------	-----	-------------	-----	---------------	-----	----------------	-----	--------------------	-----	-----------------	-----	------------------	-----	-----------------	-----	-----------	-----	----------	-----	-------------------	-----	-----------	-----	------------	-----	------	-----	---------------	-----	-----------------	-----	---------------	-----	---------------	-----	--------------	-----	----------------	-----	--------------	-----	------------	-----	--------------------	-----	----------------	-----	-------------	-----	-----------------	-----	------------------	-----	-------	-----	----------	-----	-------	-----	---------------	-----	-------------------	-----	------------------	-----	------------------	-----	------------------	-----	-----------	-----	----------------	-----	---------------	-----	---------------	-----	---------------	-----	---------------	-----	-----------------	-----	--------------	-----	-------------	-----	-----------------	-----	-----------	-----	-------	-----	--------------------	-----	--------------	-----	------------------	-----	-------------	-----	------------------	-----	---------------	-----	--------	-----	------------	-----	-----------	-----	-------------	-----	----------	-----	-------------	-----	------------------	-----	-----------------	-----	-------	-----	-------------	-----	-------	-----	-------------	-----	-------	-----	------------	-----	--------------	-----	-----------------	-----	----------------	-----	--------------	-----	-----------------	-----	-----------	-----	------------	-----	------------	-----	---------------	-----

Sunshine Mining Co.		
PROPERTY LOCATION MAP		
Red Flat Nickel Corporation		
Hanna Mining Company		
Gold Dome Natural Resources		
12/19/83	1"=1 mile	GWS

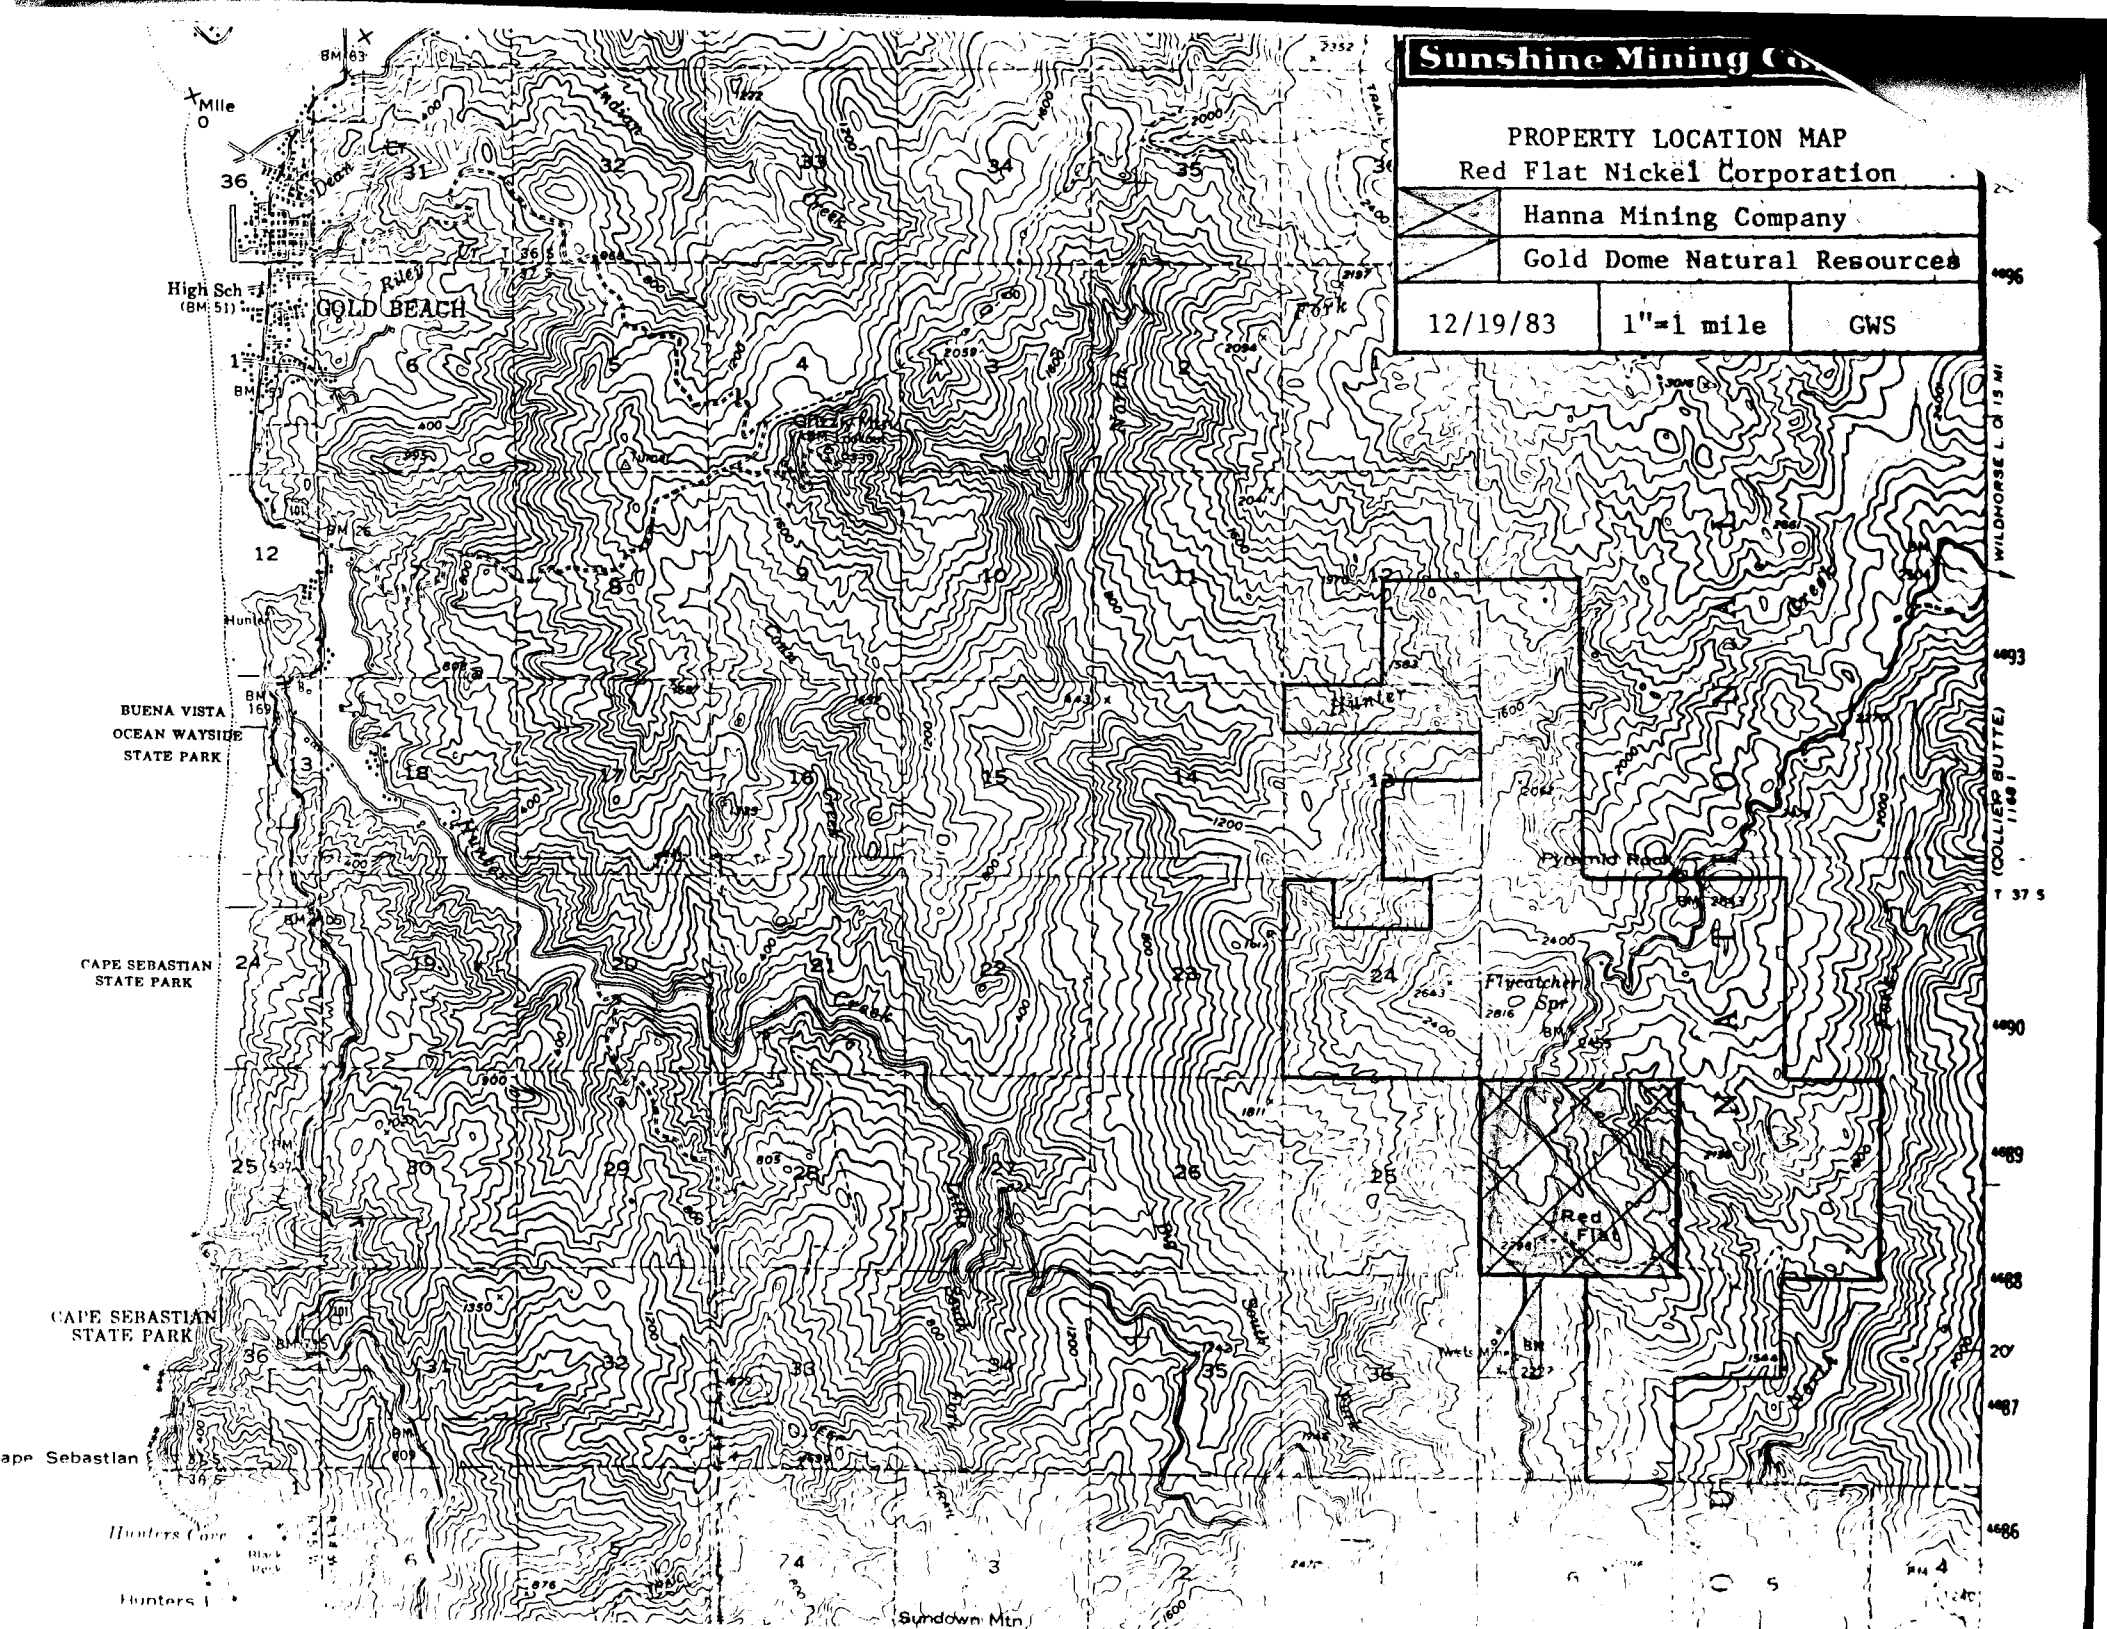

4896
4893
4890
4889
4888
207
4887
4886

WILDHORSE L. 3 15 MI
COLLIER BUTTE 1 16 MI
T 37 S


Cape Sebastian

Hunters Cove
Black Deck
Hunters I

Sundown Mtn




C I P I C
 O - C E A N
 P A C I

Sunshine Mining Company		
GEOLOGY		
Red Flat Nickel Corporation		
	Ultramafic Rocks Property	
12/20/83	1"=2 miles	GWS

SAMPLE LOCATION MAP
Red Flat Area

91°	Sample Number
12/20/83	1"=1 mile
	GWS

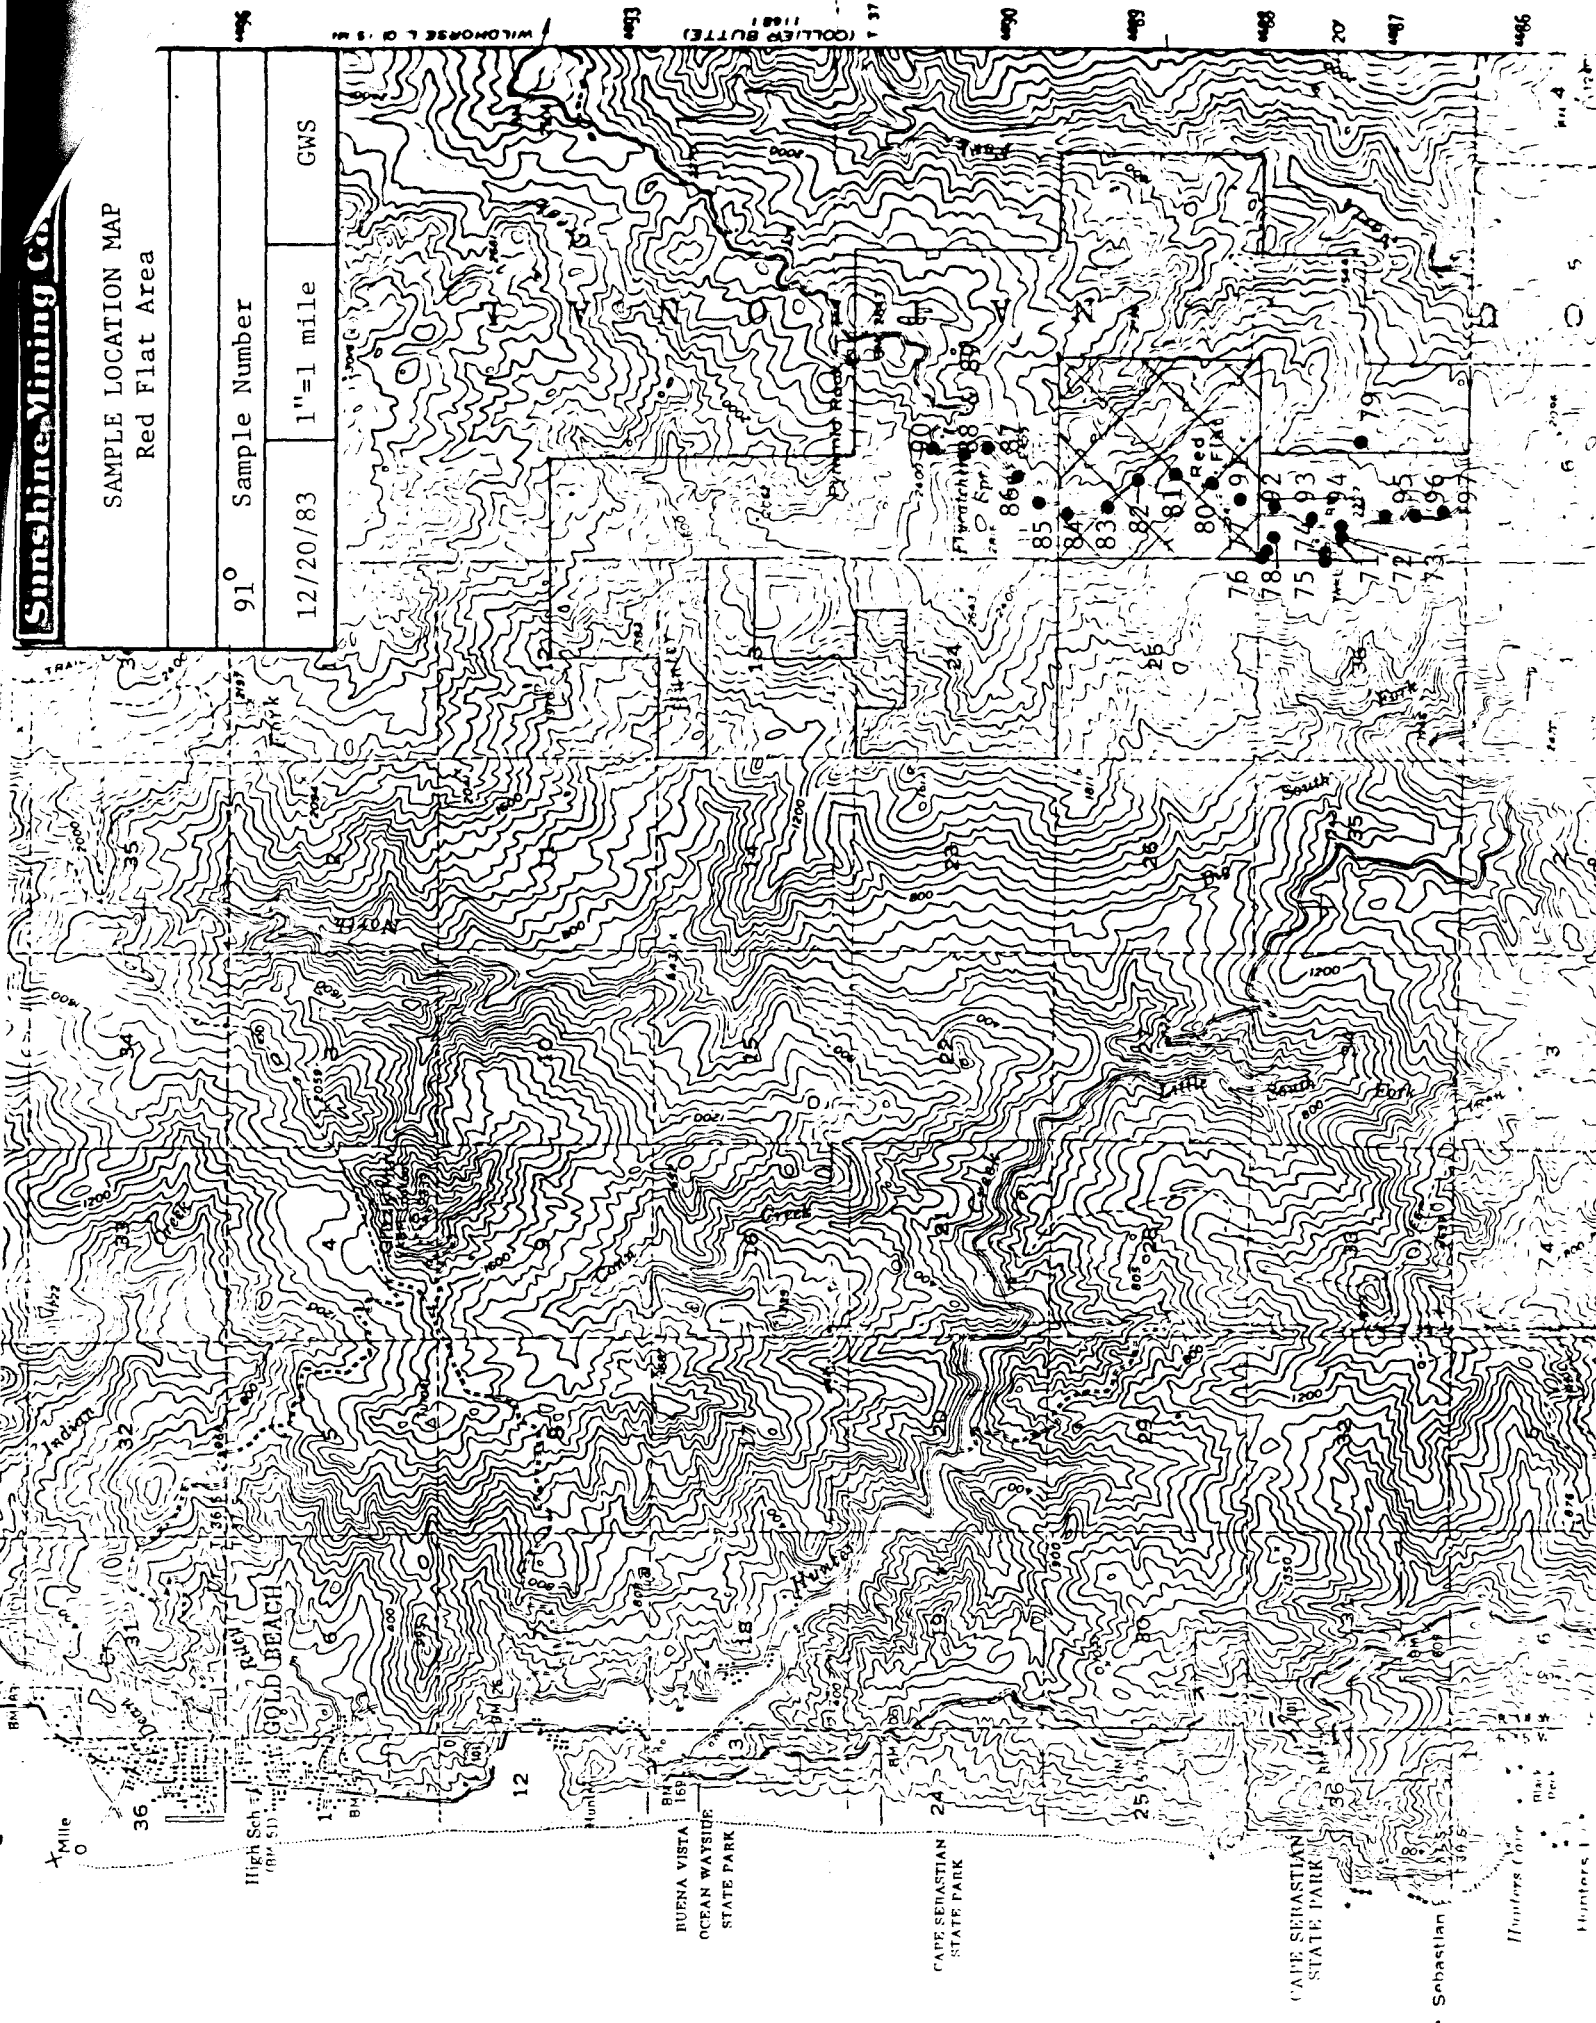

WILMORSE L. O. S. M.
COLLIER BUTTE
11881
489
488
487
486

1/4 Mile
0

High Sch. 7
GOLD BEACH

BUENA VISTA
OCEAN WAYSIDE
STATE PARK

CAPE SEBASTIAN
STATE PARK

CAPE SEBASTIAN
STATE PARK

Hunters Cove
Hunters I.

Sundown Min.


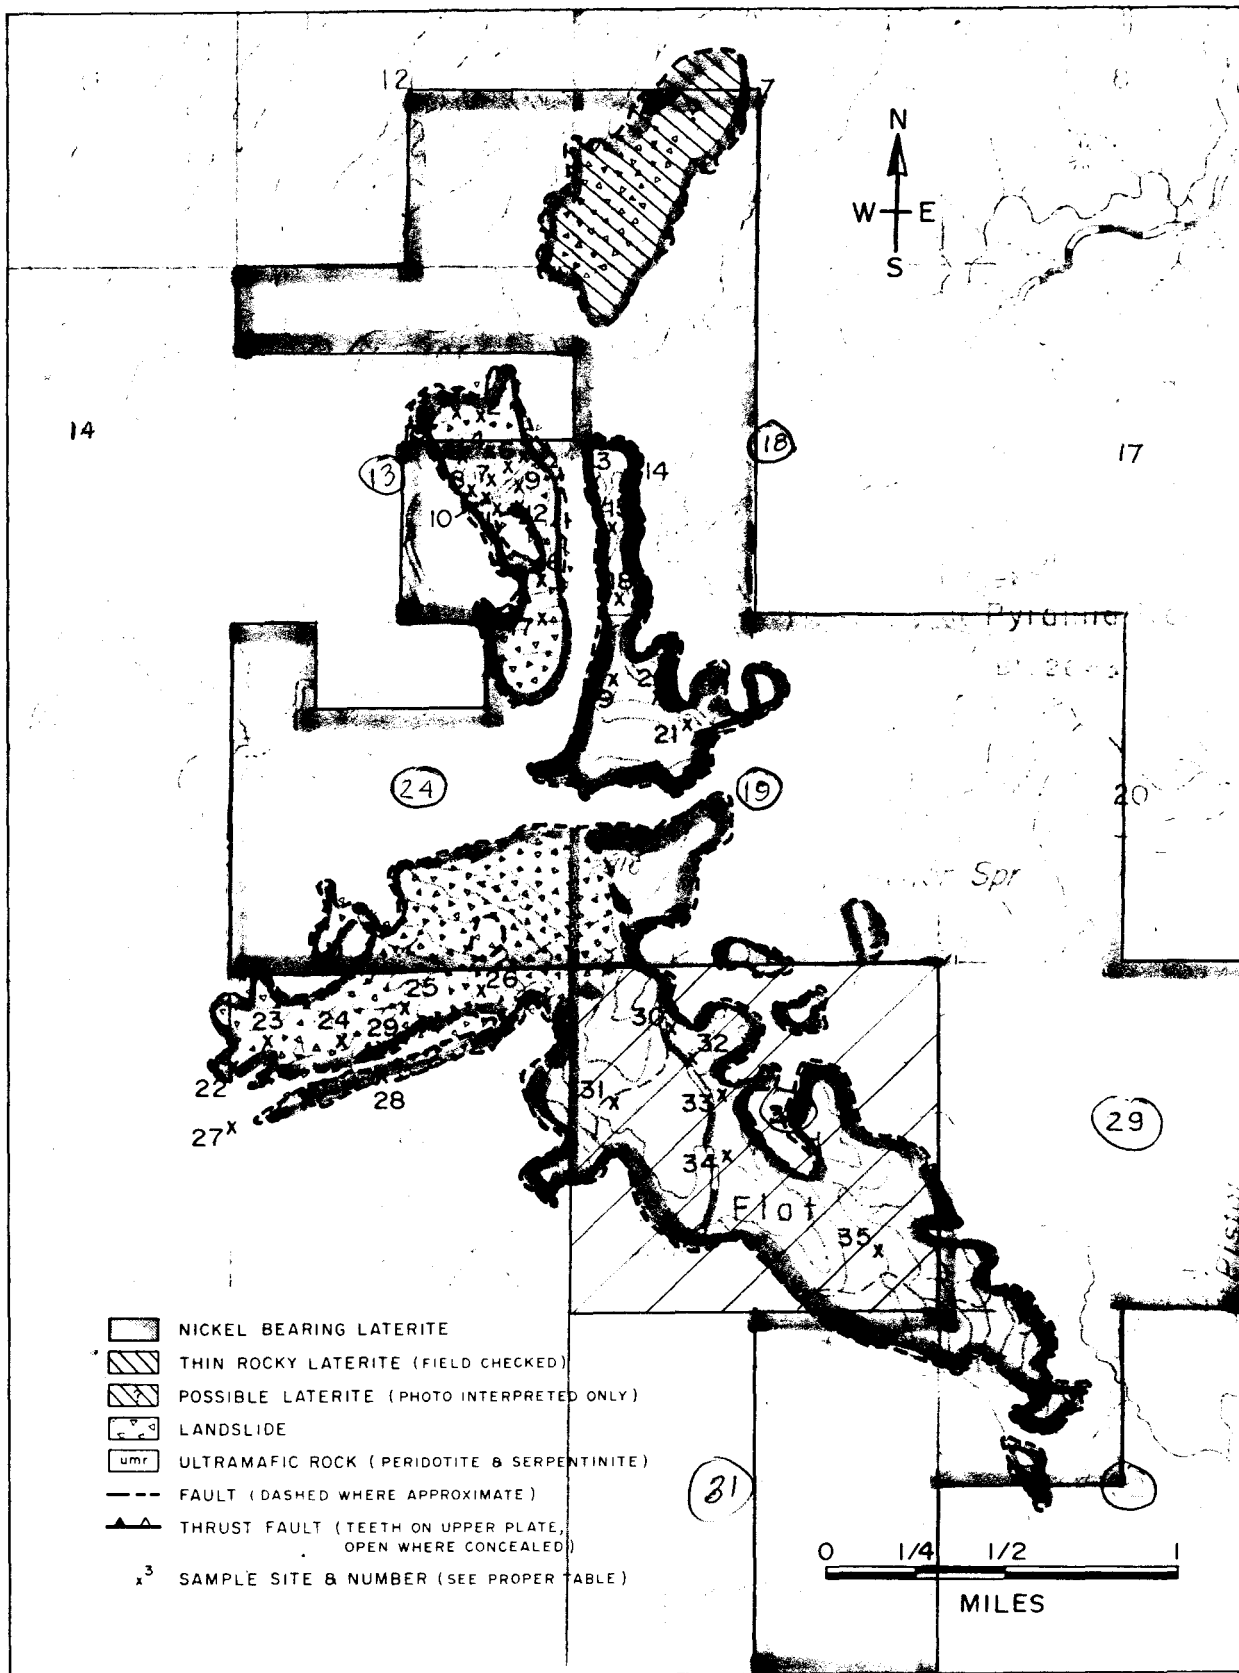


Figure 5. Geologic map of Red Flat and vicinity. Sample assay results appear in Table 5.

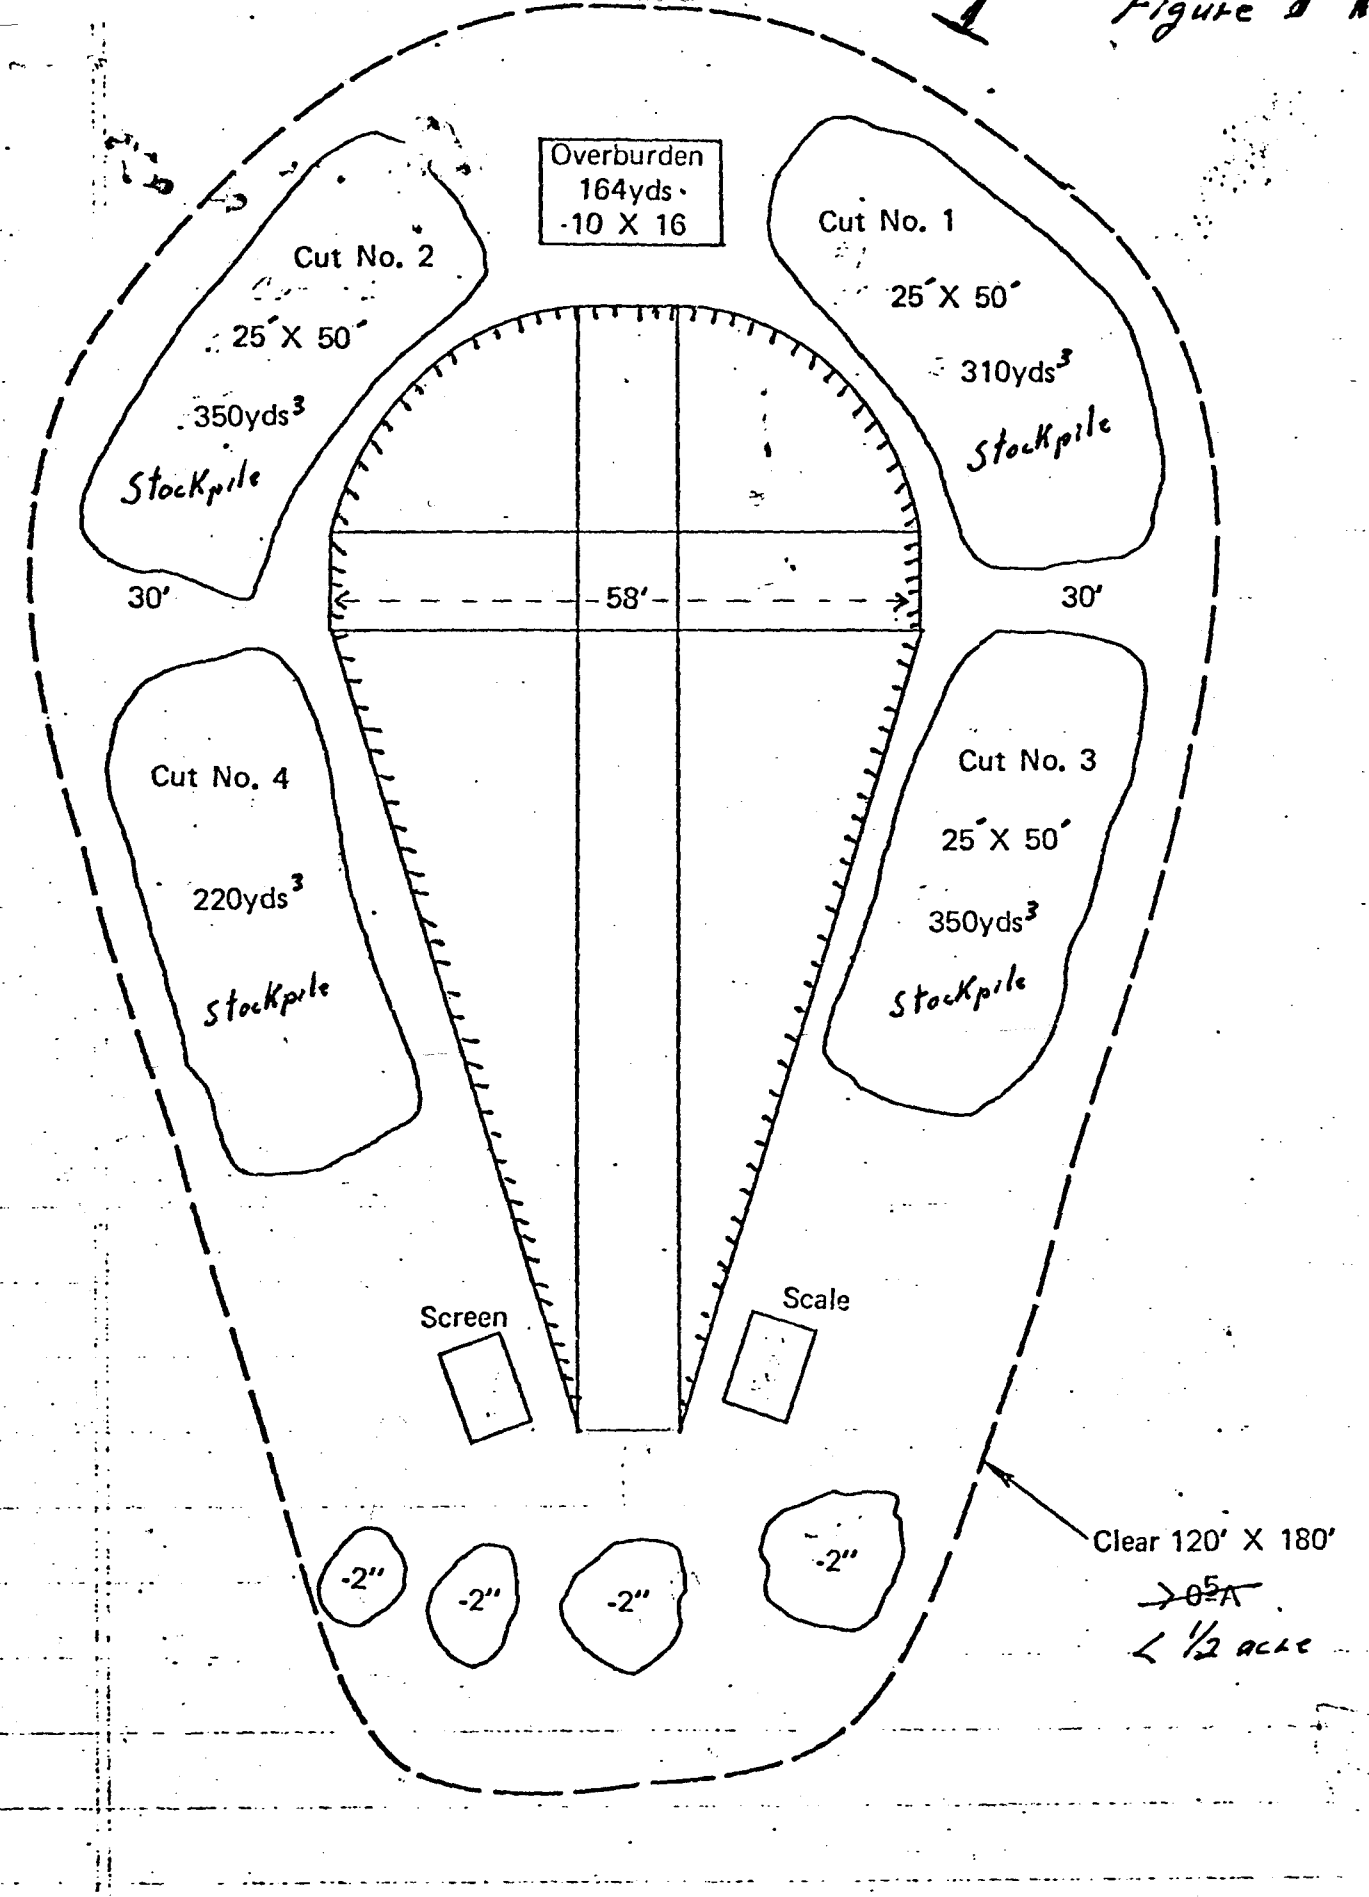

Clear 120' X 180'

→ 05A
← 1/2 acre

Scale 1"=20'-0"


#

Traverse From Camp to Bulldozer Cut farthest East


#

Aug. 16, 1947 - Libbey, distances; Mason - Bearings

Dis. Corrected

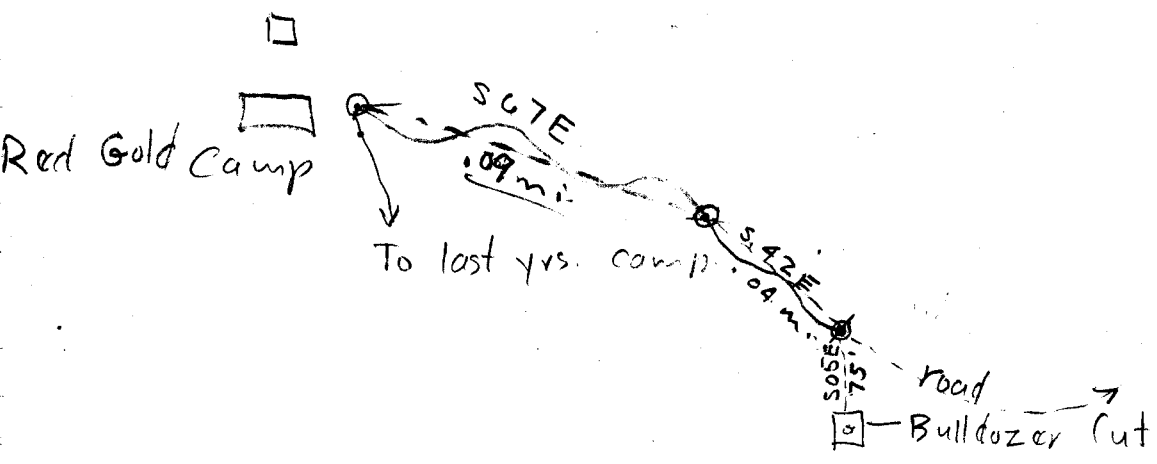

Aug 17
EXT 114

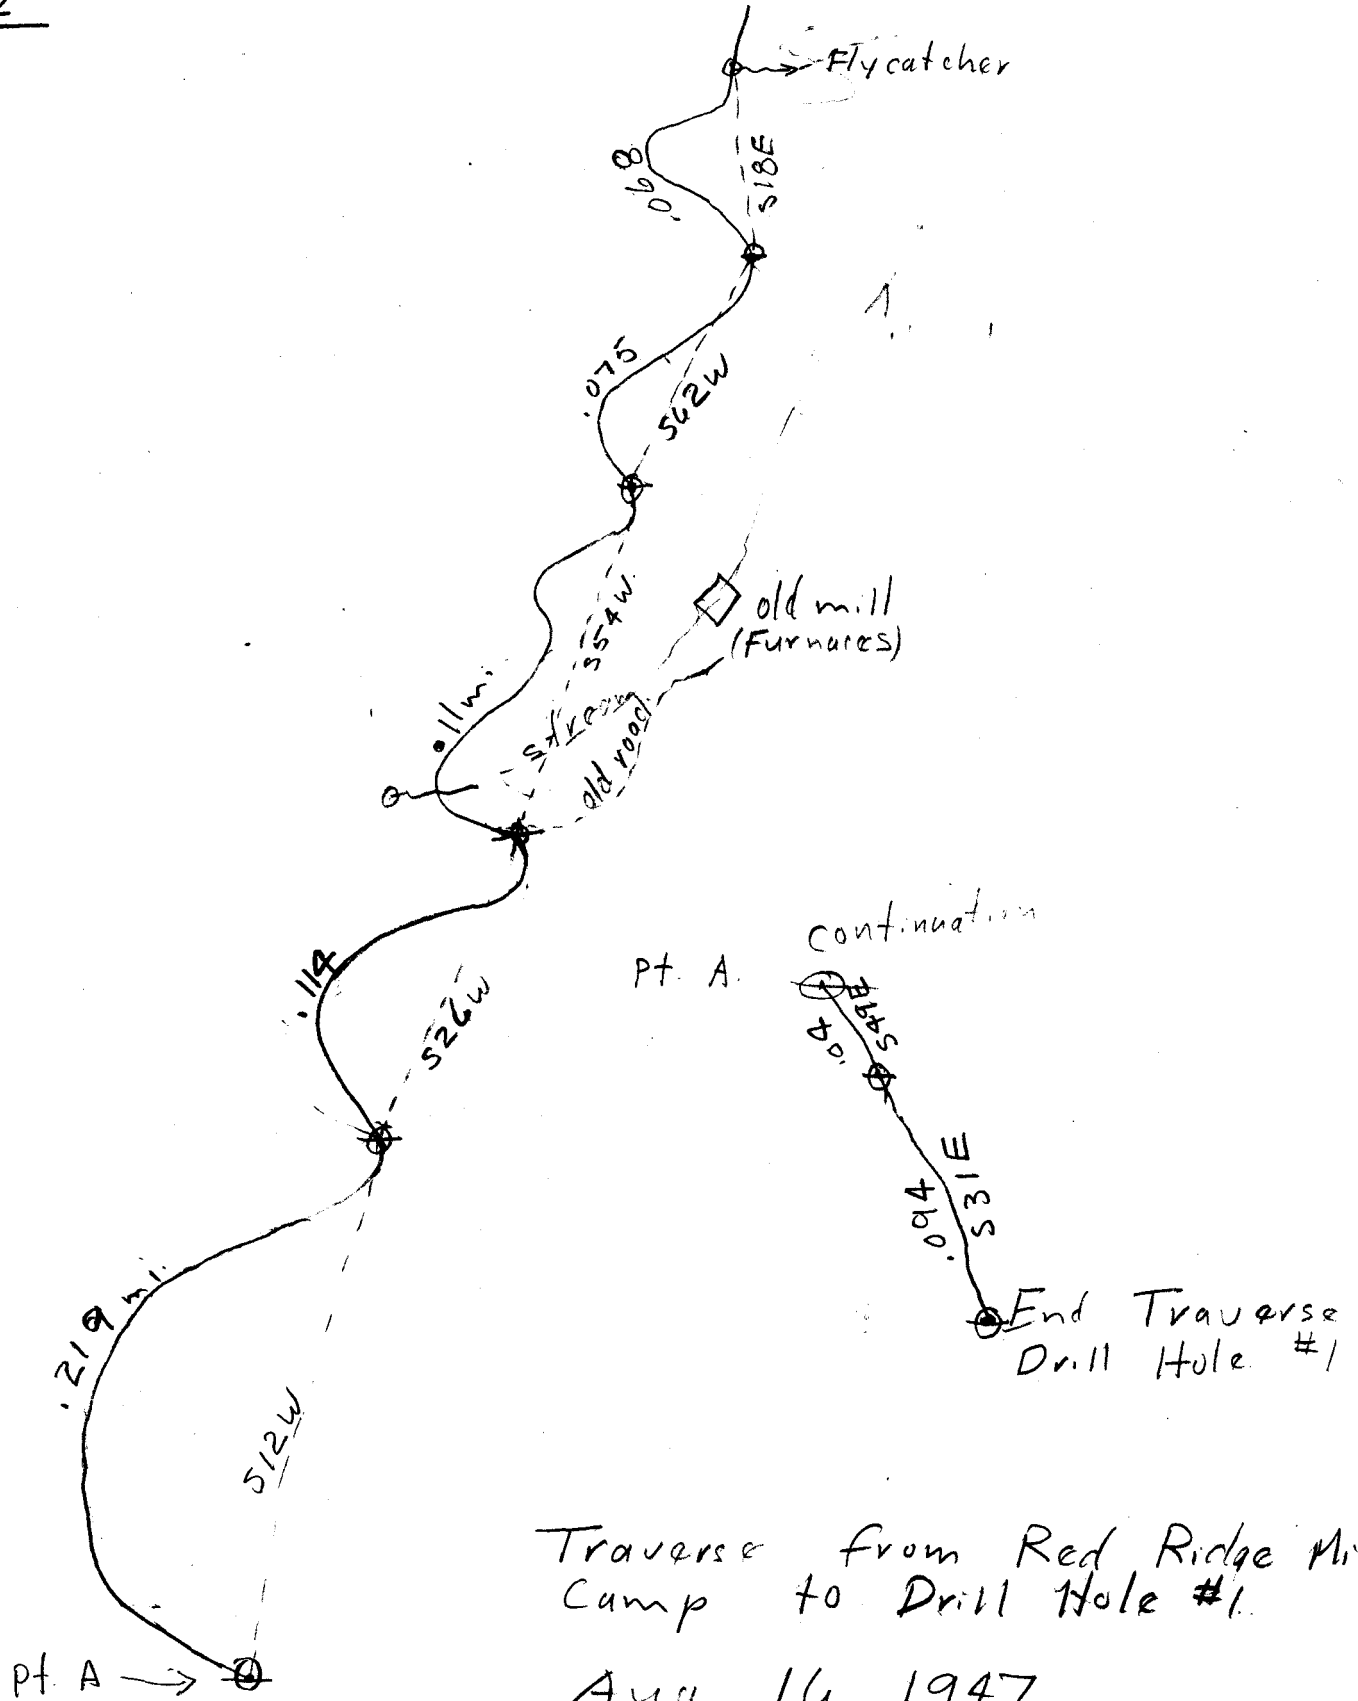


Traverse from Red Ridge Mine
Camp to Drill Hole #1

Aug 16, 1947

Dis - Libbey, Bearing - Mason

Red Flats Lake

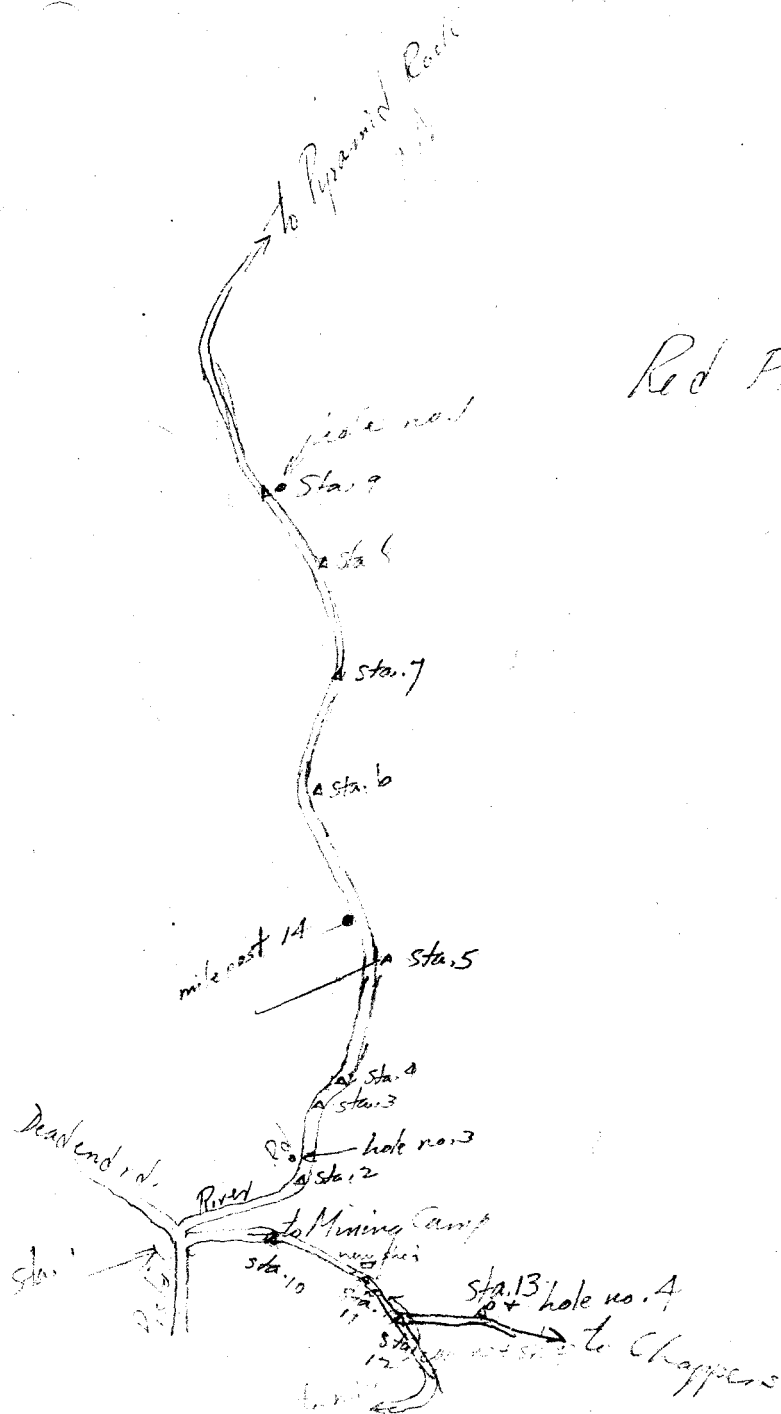

~~.11~~
~~.031~~
~~.08~~
~~.12~~
.28

All distances corrected.

Traverse from Red Ridge
 Mining Camp to Drill Hole
 #1.
 Aug 16, 1947

