



**Figure 1
Leaning Juniper IIA
and Leaning Juniper IIB
Site Boundaries**

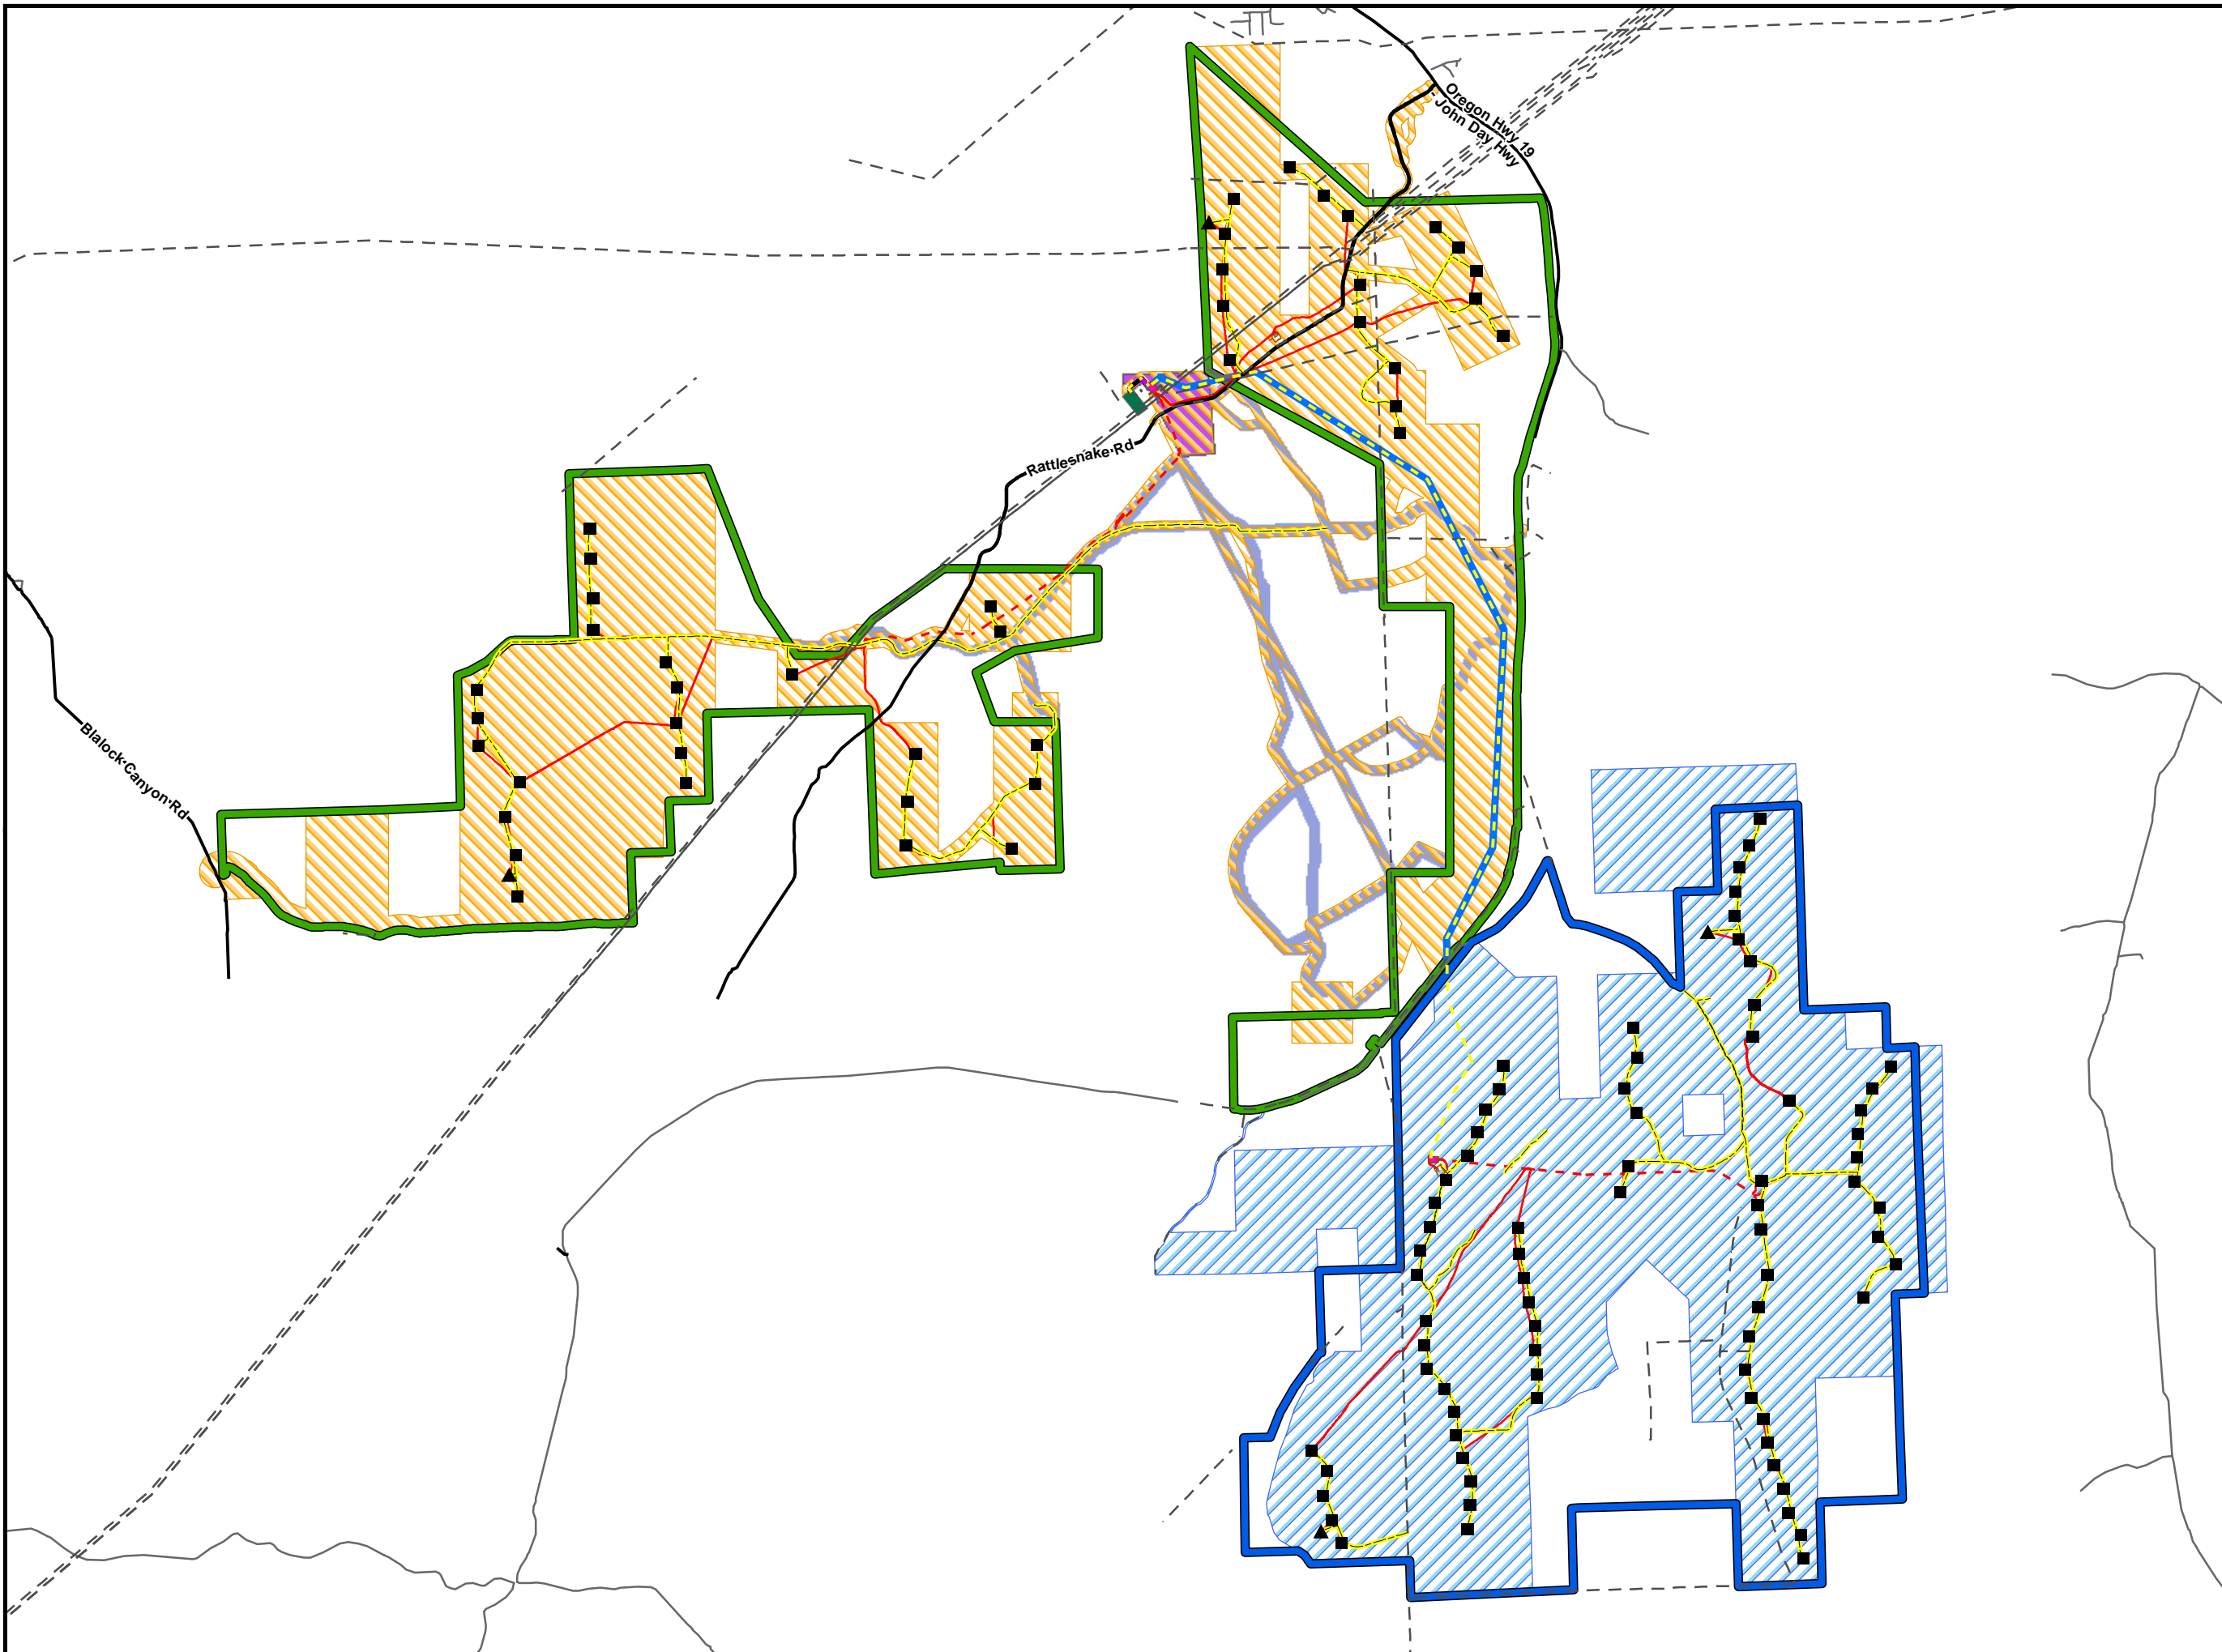

- As-Built Turbine
- ▲ As-Built Met Tower
- As-Built Underground 34.5-kV Line
- - As-Built Overhead 34.5-kV Line
- - As-Built 230-kV Transmission Line
- Underground Fiber Optic
- As-Built Access
- As-Built Fence
- - Existing Transmission Line
- As-Built O&M Facility
- As-Built Substation
- Jones Canyon Substation
- Leaning Juniper IIA Site Boundary
- Leaning Juniper IIB Site Boundary
- Leaning Juniper IIB Transmission Line Easement Included in Leaning Juniper IIB Site Boundary
- Lease Boundary
- Leaning Juniper IIA
- Leaning Juniper IIB
- Tatone Farm LLC

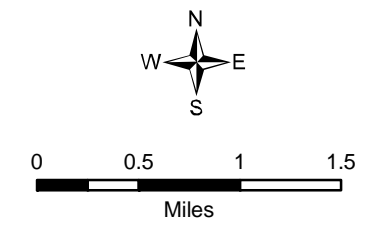

Modified Date: 10/30/2012)