


**DETECTOR PLAN**  
**SALEM HIGHWAY AT 25TH ST**  
**OR22 AT MP 7.52**  
**SALEM**

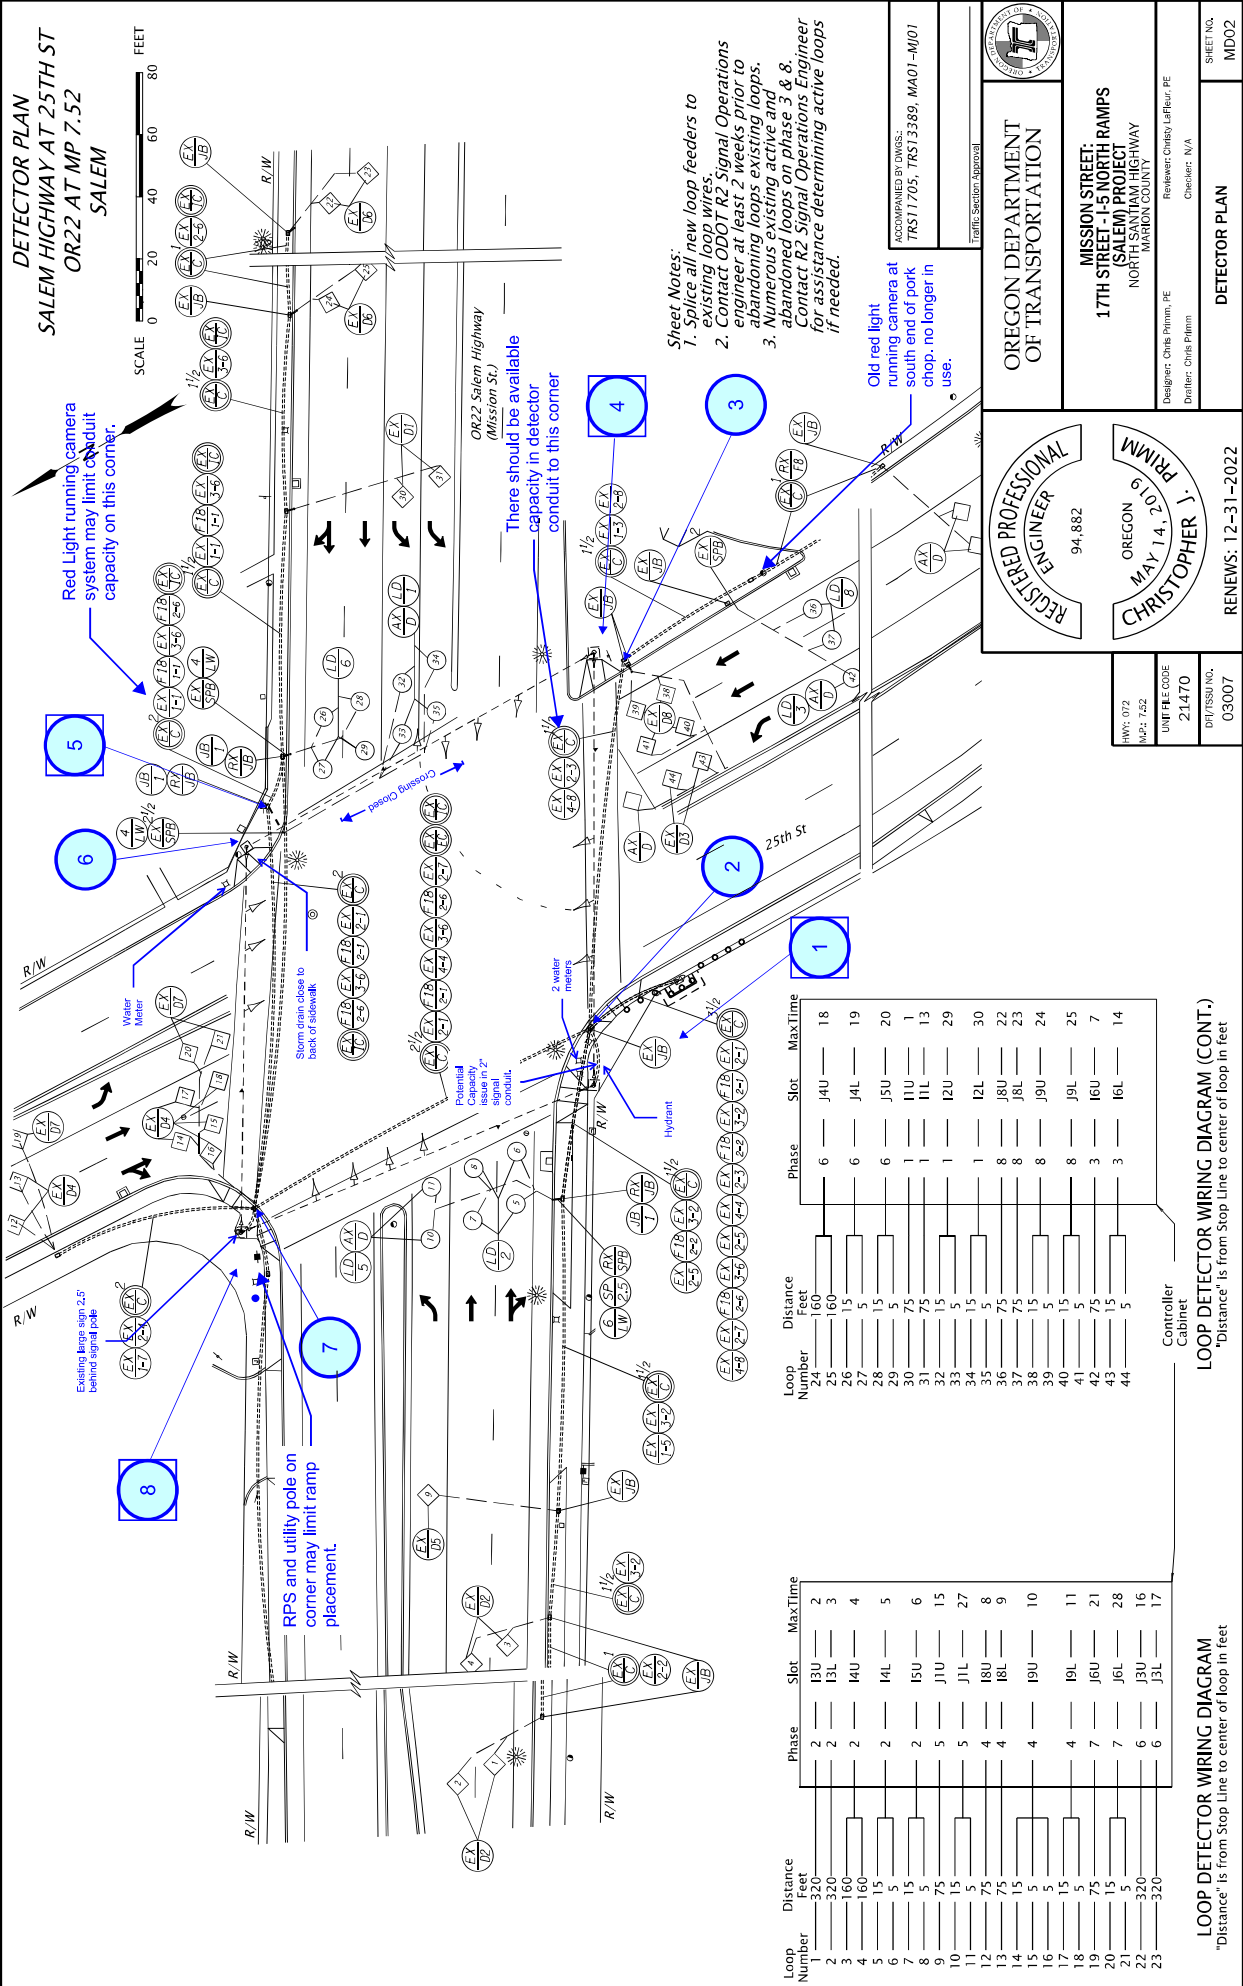

Loops and radar active.



- Sheet Notes:**
1. Splice all new loop feeders to existing loop wires.
  2. Contact ODOT R2 Signal Operations engineer at least 2 weeks prior to abandoning loops existing loops.
  3. Numerous existing active and abandoned loops on phase 3 & 8. Contact R2 Signal Operations Engineer for assistance determining active loops if needed.

Old red light running camera at south end of pork chop, no longer in use.

There should be available capacity in detector conduit to this corner

Red Light running camera system may limit conduit capacity on this corner.

RPS and utility pole on corner may limit ramp placement.

Existing large sign 2.5' behind signal pole.

Storm drain close to back of sidewalk.

Potential Capacity Issue in 2' signal conduit.

2 water meters

Hydrant

Old red light running camera at south end of pork chop, no longer in use.

ACCOMPANIED BY DWGS:  
 TRS17705, TRS73389, MA01-M01

DESIGNED BY: CHRIS PRIMM, PE  
 CHECKED BY: CHRIS PRIMM

DESIGNED BY: CHRIS PRIMM, PE  
 CHECKED BY: CHRIS PRIMM

REVIEWED BY: CHRIS PRIMM, PE  
 DATE: MAY 14, 2019

REVISIONS: 12-31-2022

REGISTERED PROFESSIONAL ENGINEER  
 CHRISTOPHER J. PRIMM  
 OREGON  
 MAY 14, 2019  
 94,882

MISSION STREET-15 NORTH RAMPS  
 (SALEM) PROJECT  
 NORTH HWY  
 MARRION COUNTY

DESIGNER: CHRIS PRIMM, PE  
 CHECKER: CHRIS PRIMM

REVIEWER: CHRIS PRIMM, PE  
 CHECKER: CHRIS PRIMM

OR22 Salem Highway (Mission St.)

SALEM HIGHWAY AT 25TH ST  
 OR22 AT MP 7.52  
 SALEM

SCALE: 1"=40'

DETECTOR PLAN  
 MDD02

SHEET NO.  
 MDD02

UNIFORM CODE  
 21470

DATE/ISSUE NO.  
 03007

HWY: 072  
 MP: 7.52


**LOOP DETECTOR WIRING DIAGRAM (CONT.)**  
 "Distance" is from Stop Line to center of loop in feet

Loop Number	Distance Feet	Phase	Slot	MaxTime
24	160	6	J4U	18
25	160	6	J4L	19
26	15	6	J5U	20
27	15	6	J5L	13
28	15	1	I1U	29
29	15	1	I1L	30
30	75	1	I2U	22
31	75	1	I2L	23
32	15	8	J8U	24
33	15	8	J8L	25
34	15	8	J9U	14
35	15	8	J9L	14
36	75	8	J8U	22
37	75	8	J8L	23
38	15	8	J9U	24
39	15	8	J9L	25
40	15	3	I6U	7
41	15	3	I6L	7
42	75	3	I6U	28
43	75	3	I6L	28
44	5	3	I6L	14

Controller Cabinet



**LOOP DETECTOR WIRING DIAGRAM**  
 "Distance" is from Stop Line to center of loop in feet

Loop Number	Distance Feet	Phase	Slot	MaxTime
1	320	2	I3U	2
2	320	2	I3L	3
3	160	2	I4U	4
4	160	2	I4L	5
5	15	2	I5U	6
6	15	2	I5L	15
7	15	5	J11U	27
8	75	5	J11L	8
9	75	4	I8U	9
10	15	4	I9U	10
11	15	4	I9L	11
12	75	7	J6U	21
13	75	7	J6L	28
14	15	6	I3U	16
15	15	6	I3L	17
16	5	6	I3U	16
17	5	6	I3L	17
18	15	6	I3U	16
19	15	6	I3L	17
20	75	6	I3U	16
21	75	6	I3L	17
22	320	6	I3U	16
23	320	6	I3L	17

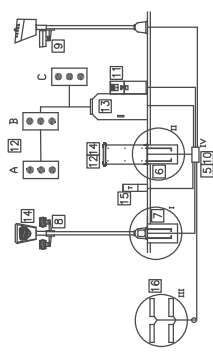




**CONSTRUCTION NOTES**

- 1 ALL SUBSTRUCTURES MUST BE LOCATED PRIOR TO CONSTRUCTION. THE CONTRACTOR SHALL AND MUST NOTIFY ALL UTILITY COMPANIES WITHIN A MINIMUM OF 48 HOURS PRIOR TO START OF WORK.
- 2 REFLEX WILL MEET WITH THE CONTRACTOR, CITY OFFICIALS, AND POLICE TO MARK THE EXACT LOCATION OF THE POLES AND CABINET PRIOR TO CONSTRUCTION.
- 3 TRAFFIC FLOW SHALL BE MAINTAINED AT ALL TIME. TEMPORARY SHUTDOWNS OR DISRUPTION MUST BE COORDINATED WITH THE CITY.
- 4 CONTRACTORS SHALL COMPLETE AS MANY POTHOLES AS NECESSARY. CONDUIT TO BE BORED UNDER ROADWAY. ALL BORE SHOTS SHALL BE DONE AT THE REQUIRED DEPTH TO MEET THE CITY STANDARDS.
- 5 INSTALL JIB-(12' x 17' x 12') CONCRETE JUNCTION BOX PER ODOT STANDARDS.
- 6 INSTALL FOUNDATION AND REFLEX CONTROL CABINET. INSTALL 5/8" X 10' GROUND ROD AND BOND TO CABINET WITH #8 BARE CU. SEE CABINET FOUNDATION DETAIL.
- 7 INSTALL FOUNDATION AND POLE FOR REFLEX EQUIPMENT. CONNECT POLE TO ODOT STRANDED BOND GROUND. SEE DRAWING FOR LOCATION. SEE POLE DETAIL.
- 8 INSTALL CAMERA AND (2) 250 WATT FLASH ENCLOSURES ON REFLEX POLE. AIM AT MONITORED APPROACH.
- 9 INSTALL CAMERA AND 500 WATT FLASH ENCLOSURE ON REFLEX POLE. AIM AT VIOLATION LINE.
- 10 ALL SPARE CONDUCTORS WIRES SHALL TERMINATE AT THE PULL BOXES AND IN THE CAMERA AND FLASH ENCLOSURES. THE CONTROL CABINETS, PULL BOXES, PULL BOXES AND FLASH ENCLOSURES, USE THE CONTROL CABINETS, PULL BOXES WITH PERMANENT IDENTIFICATION BAND AND TAG AS "RTS PROPERTIES".
- 11 CONTRACTORS SHALL TERMINATE ALL POWER CIRCUITS INTO REFLEX CABINET. INSTALL 40 AMP BREAKER INTO EXISTING CITY METER PEDestal FOR 120V SUPPLY TO RTS CABINET.
- 12 INSTALL IN-LINE FUSE HOLDER ON RED PHASE CONDUCTOR WITH 5 AMP FUSE INSIDE REFLEX CABINET, TO PROTECT CITY TRAFFIC CABINET.
- 13 INSTALL SOLID STATE RELAY (SSR) DEVICE ON EACH SEPARATE RED INDICATION IN ODOT CABINET AND DIRECT CONNECTION TO RED PHASING SHALL BE ALLOWED. SEE CONDUCTOR SCHEDULE FOR APPROACHES AND SEE DETAIL NOTE.
- 14 SCHEDULE THE CONTROLLER CABINET ACCESS WITH ODOT REGION 2 ELECTRICIAN AT (363) 986-2706 AT LEAST 48 HOURS BEFORE WORK IS TO OCCUR.
- 15 TERMINATE POLE TO REFLEX CABINET POWER CIRCUIT (HOT & NEUTRAL). CONNECT TO SOLID STRANDED BOND GROUND.
- 16 INSTALL DSL DROP INTO RTS CABINET.
- 17 INSTALL LOPS AND CONDUIT STUB OUT FOR REFLEX DETECTION. EACH LOOP MUST HAVE A SEPARATE HOME RUN AND LOOP LEAD IN CABLE. MAXIMUM 4 LOPS PER SAW CUT. REFLEX LOPS TO BE LABELED AT REFLEX CABINET. INSTALL ON ALL LOTS. SEE REFLEX DETECTION DETAIL.
- 18 INSTALLATION DETECTOR LOOP PLACEMENT DETAIL.

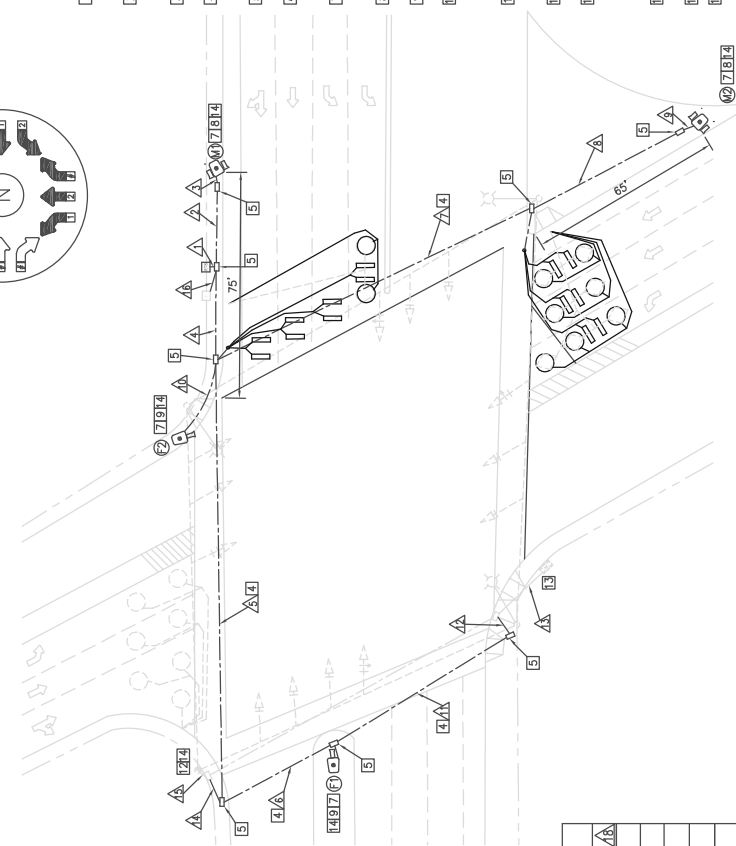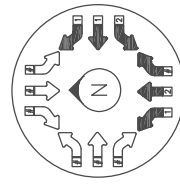

**LEGEND**

- ⊠ #5 JUNCTION BOX
- ⊠ RTS LOPS
- ⊠ TRAFFIC CONTROL CABINET
- ⊠ POWER CABINET
- ⊠ REFLEX CONTROL CABINET
- ⊠ CAMERA W/FLASH
- ⊠ PLATE FLASH

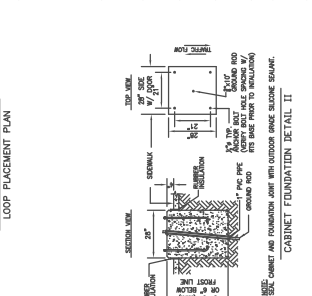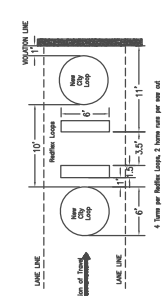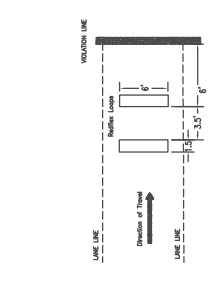

CONDUCTORS		CONDUITS TERMINATION REFLEX CABINET																	
SOURCE	AWG#	1	2	3	4	5	6	7	8	9	10	11	12	13	14	15	16	17	18
POLE (A)	CATS #10	3	3	3															
POLE (B)	CATS #10	2	2	2															
POLE (C)	CATS #10	1	1	1															
POLE (D)	CATS #10	2	2	2															
POLE (E)	CATS #10	3	3	3															
POLE (F)	CATS #10	2	2	2															
POLE (G)	CATS #10	1	1	1															
POLE (H)	CATS #10	2	2	2															
LOOP LEAD-IN	DLC	12	12																
STRANDED BOND	#8	1	1	1	1	1	1	1	1	1	1	1	1	1	1	1	1	1	1
TRAFFIC RED PHASE	#14	10	10	10															
POWER PEDESTAL (120V)	#8	2	2																
TOTAL NEW CONDUCTORS		42	18	6	24	14	14	12	6	12	4	11	11	2	2	1			
CONDUIT SIZE (INCHES)		2(3)	3	2	2	2	2	2	2	2	2	2	2	2	3	2	3	2	
NEW/EXISTING CONDUIT		N	N	N	N	N	N	N	N	N	N	N	N	N	N	N	N	N	N
CONDUIT LENGTH FT.																			
CONDUIT DEPTH IN.																			

**CITY OF SALEM OR**  
**PUBLIC WORKS DEPARTMENT**

PROJECT TITLE:  
**RED LIGHT PHOTO ENFORCEMENT ON SALEM (MISSION) HWY & 25TH ST.**

PROJECT CODE:  
 XXXXAMEBA

PLANS SCALE:  
 1" = 20'

REVISIONS

NO.	DESCRIPTION

DESIGNED BY: JDS/SLM  
 DRAWN BY: CMB/TJL/ESJ/T  
 CHECKED BY: JTS/CKK/KE

ISSUED BY: RED LIGHT PHOTO ENFORCEMENT CABINETS  
**REFLEX**  
 6076 BROOKSIDE PARK SUITE 100  
 CLATSOP COUNTY, OR 97130  
 POC: JIM GIBSON  
 POC: JIM GIBSON

FLAN NO.  
 SHEET NO. **1** OF **1**

**CITY OF SALEM OR**  
**PUBLIC WORKS DEPARTMENT**

PROJECT TITLE:  
**RED LIGHT PHOTO ENFORCEMENT ON SALEM (MISSION) HWY & 25TH ST.**

PROJECT CODE:  
 XXXXAMEBA

PLANS SCALE:  
 1" = 20'

REVISIONS


NO.	DESCRIPTION

DESIGNED BY: JDS/SLM  
 DRAWN BY: CMB/TJL/ESJ/T  
 CHECKED BY: JTS/CKK/KE

ISSUED BY: RED LIGHT PHOTO ENFORCEMENT CABINETS  
**REFLEX**  
 6076 BROOKSIDE PARK SUITE 100  
 CLATSOP COUNTY, OR 97130  
 POC: JIM GIBSON  
 POC: JIM GIBSON

FLAN NO.  
 SHEET NO. **1** OF **1**

HT	1	2	3	4	5	6	7	8	9	10	11	12	13	14	15	16	17	18	19	20	21	22	23	24	25	26	27	28	
HT	CAT 5	ROADSIDE CABINET	POLE MOUNTED CAB	POWER PEDESTAL	PHONE PEDESTAL	PIEZO LOOPS	VIDEO LOOPS	APPROX. SYSTEMS	APPEARANCE	COMPARISON	SCALE	FACE	SLIDE	PLATE	LEDS	FACE	SURFACE	CABINET	SYSTEMS	APPEARANCE	COMPARISON	SCALE	FACE	SLIDE	PLATE	LEDS	FACE	SURFACE	
10'	8	9	10	11	12	13	14	15	16	17	18	19	20	21	22	23	24	25	26	27	28	29	30	31	32	33	34	35	36
10'	8	9	10	11	12	13	14	15	16	17	18	19	20	21	22	23	24	25	26	27	28	29	30	31	32	33	34	35	36
TOTAL																													

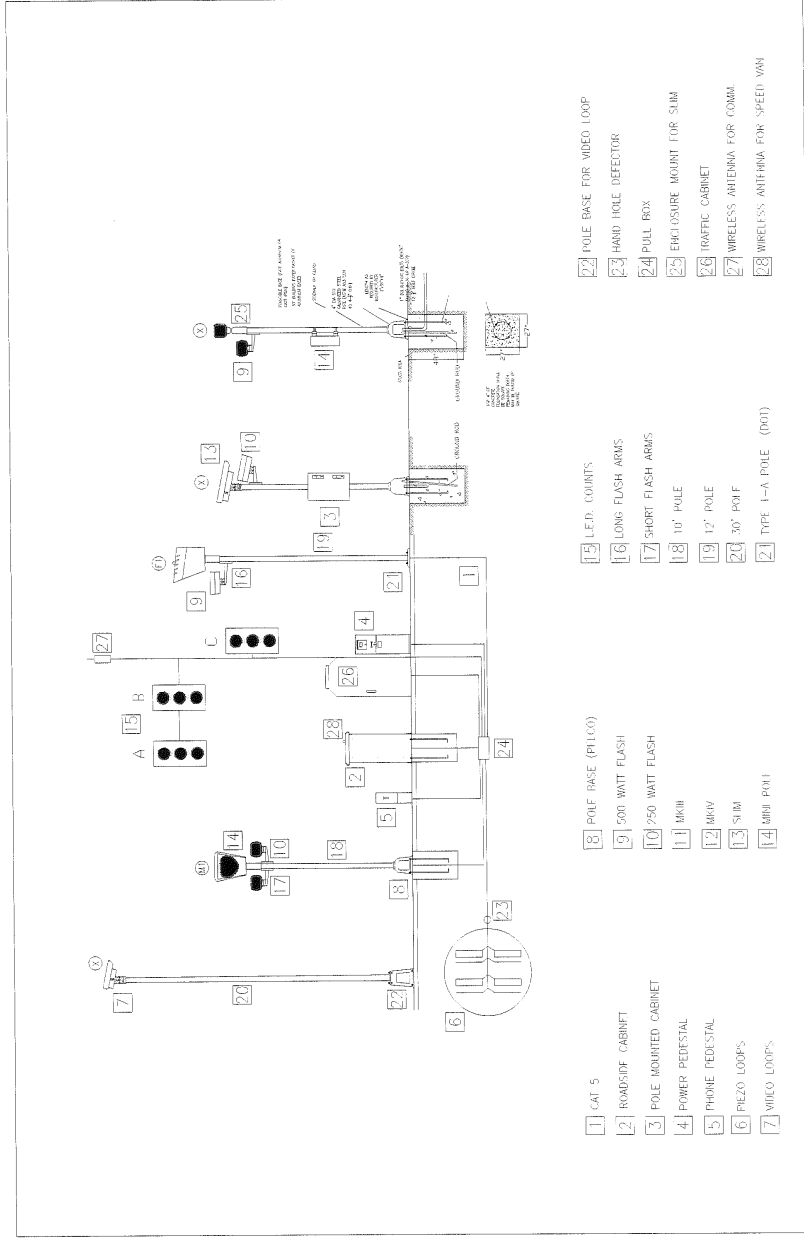

SYSTEM	APPEARANCE	COMPARISON	SCALE	FACE	SLIDE	PLATE	LEDS	FACE	SURFACE	CABINET
MKIII	USE SUB SYSTEM FOR SYSTEM FOR W/TRAFFIC CABINET	5716	2 MPKS	6 MPK UP TO FOUR LINES 10 MPKS 4 LINES 6 LINES 12 MPKS 120 SHOT SPLIT LANE STD ENCLASURE	6-12 MM	8-48 MM	80-200 MM	4.6, 26.11 STD SWITCH TO 4.8 IT RECORDS AVAILABLE	SDC LOOP-LOOP, POP/PA/LED, ROADER, PHASE DISTRIBUTION, PHASE DETECTOR, FUSE/BOARD-SOLID STATE	
MKIV	WITH ROADSIDE CABINET	USE SUB SYSTEM FOR SYSTEM FOR ROADSIDE CABINET	4 MPK UP TO FOUR LINES 10 MPKS 4 LINES 6 LINES 12 MPKS 120 SHOT SPLIT LANE STD ENCLASURE	6-12 MM	8-48 MM	80-200 MM	4.6, 26.11 STD SWITCH TO 4.8 IT RECORDS AVAILABLE	SDC LOOP-LOOP, POP/PA/LED, ROADER, PHASE DISTRIBUTION, PHASE DETECTOR, FUSE/BOARD-SOLID STATE		
MKVI	WITHOUT ROADSIDE CABINET	VIDEO ROADSIDE CABINET	4 MPK UP TO FOUR LINES 10 MPKS 4 LINES 6 LINES 12 MPKS 120 SHOT SPLIT LANE STD ENCLASURE	6-12 MM	8-48 MM	80-200 MM	4.6, 26.11 STD SWITCH TO 4.8 IT RECORDS AVAILABLE	SDC LOOP-LOOP, POP/PA/LED, ROADER, PHASE DISTRIBUTION, PHASE DETECTOR, FUSE/BOARD-SOLID STATE		
SLM	POLE MOUNTED CABINET	6812 ROADSIDE CABINET	2 MPKS	6 MPK UP TO FOUR LINES 10 MPKS 4 LINES 6 LINES 12 MPKS 120 SHOT SPLIT LANE STD ENCLASURE	6-12 MM	8-48 MM	80-200 MM	4.6, 26.11 STD SWITCH TO 4.8 IT RECORDS AVAILABLE	SDC LOOP-LOOP, POP/PA/LED, ROADER, PHASE DISTRIBUTION, PHASE DETECTOR, FUSE/BOARD-SOLID STATE	
MPII	POLE MOUNTED CABINET	USE ONE FOR POLE MOUNTED CABINET	2 MPKS	6 MPK UP TO FOUR LINES 10 MPKS 4 LINES 6 LINES 12 MPKS 120 SHOT SPLIT LANE STD ENCLASURE	6-12 MM	8-48 MM	80-200 MM	4.6, 26.11 STD SWITCH TO 4.8 IT RECORDS AVAILABLE	SDC LOOP-LOOP, POP/PA/LED, ROADER, PHASE DISTRIBUTION, PHASE DETECTOR, FUSE/BOARD-SOLID STATE	

**CITY OF RIVERSIDE, CA**  
**PUBLIC WORKS DEPARTMENT**

**PROJECT TITLE:**  
**RED LIGHT PHOTO ENFORCEMENT ON XXXXX & XXXXX**  
**BILL OF MATERIALS (BOM)**

**PLAN SCALE:**  
**1" = 10'**

**PROJECT CODE:**

**REVISIONS**

**DESCRIPTION:**

**SIGNATURE:**

**DESIGNED BY:** JORN IMMER  
**DRAWN BY:** CAMERON TARRANT

**SUBMITTED BY:**  
**APPROVED BY:**


**PLAN NO.:**  
**SHEET NO. 1 OF 1**

**DATE:**

**RED LIGHT PHOTO ENFORCEMENT CABINETS**  
**TRAFFIC SYSTEMS**  
 6076 BRISTOL PKWY., SUITE 100  
 COLTON, CA 92320  
 TEL: 951.310.6422 FAX: 951.310.6470



DETECTOR PLAN  
SALEM HIGHWAY (MISSION ST.) AT 25TH ST.  
ORE99E BUS M.P. 7.54

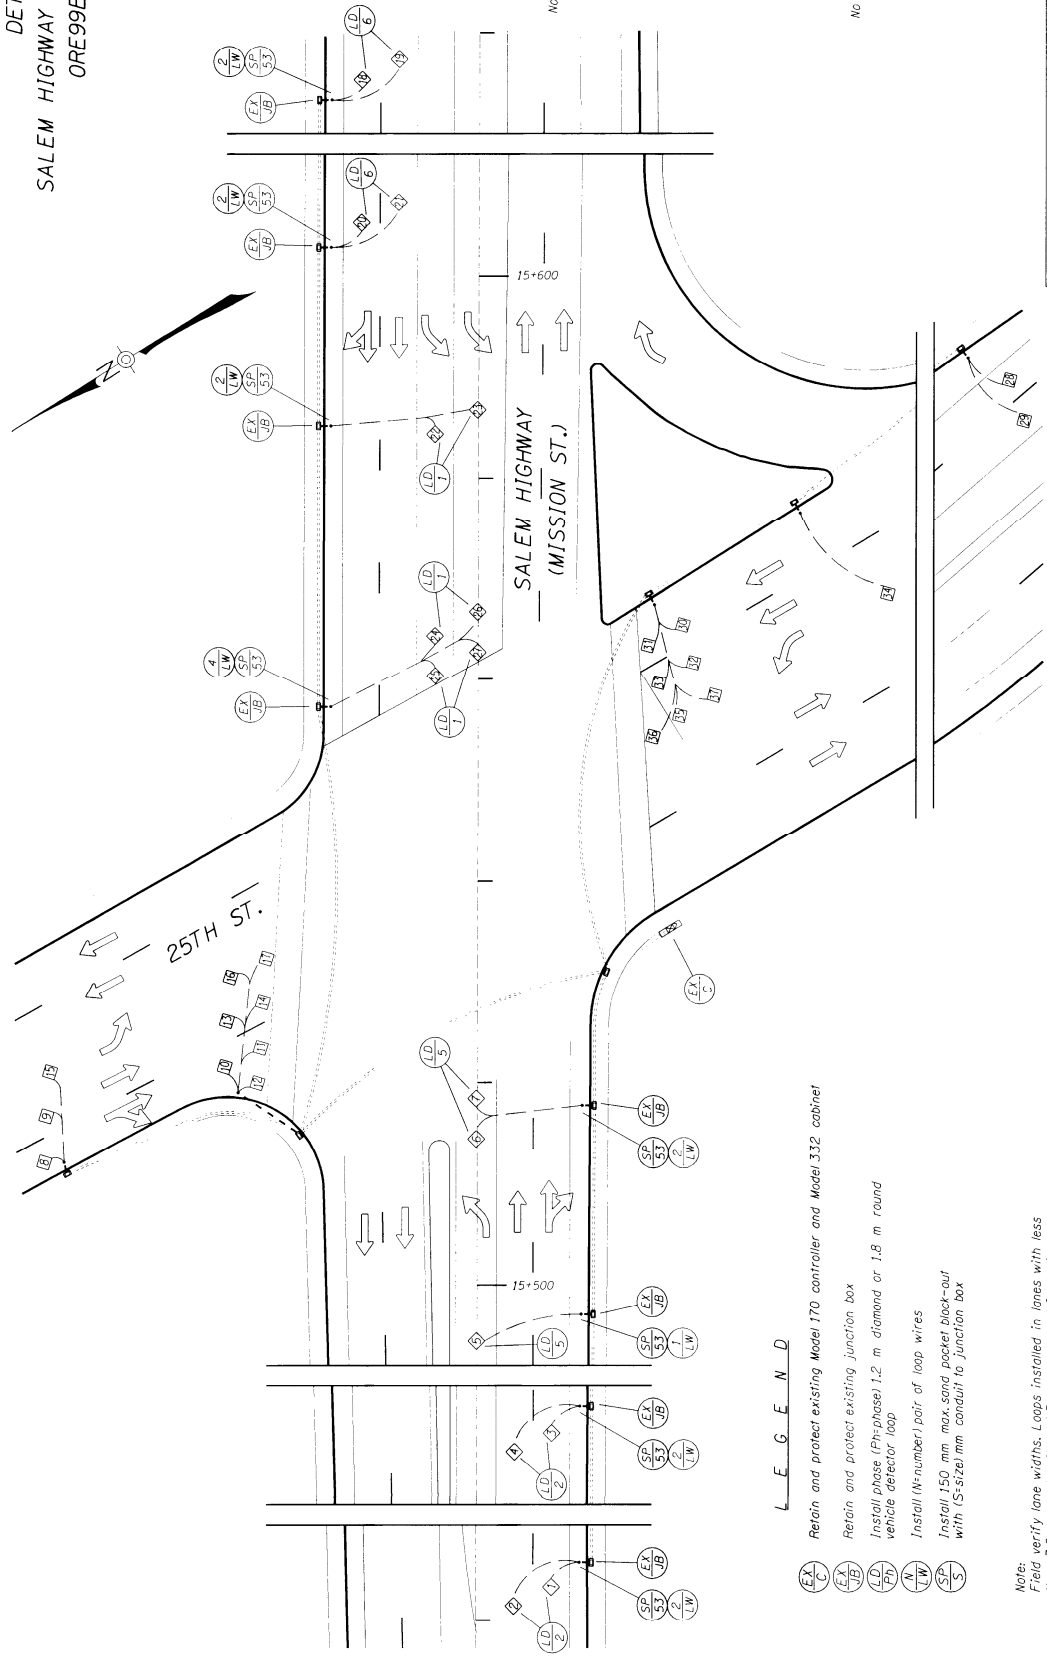

Loop Number	Distance Meters	Phase	Slot
1	100	2	12U
2	100	2	12L
3	50	2	13U
4	50	2	13L
5	25	5	J1U
6	25	5	J1L
7	25	5	J5U
8	25	5	J5L
9	25	4	J6U
10	25	4	J6L
11	1	1	17U
12	1	1	17L
13	5	4	17U
14	5	4	17L
15	25	7	J5U
16	25	7	J5L
17	1	7	J9L
18	100	6	J2U
19	100	6	J2L
20	50	6	J3U
21	50	6	J3L
22	25	1	11U
23	25	1	11L
24	5	1	19U
25	5	1	19L
26	60	8	J6U
27	60	8	J6L
28	60	8	J7U
29	60	8	J7L
30	5	3	15U
31	5	3	15L
32	5	3	19U
33	5	3	19L
34	25	3	15U
35	25	3	15L
36	1	3	19U
37	1	3	19L

LOOP DETECTOR WIRING DIAGRAM  
"Distance" is from Stop Line to center of loop in meters

- (EX) Retain and protect existing Model 170 controller and Model 332 cabinet
- (LW) Retain and protect existing junction box
- (LD) Install phase (Ph:phase) 1.2 m diamond or 1.8 m round vehicle detector loop
- (N) Install (N=number) pair of loop wires
- (SP) Install 150 mm max. sand pocket block-out with (S=size) mm conduit to junction box

Note:  
Field verify lane widths. Loops installed in lanes with less than 3.6m must be either 1.5 m round or 1.2 m diamonds.

Note:  
Contractor is responsible for re-wiring and re-numbering of new and existing detector loops in junction boxes and cabinet, to match wiring diagram. Splice new loops to existing loop feeders as needed.



DESIGNED BY: S. Cramer  
CHECKED BY: J. Jenkins  
DRAWN BY: S. Cramer  
P.C. 72

OREGON DEPARTMENT OF TRANSPORTATION  
TRAFFIC MANAGEMENT SECTION  
CHEMAMA ROAD - N SANTIAM INTERCHANGE  
SALEM HIGHWAY  
MARTON COUNTY


13390

**SIGNAL PLAN**  
**MISSION ST. AT 25TH. ST.**  
**HWY. 72, M.P. 7.54**



**L E G E N D**

- Retain and protect existing power pole (Power source)
- Install model 170 controller in model 332 cabinet with riser frame, orient frontward door as shown
- Install type (T) height (H) standard steel strain pole
- Install metal pole barrier
- Install phase (Ph) vehicle signal
- Install phase (Ph) programmed vehicle signal
- Install type (T) pedestrian signal
- Install phase (Ph) pedestrian pushbutton with instruction sign
- Install interior illuminated "LEFT TURN - SIGNAL" sign
- Install 6"x8"x18" terminal cabinet with sectional terminal block & connectors
- Install 8"x15"x20" service cabinet, 120 volt for both signal and illumination circuits (See T E S DWG 15-(16))
- Install 120 volt meter base
- Install 25 1/4"x12 1/4"x13" precast concrete junction box
- Install 30"x17"x12" precast concrete junction box
- Install (M) No. 8 type THWN (Signal system common)
- Install (N) No. 14 type THWN w/.35
- Install (N) No. (G) type TW THW or THWN wires
- Install (K) - (N) No. (G) control cables
- Install 3/8 inch galv steel messenger cable
- Install 1/2 inch galv steel tether cable
- Install (S) 1/2 inch steel rod conduit
- Interconnect conduit (See Interconnect Plan)
- Detector conduit (See Detector Plan)
- Install channel (Ch) (W-way fire pre-emption detector unit)
- Install channel (Ch) fire pre-emption detector feeder cable
- Install 250 watt high pressure sodium luminaire type M-N-111 120 volt regulator, multi-rip type ballast
- Install photoelectric cell on top of pole
- Install crosswalk closure barricade and sign (See T.E.S. Draw No. 15-104)
- Install (L) 111 luminaire arm

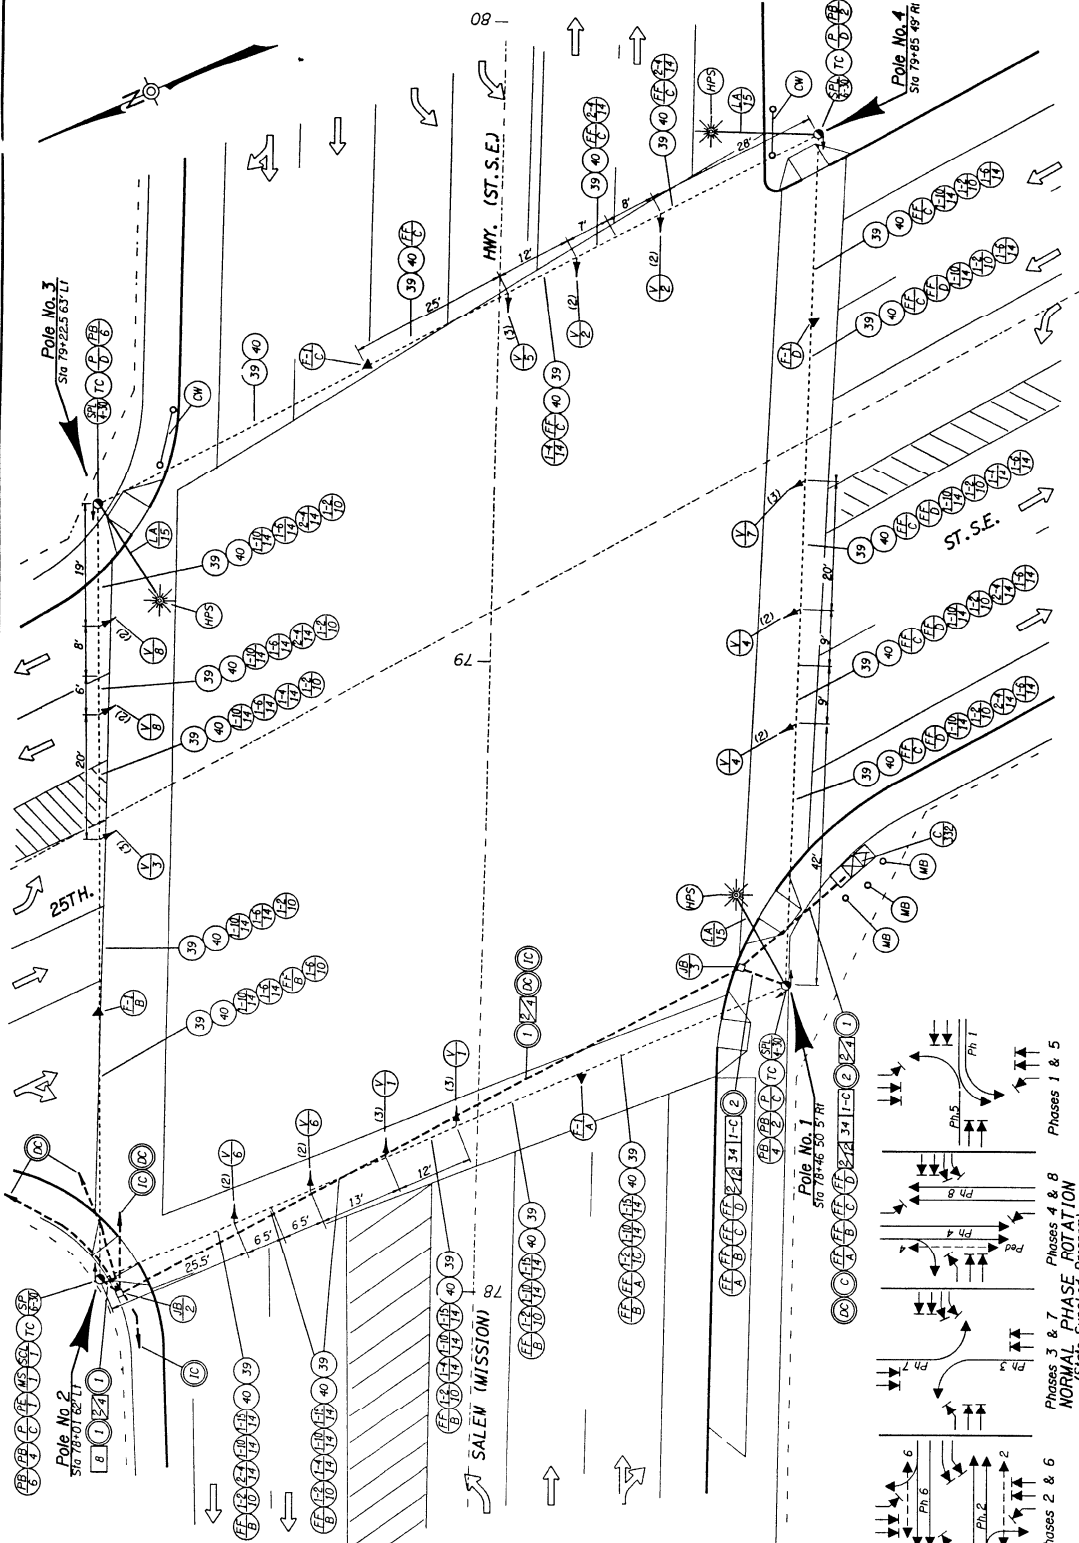


**L E G E N D (Cont.)**

Install type (T) height (H) standard strain pole with luminaire pole extension 140 ft mounting height

H = Height shown  
 T = Type shown  
 L = Length shown  
 Ph = Phase shown  
 X = Number of cables shown

N = Number shown  
 G = ANG size shown  
 S = Size shown  
 Ch = Channel shown  
 2 = 12"R 12"Y 12"O  
 3 = 12"ALTA 12"YLTA 12"CLTA

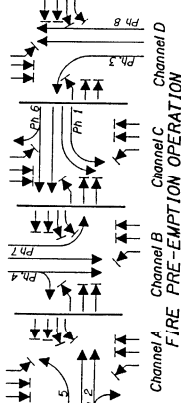


12/92 As Constructed (Original Copy in File/C11159)

**OREGON STATE HIGHWAY DIVISION**  
**TRAFFIC SIGNAL INSTALLATION SECTION**  
**25TH. ST. - AIRPORT RD./SALEM SEC.**  
**SALEM HIGHWAY**  
 MARION COUNTY

DATE: January 1992  
 DRAWN BY: [Signature]  
 CHECKED BY: [Signature]  
 SCALE: 1" = 40'-0"


PROJECT NO. 9902  
 SHEET NO. 9902

**DETECTOR AND REMOVAL PLAN  
MISSION ST. AT 25TH ST.  
HWY. 72, M.P. 7.54**

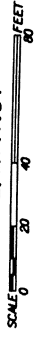

**LEGEND**

- (C) Controller (See Signal Plan)
  - (J) Junction box (See Signal Plan)
  - (I) Install 17/8" x 10 1/2" x 12" precast concrete junction box
  - (D) Install phase (PH) 4/11 diamond vehicle detector loop
  - (L) Install phase (PH) 3/11 diamond vehicle detector loop
  - (M) Install (M) phase (PH) loop feeder cables
  - (W) Install (W) pair of loop wires
  - (S) Install (S) non electrical conduit
  - (EC) Electrical conduit (See Signal Plan)
  - (IC) Interconnect conduit (See Interconnect Plan)
- Ph = Phase shown  
X = Number of cables shown  
N = Number shown  
S = Size shown

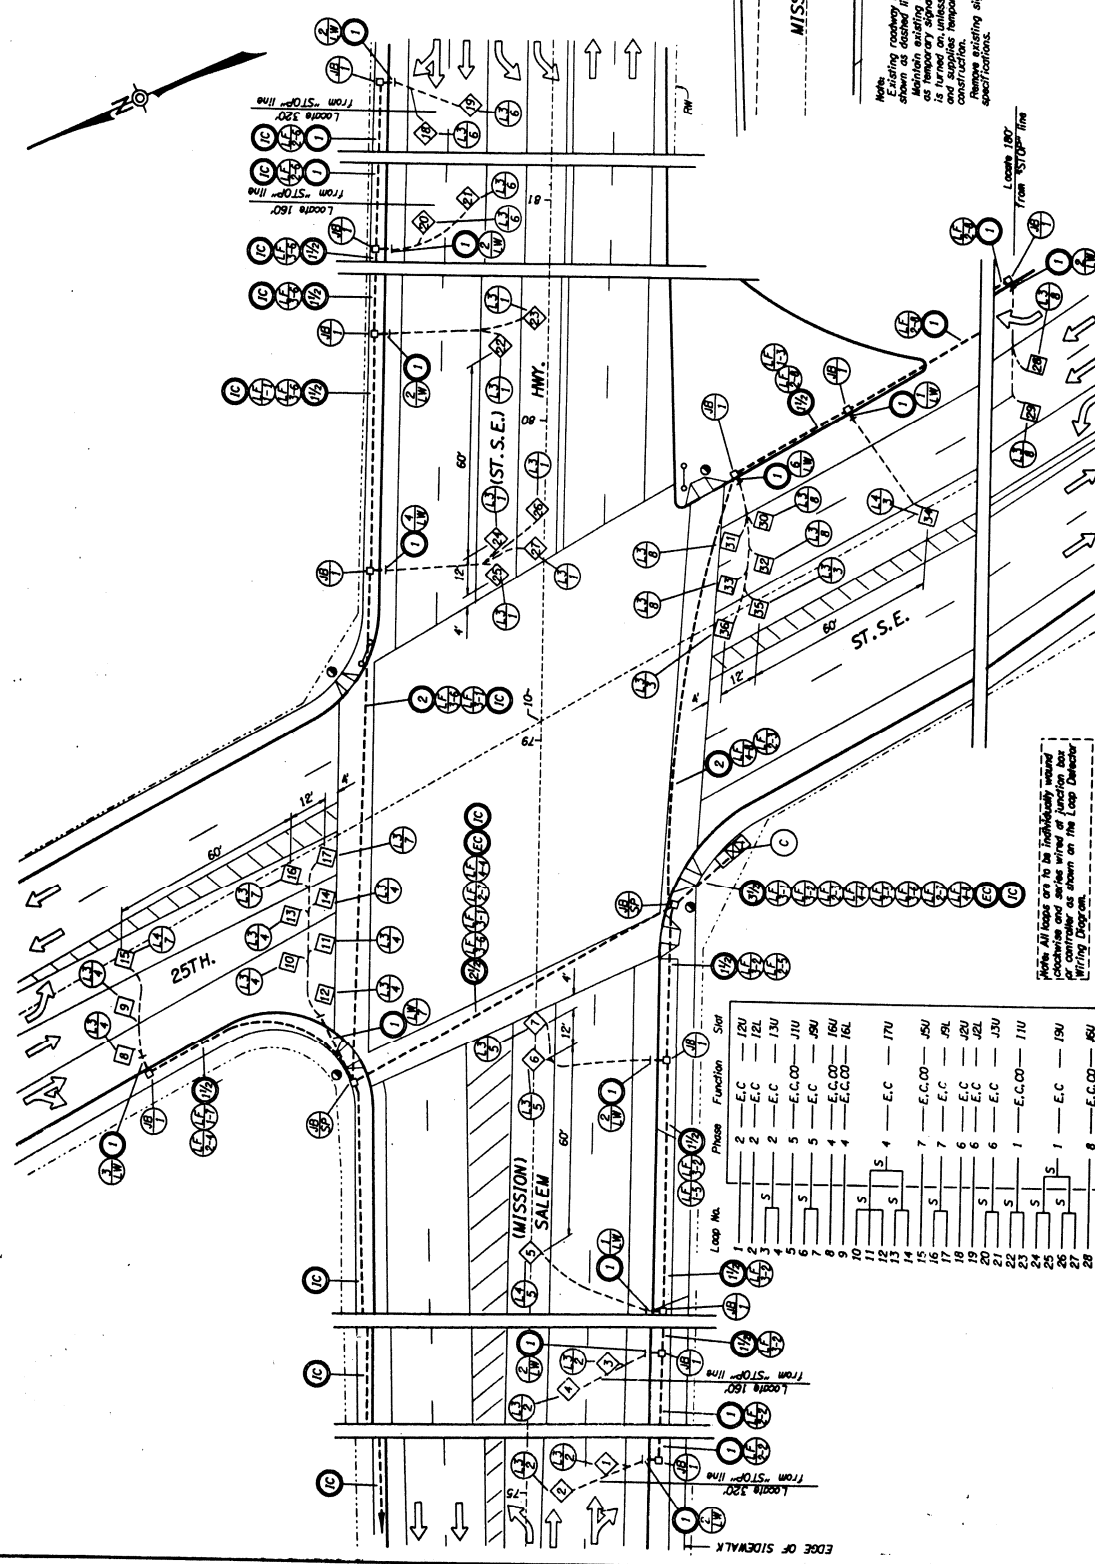


Notes: All loops are to be individually wired (locations and wire/wire of junction box locations and wire/wire of junction box locations are shown on the Loop Detector Wiring Diagram.)

Controller cabinet

Loop No.	Phase	Function	Size
1	2	E-C	12U
2	2	E-C	12L
3	2	E-C	13U
4	2	E-C	13L
5	5	E-C	11U
6	5	E-C	11L
7	5	E-C	12U
8	5	E-C	12L
9	4	E-C	13U
10	4	E-C	13L
11	4	E-C	11U
12	4	E-C	11L
13	7	E-C	15U
14	7	E-C	15L
15	6	E-C	14U
16	6	E-C	14L
17	6	E-C	13U
18	6	E-C	13L
19	6	E-C	12U
20	6	E-C	12L
21	6	E-C	11U
22	6	E-C	11L
23	1	E-C	11U
24	1	E-C	11L
25	1	E-C	10U
26	1	E-C	10L
27	8	E-C	16U
28	8	E-C	16L
29	8	E-C	15U
30	8	E-C	15L
31	8	E-C	14U
32	8	E-C	14L
33	3	E-C	15U
34	3	E-C	15L
35	3	E-C	14U
36	3	E-C	14L

Notes: E-Excavation, C-Call, CD-Cover, S-See, W-Wire, L-Loop, U-Under, L-Loop, D-Detector, W-Wiring, D-Diagram, W-Wiring, D-Diagram, W-Wiring, D-Diagram.

**LOOP DETECTOR WIRING DIAGRAM**

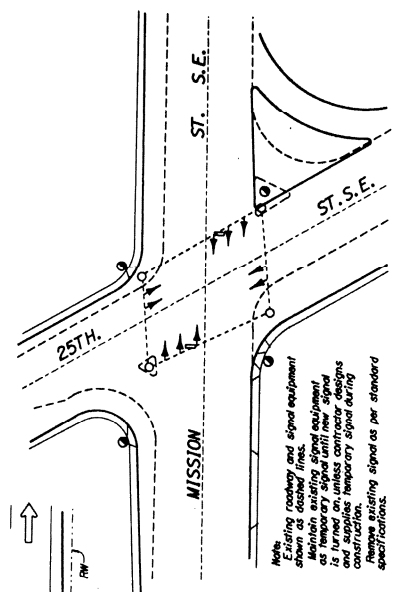

**REMOVAL PLAN  
No. Scale**

OREGON STATE HIGHWAY DIVISION  
TRAFFIC ENGINEERING SECTION

25TH ST. - AIRPORT RD/SALEM SEC.  
SALEM HIGHWAY  
MARION COUNTY

DATE: JANUARY 1981

DESIGNED BY: E.R. HALL

CHECKED BY: P.M.W.

APPROVED BY: G.J.M. / D.H.L.

I.D. NO. 9503


INTERCONNECT PLAN

MISSION ST., 22ND ST. TO AIRPORT RD.  
HWY. 72, M.P. 7.80 TO 7.92




L E G E N D

- Maintain and protect existing controller
- Install 1 7/8" x 10 1/2" x 12" precast concrete junction box
- Install (M) twisted pair interconnect cable
- Install (S) incl. electrical conduit
- Maintain and protect existing 2" conduit sub
- N = Number shown
- S = Size shown

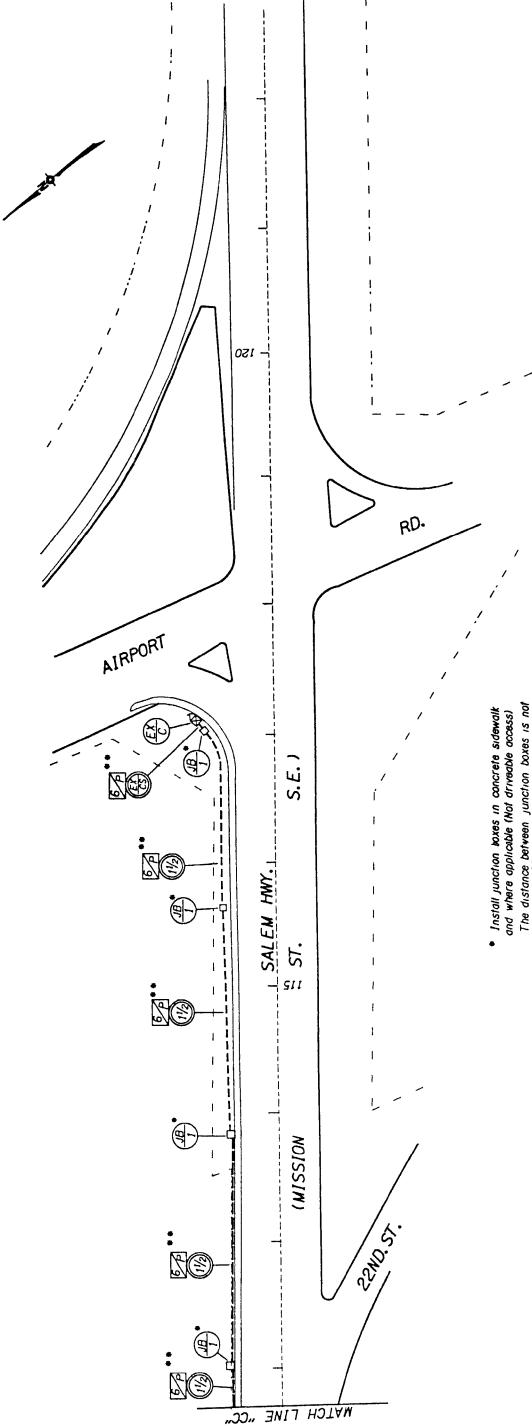

\* Install junction boxes in concrete sidewalk and where applicable (not drivable access). The distance between junction boxes is not to exceed 150'

\*\* Excavation for conduit shall comply to Section 661.32 of STANDARD SPECIFICATIONS

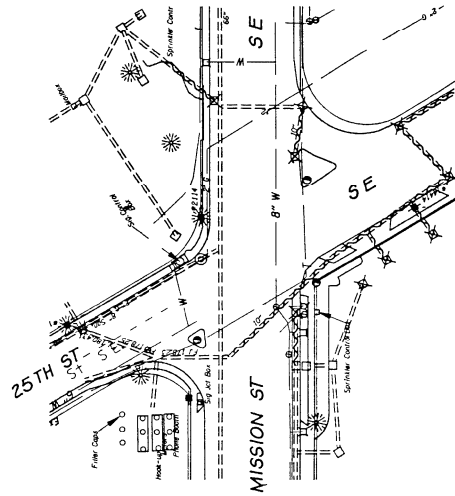

EXISTING INTERSECTION & UTILITIES  
(No Scale)

12/92 As Constructed (Original Copy in File) (C11159)

		OREGON STATE HIGHWAY DIVISION TRAFFIC SIGNAL INSTALLATION SECTION 25TH - AIRPORT RD. SALEM SEC. SALEM HIGHWAY MARION COUNTY
		DATE: JANUARY 1992 I.E. No. 9905
Record No. _____ P.L.R./T.H. H. Original No. _____ P.W.W. Drawn By _____ C.W.W.		