14 V-5

(1) Const. Type "A" Curb

(2) Const. P.C. Conc. Walk

(4) Const. P.C. Conc. Driveways, Type "A(M)"-2 (Total)

(6) Sta. 52+~~45~~ 23
~~Const.~~ Type "CG-2" Inlet
~~Inst.~~ 8" Sewer Pipe ~~54'~~ 28'
Tr. Exc. ~~19 C.Y.~~

(7) ~~Sta.~~ 54+20
~~Const.~~ Type "CG-2" Inlet
~~Inst.~~ 8" Sewer Pipe ~~24'~~ 21'
Tr. Exc. 25 C.Y.

Sec. 29, T. 2 S., R. 1 W., W.M.
SHERWOOD

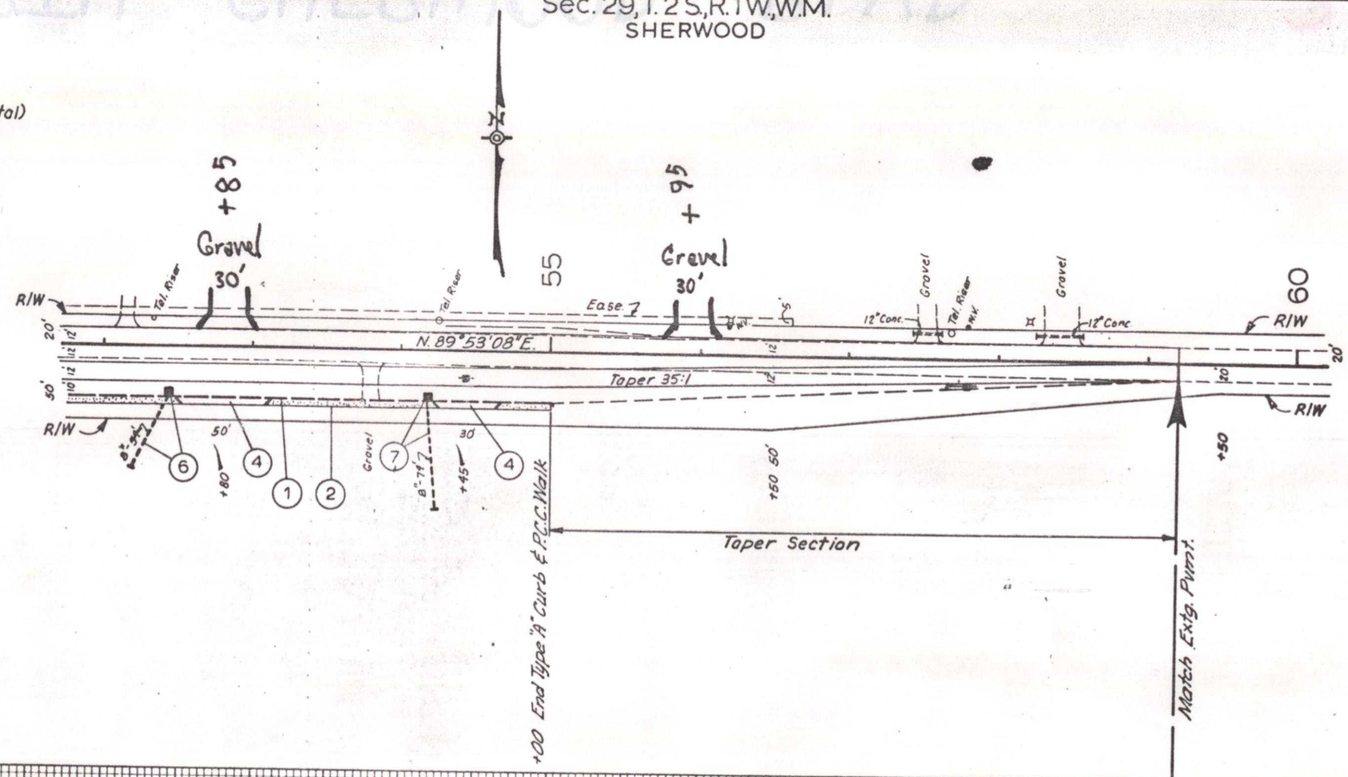

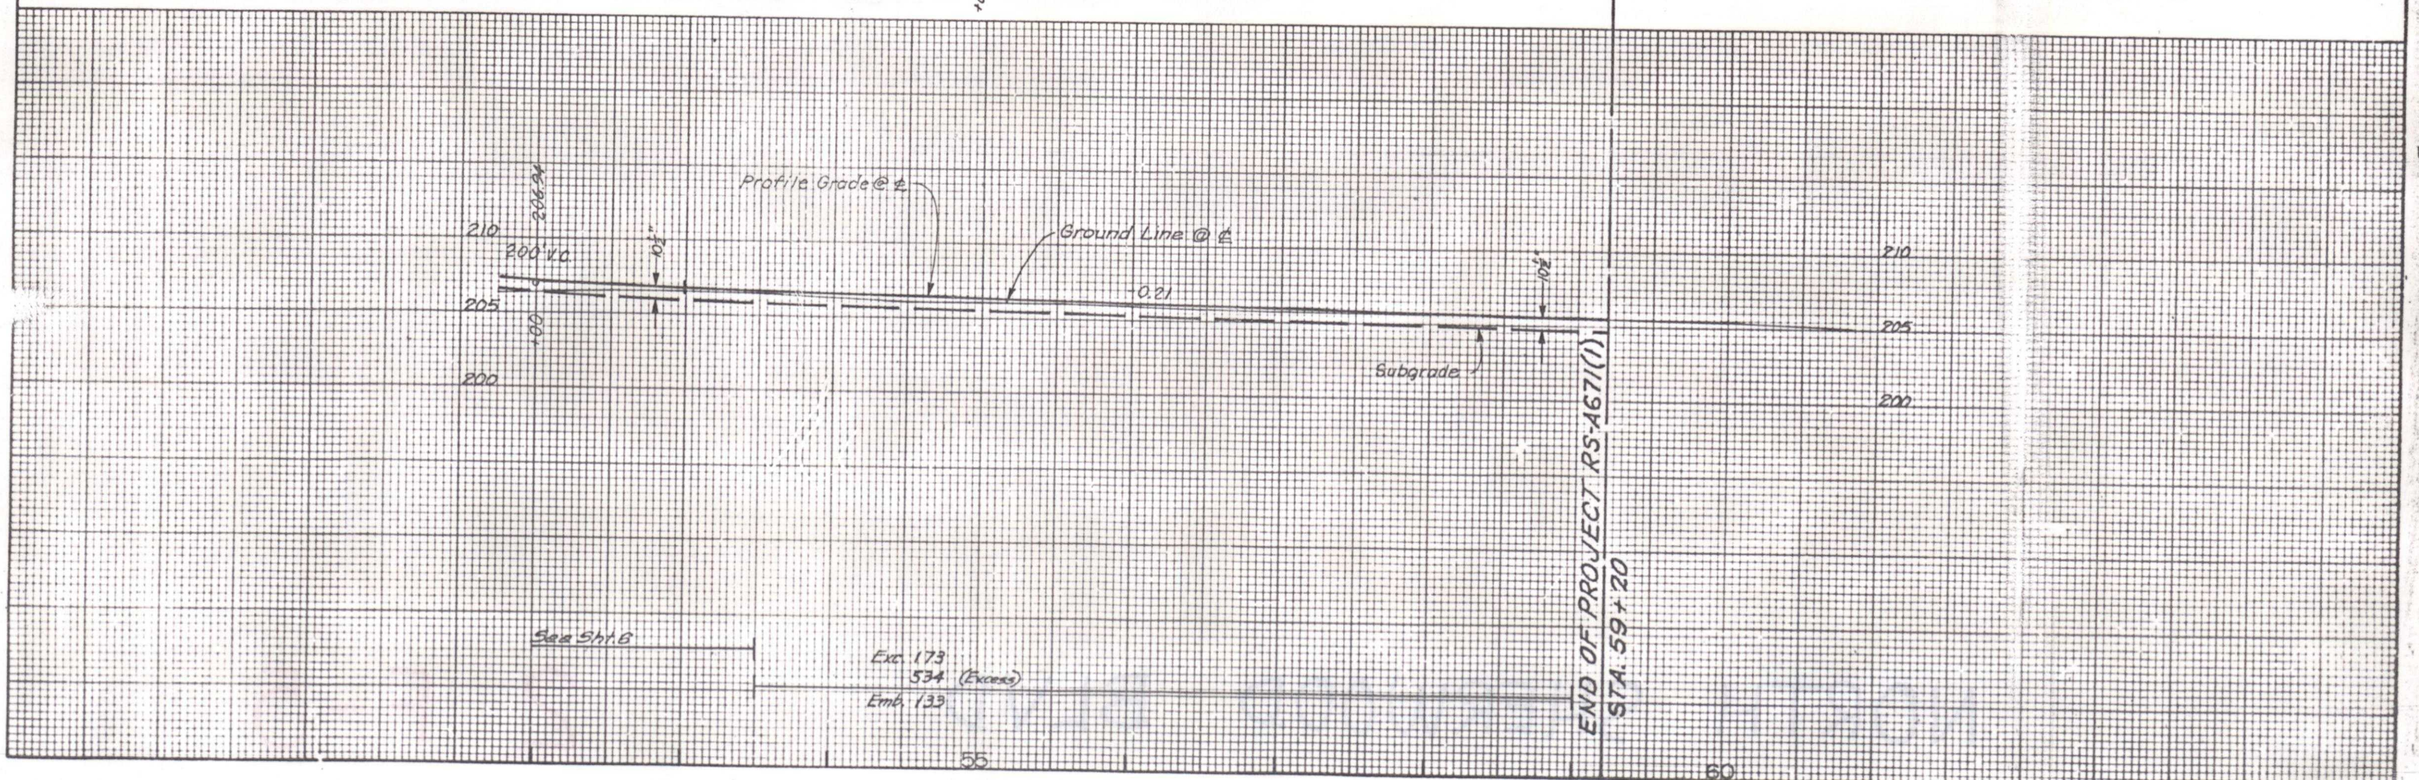

PACIFIC HWY. W.-S.W. 3RD ST. (SHERWOOD) SEC.
FAS A670, A671 (ROCK CR. RD. & N. SHERWOOD BLVD.)
WASHINGTON COUNTY

SHEET No. 7

FED. ROAD Div. No.	STATE	PROJECT NUMBER	FISCAL YEAR	TOTAL SHEETS
10	OREGON	RS-A671(1)		See Index

REVISED AS CONSTRUCTED

Resident Engineer — Date 8-20-19