FED. ROAD DIV. NO.	STATE	FED. AID PROJ. NO.	FISCAL YEAR	SHEET NO.	TOTAL SHEETS
8	WASH.	F003(10)			

DIAGONALS AND VERTICALS

MEMBER	STRESS: DEAD D(Steel)	DEAD D(Conc.)	DEAD D(Total)	LIVE L	IMPACT I	REV. R	ISO* Wind Stress	WIND Direct*	TEMP T	ERECT. E	ERECT. W C.W.	GOVERNING CONDITION D L R W T E ER	DESIGN STRESS	ℓ Feet	r inch	ℓ/r	Allow. Unit Stress	Act. Unit Stress	Area Used Gross	Area Used Net	SECTION	Member
Lo-Portal	+59	-117	-52	(-262 +189	-18 +7	± 74	H_{Lo} = 321	-268	± 27				+19,180	80.6	11.70				86.8		2 Cov.Plts. 24 x $\frac{5}{8}$ (6) 4 L's 8 x 6 x $\frac{5}{8}$, 2 Webs 32 x $\frac{5}{8}$, 2 Plts. 15 x $\frac{5}{8}$ } A 36	Lo-Portal
Portal U1													+ 418	80.6	12.92	74.8	- 14.5	- 6.6	79.7		2 Cov. Plts. 24 x $\frac{5}{8}$ (6) 4 L's 8 x 6 x $\frac{5}{8}$, 2 Webs 32 x $\frac{5}{8}$ } A 36	Portal U1
U1 - L2	-149	+ 16	-127	-193 +123	-28 +16	± 43							- 377	76.5	8.24	111.0	-11.9	- 8.9	42.4		2 Plts. 24 x $\frac{3}{8}$, 2 Webs 24 x $\frac{5}{16}$ (10) } A 36	U1 - L2
L2 - U3	+234	+ 89	+811	+407 +260	+58 +18								+5.35	80.6			+20.0	+18.0	32.0	29.7	2 Plts. 24 x $\frac{3}{8}$ (3), 2 Webs 24 x $\frac{5}{16}$ (6) } A 36	L2 - U3
U3 - L4	-291	-174	-465	-219	-8								- 883	76.5	8.26	111.0	-15.1	-13.3	51.8		2 Plts. 24 x $\frac{5}{8}$, 2 Webs 23 $\frac{5}{8}$ x $\frac{5}{16}$ (10) } A 441	U3 - L4
L4 - U5	+489	+232	+687	+395	+9								+931	80.6			+27.0	+24.0	38.2	35.8	2 Plts. 24 x $\frac{5}{8}$ (3), 2 Webs 24 x $\frac{5}{16}$ (6) } A 441	L4 - U5
U5 - L6	-524	-336	-758	-215	-8								- 981	76.5	9.65	95.6	-16.9	-16.3	60.2		2 Plts. 24 x $\frac{5}{8}$, 4 L's 8 x 4 x $\frac{5}{16}$, 2 Cov. Plts. 24 x $\frac{5}{8}$ (8) } A 440	U5 - L6
L6 - U7	+546	+446	+992	+280	+9								+1251	84.7			+27.0	+26.3	54.3	47.6	2 Plts. 27 x $\frac{5}{8}$ (45), 2 Webs 24 x $\frac{5}{8}$ (6) } A 441	L6 - U7
U7 - L8	-428	-378	-797	-182	-16								- 995	80.5	10.62	91.0	-17.4	-14.9	66.6		2 Plts. 27 x $\frac{5}{8}$, 4 L's 8 x 4 x $\frac{5}{16}$, 2 Cov. Plts. 24 x $\frac{5}{8}$ (8) } A 440	U7 - L8
L8 - U9	+554	+468	+1022	+716	+18								+1269	97.7			+27.0	+24.2	52.6	49.9	2 Plts. 27 x $\frac{5}{8}$ (45), 2 Webs 36 x $\frac{5}{8}$ (6) } A 441	L8 - U9
U9 - L10	-327	-289	-616	-202	-18								-832	93.3	11.62	115.5	-15.8	-15.5	66.6		2 Plts. 27 x $\frac{5}{8}$, 4 L's 8 x 4 x $\frac{7}{16}$, 2 Cov. Plts. 24 x $\frac{5}{8}$ (8) } A 440	L10 - U9
L10 - U11	+535	+432	+967	+272	+18								+1257	78.7			+27.0	+26.4	54.3	47.6	2 Plts. 27 x $\frac{5}{8}$ (44), 2 Webs 24 x $\frac{5}{8}$ (6) } A 441	L10 - U11
U11 - U12	+614	+479	+1093	+281	+20								+1440	78.7			+27.0	+26.9	58.9	52.2	2 Plts. 27 x $\frac{5}{8}$ (45), 2 Webs 24 x $\frac{5}{8}$ (6) } A 441	U11 - U12
U12 - M13	-418	-231	-649	-236	-16		H_{Mg} = 337	-178	± 17				- 846	74.6	10.62	84.2	-18.0	-14.2	66.6		2 Plts. 27 x $\frac{5}{8}$, 4 L's 8 x 4 x $\frac{5}{16}$, 2 Cov. Plts. 24 x $\frac{5}{8}$ (8) } A 440	U12 - M13
M13 - Portal	-543	-278	-820	-254	-17		H_{Mg} = 63	-178	± 17				+1218	74.6	9.95	90.3	-17.6	-14.3	84.9		2 Plts. 27 x $\frac{5}{8}$, 4 L's 8 x 4 x $\frac{5}{8}$, 4 Plts. 6 x $\frac{5}{8}$, 4 L's 8 x 4 x $\frac{5}{8}$ } A 440, 2 Cov. Pls. 35 x $\frac{5}{8}$ (6) A 441	M13 - Portal
Portal L14													-1375 lbs.	74.6					142.7		2 Plts. 27 x $\frac{5}{8}$, 4 L's 8 x 4 x $\frac{5}{8}$, 4 Plts. 6 x $\frac{5}{8}$, 4 L's 8 x 4 x $\frac{5}{8}$, 2 Plts. 11 x $\frac{5}{8}$ } A 440, 2 Cov. Pls. 38 x $\frac{5}{8}$ (6) A 441	Portal L14
L14 - Portal	-889	-468	-1146	-222	-13		H_{Mg} = 63	-93	± 25				-1825 lbs.	78.5	9.93	94.7	17.0	16.0	131.0		6 Plts. 27 x $\frac{5}{8}$, 4 L's 8 x 4 x $\frac{5}{8}$, 4 L's 8 x 4 x $\frac{5}{8}$, 2 Plts. 11 x $\frac{5}{8}$ } A 440, 2 Cov. Pls. 38 x $\frac{5}{8}$ (6) A 441	L14 - Portal
Portal M15													-1825 lbs.	78.5					84.9			Portal M15
M15 - U16	-542	-409	-951	-241	-14		H_{Mg} = 463	-93	± 25				- 1490	78.5	10.68	88.5	-17.6	-16.4	66.0		2 Plts. 27 x $\frac{5}{8}$, 4 L's 8 x 4 x $\frac{5}{8}$, 2 Cov. Plts. 24 x $\frac{5}{8}$ (8) } A 440	M15 - U16
U16 - M17	+951	+702	+1653	+334	+12								+1789	75.1			+27.0	+26.2	66.0	58.7	2 Plts. 27 x $\frac{5}{8}$ (45), 4 L's 8 x 4 x $\frac{5}{8}$ (24), 2 Cov. Plts. 24 x $\frac{5}{8}$ (8) } A 440	U16 - M17
M17 - L18	+668	+664	+1332	+316	+12								+1650	78.1			+27.0	+26.1	75.2	63.0	2 Plts. 27 x $\frac{5}{8}$ (45), 4 L's 8 x 4 x $\frac{5}{8}$ (24), 2 Cov. Plts. 24 x $\frac{5}{8}$ (8) } A 440	M17 - L18
L18 - U19	-514	-541	-1056	-270	-10								- 1838	97.0	10.6	110.0	-18.3	-15.2	87.7		2 Plts. 27 x $\frac{5}{8}$, 4 L's 8 x 6 x $\frac{5}{8}$, 2 Cov. Plts. 24 x $\frac{5}{8}$ (6) } A 440	L18 - U19
U19 - L20	+692	+695	+1387	+318	+12								+1717	94.8			+27.0	+26.3	77.4	65.0	2 Plts. 27 x $\frac{5}{8}$ (48), 4 L's 8 x 4 x $\frac{5}{8}$ (24), 2 Cov. Plts. 24 x $\frac{5}{8}$ (8) } A 440	U19 - L20
L20 - U21	-630	-646	-1276	-300	-12								- 1567	88.7	10.72	93.6	-17.1	-16.9	94.1		2 Plts. 27 x $\frac{5}{8}$, 4 L's 8 x 6 x $\frac{5}{8}$, 2 Cov. Plts. 24 x $\frac{5}{8}$ (6) } A 440	L20 - U21
U21 - L22	+678	+686	+1365	+326	+15								+1625	81.7			+27.0	+26.9	71.8	60.2	2 Plts. 27 x $\frac{5}{8}$ (48), 4 L's 8 x 4 x $\frac{5}{8}$ (24), 2 Cov. Plts. 24 x $\frac{5}{8}$ (8) } A 440	U21 - L22
L22 - U23	-607	-559	-1166	-284	-15								- 1465	78.3	11.02	86.2	-17.8	-17.4	99.0		2 Plts. 27 x $\frac{5}{8}$, 4 L's 8 x 6 x $\frac{5}{8}$, 2 Cov. Plts. 24 x $\frac{5}{8}$ (8) } A 440	L22 - U23
L23 - U24	-510	-441	-951	-257	-14								- 1332	79.1	10.90	87.0	-17.7	-17.0	92.1		2 Plts. 27 x $\frac{5}{8}$, 4 L's 8 x 6 x $\frac{5}{8}$, 2 Cov. Plts. 24 x $\frac{5}{8}$ (6) } A 440	U24 - L25
U24 - L25	+400	+386	+742	+228	+13								+980	78.0			+27.0	+26.3	41.1	37.3	2 Plts. 24 x $\frac{5}{8}$ (44), 2 Webs 24 x $\frac{5}{8}$ (6) } A 441	U24 - L25
L25 - U26	-290	-238	-528	-200	-12								- 740	78.9	9.64	98.3	-16.6	-13.4	55.2		2 Plts. 24 x $\frac{5}{8}$, 4 L's 8 x 4 x $\frac{5}{16}$, 2 Cov. Plts. 24 x $\frac{5}{8}$ (8) } A 440	U26 - L27
U26 - L27	+178	+158	+333	+177	+11								+651	78.3			+18.0	+17.4	52.4	36.1	2 Plts. 24 x $\frac{5}{8}$ (3), 2 Webs 25 x $\frac{5}{8}$ (6) } A 36	L27 - U26
L27 - U28	-57	-44	-101	-152 +180	± $\frac{5}{8}$	± 19							- 281	78.6	9.37	112.5	-11.8	-7.0	33.8		2 Plts. 24 x $\frac{5}{16}$, 8 Webs 24 x $\frac{5}{16}$ (10) } A 36	
L12 - U12 L16 - U16	+283	+161	+444	+36	+15								+356	68.7			+27.0	+19.3	31.6	28.8	2 Plts. 18 x $\frac{5}{8}$ (23), 1 Web 24 x $\frac{5}{8}$ } A 441	L12 - U12 L16 - U16
L23 - U23	+586	+443	+828	+237	+15				+591				+1177	68.0			+27.0	+26.3	49.8	44.8	2 Plts. 24 x $\frac{5}{8}$ (14), 2 Webs 24 x $\frac{5}{8}$ (6) } A 441	L23 - U23
L9 - U9 L19 - U19	+64	+81	+145	+65	+20								+230	89.5			+27.0	+19.6	22.0	21.7	2 Plts. 20 x $\frac{5}{8}$ (33), 1 Web 24 x $\frac{5}{8}$ (12) } A 441	L9 - U9 L19 - U19
Others														92.0			+27.0	+13.0	20.0	17.7	2 Plts. 16 x $\frac{5}{8}$ (33), 1 Web 24 x $\frac{5}{16}$ (12) } A 441	Others
U10 - Portal	-2810	-1485	-5359	-691	-18		H_{Mg} = 890 H_{Mg} = 28	+1114	STA				-9789 -13864	82.2	10.70	95.7	-16.9	-14.1	282.8		2 Cov. Plts. 24 x $\frac{5}{8}$ (6), 4 L's 8 x 6 x $\frac{5}{8}$, 6 Webs 32 x $\frac{5}{16}$, 2 Plts. 15 x $\frac{5}{16}$, 2 Plts. 29 x $\frac{5}{16}$ } A 440	U10 - Portal
Portal L14													-13864	82.0					260.8		2 Cov. Plts. 38 x $\frac{5}{8}$ (6) A 441, 4 L's 8 x 6 x $\frac{5}{8}$, 6 Webs 32 x $\frac{5}{16}$, 4 L's 8 x 4 x $\frac{5}{8}$ } A 440	Portal L14
L8 - U8 L20 - U20														77.3					34.2		2 Plts. 18 x $\frac{5}{16}$, 1 Web 24 $\frac{5}{8}$ x $\frac{5}{16}$ (12)	L8 - U8 L20 - U20
M13 - U13 M15 - U15														82.6					28.9		2 Plts. 20 x $\frac{5}{8}$, 1 Web 24 $\frac{5}{8}$ x $\frac{5}{16}$ (12)	M13 - U13 M15 - U15
Others														67.6					19.9		2 Plts. 16 x $\frac{5}{8}$, 1 Web 24 $\frac{5}{8}$ x $\frac{5}{16}$ (12)	Others
M-Struts																			14.7		2 Plts. 14 x $\frac{5}{16}$, 1 Web 25 $\frac{5}{8}$ x $\frac{5}{16}$ (12)	M-Struts
Sub Diag.	-135	-55	-190	-45	-13								-848	78.7	8.37	118.5	-11.8	-6.2	59.9		2 Plts. 24 x $\frac{5}{16}$, 2 Webs 24 $\frac{5}{8}$ x $\frac{5}{16}$ (10)	Sub Diag.
M13 - M15	+200	+122	+322	+56	+2								+378	49.4			+27.0	+19.8	16.3	14.4	2 Plts. 14 x $\frac{7}{16}$ (23), 1 Web 25 x $\frac{5}{16}$ (12) A 441	M13 - M15

Hangers

Posts

exc. M13-M15

*Direct wind stress does not include effect of Portal Sheers and is given for Lee truss.

Note: All stresses in trusses are given with M13 - M14 not acting.

FOR INFORMATION ONLY

1-64 As Constructed

U.S. HIGHWAY NO. 101
COLUMBIA RIVER BRIDGE
ASTORIA, OREGON - PT. ELLICE, WASHINGTON
SUPERSTRUCTURE CONTRACT

STRESS SHEET-WEB MEMBERS
MAIN TRUSS

WASHINGTON STATE HIGHWAY COMMISSION
DEPARTMENT OF HIGHWAYS
OLYMPIA, WASHINGTON

SHEET 16 OF 64 SHEETS 17716

FED. ROAD DIV. NO.	STATE	FED. AID PROJ. NO.	FISCAL YEAR	SHEET NO.	TOTAL SHEETS
8	WASH.	F003-1(16)			

GEOMETRIC LENGTHS

14 @ 44'-0" = 616'-0"

PORTAL & BENT AT L0 (Shown developed)

SWAY FRAME AT U3, U7, U11, U15, U19, U23, U27 & U28

PORTAL AT U18-L18 & L18-U18 (Shown developed)

PORTAL AT L18-U18

CAMBER LENGTHS

Top Struts except at U1, U13, U14 & U16: 2 Rds. 12" x 5/8" I-Web 36 1/2" x 5/8" (18"x28" Holes)

Cambered length. Initial length for Erection. Horiz. dim.

TOWER

TOP VIEW

Top Laterals: 2 Rds. 12" x 5/8", I-Web 32" x 7/16" (18"x28" Holes in Web)

Bot. Laterals: 2 Rds. 14" x 5/8", I-Web 32" x 7/16" (18"x28" Holes in Lateral Web)

NOTE: Lateral stresses shown are for 150# wind.

SECTION A-A

Concrete D.L. Camber

Steel D.L. Camber

Vertical Curve

DEAD LOAD CAMBER

All dimensions in feet.

FOR INFORMATION ONLY

U.S. HIGHWAY NO. 101
COLUMBIA RIVER BRIDGE
ASTORIA, OREGON - PT. ELLICE, WASHINGTON
SUPERSTRUCTURE CONTRACT

TRUSS DIMENSIONS
MAIN TRUSS

WASHINGTON STATE HIGHWAY COMMISSION
DEPARTMENT OF HIGHWAYS
OLYMPIA, WASHINGTON

SHEET 17 OF 64 SHEETS

17717

1-67 As Constructed

FED. ROAD DIV. NO.	STATE	FED. AID PROJ. NO.	FISCAL YEAR	SHEET NO.	TOTAL SHEETS
X	WASH.	I-005-1(10)			

U. S. HIGHWAY NO. 101
COLUMBIA RIVER BRIDGE
ASTORIA, OREGON - PT. ELLICE, WASHINGTON
SUPERSTRUCTURE CONTRACT

FL. BM. & ROCKER BENT AT Lo
MAIN TRUSS

WASHINGTON STATE HIGHWAY COMMISSION
DEPARTMENT OF HIGHWAYS
OLYMPIA, WASHINGTON

SHEET 16 OF 84 SHEETS 17718

FOR INFORMATION ONLY

I-67 As Constructed

SECTION "G-G"

SECTION "F-F"

SECTION "C-C"

SECTION "B-B"

PART SECTION "D-D"

PINS
8 Required
Forged Steel A.S.T.M. A-235 Class "G"

Note: Stringers raised to give 3/8" straight chord under full dead load (D.L. defl. of Fl. Bm. @ stringer indicated by "+")

Notes:
All rivets 7/8" except as noted.
Hand Holes & Man Holes as shown.
Floor-beam welding sequence: Wind tongue & End haunch web & flanges to main beam flanges, flange Rs. to web, stiffeners to web & flanges.
For purposes of payment forgings shall be classified as "Miscellaneous Metal"

Note: Procedure for grouting of wind tongue bearings:
1. Place 1/8" shims btwn. wind tongue and Brg. R.
2. Wedge Brg. R. tight against shims.
3. Pour non-shrinking grout under Brg. R.
4. Remove shims.

FED. ROAD DIV. NO.	STATE	FED. AID PROJ. NO.	FISCAL YEAR	SHEET NO.	TOTAL SHEETS
8	WASH.	F-003-1(10)			

6"x12" H.N. @ 3'-0" c-c. (1'-8" o.c. Min.) Bot. only

Typ. Diaph.

1 PL 15"x 5/16" A-441

2-Cov. Pls 24"x 5/16" 4-Ls 8"x6"x 7/16" 2-Webs 32"x 5/16"

1 PL 3/4" A-441

Slot H.S. Stiff. & Diaph. Fig. 2.5 Fin. E.

10" Bore 8"+1/16" for 8" Class "G" pin.

L0

2 Ls 6"x4"x 7/16" 12"x 24" M.H. 1 PL 15"x 5/16" A-441 5'-2" 1'-8" Min. 5/8" Max. L 6"x4"x 5/16" A-440 2 Lat. Rfs. 5/16" A-441 (2'-8 1/2" in-in)

Lat's. L0-L1 2 Rfs. 14"x 5/16" 1-Web 32"x 5/16" A-36 18"x 28" Holes in Web, see U1

2-Rfs. 14"x 5/16" A-441

1-Fill 15"x 5/16"

1-R. 3/4" A-441

1-Fill 15"x 5/8"

1-R. 7"x 1/2" A-36

L1

For Access platform see L5-L6 sheet For Ladder details see Light access Ladder & Railforms @ Br. See Dwg. 17746

Gutter Line

End of F.S. Fill

2-Gus. Pls 24"x 5/16" (2'-1 1/2" in-in)

2-Rfs. 16"x 5/16" 1-Web 28"x 5/16" A-441

4'-0" Typ. except 4'-7 1/2" @ L1 & L2

Typ. Diaph.

L2

12"x 22" Holes

4'-0" Min. 4'-6" c-c. Max.

2-Rfs. 16"x 5/16" 1-Web 28"x 5/16" A-441 Slope View same as for Hanger @ L1

2-Rfs. 14"x 5/16" (10 1/2" Holes) 1-Web 28"x 5/16" (6 1/2" Holes) End Details same as for U3-L3

2-Rfs. 14"x 5/16" (10 1/2" Holes) 1-Web 28"x 5/16" (6 1/2" Holes) Top View same as @ U3

N.S. only

1-L 4"x 6"x 5/16" F.S. 1-L 4"x 6"x 5/16" A-440 N.S.

2-Gus. Pls 5/16" A-440 (2'-1 1/2" in-in)

2-Cov. Pls 24"x 5/16" 4-Ls 8"x 6"x 7/16" 2-Webs 32"x 5/16"

Typ. Diaph.

L3

Same as L1 except 1/2" Fill under Lat. Rfs. (2'-8 1/2" in-in) & 15"x 5/16" Fills on Laterals.

L4

2-Rfs. 14"x 5/16" (10 1/2" Holes) 1-Web 28"x 5/16" (6 1/2" Holes) Top View same as @ U3

2-Rfs. 16"x 5/16" 1-Web 28"x 5/16" A-441 Slope View same as for Hanger @ L1

2-Rfs. 16"x 5/16" 2-Webs 32"x 5/16" A-441 6 1/2" Holes in Web as for L1-U3 @ U3

2 Fills 1/2"

2 Fills 32"x 1/2"

Typ. Diaph.

1-Fill 24"x 1/2"

1-Bar 4"x 3/8" 12"x 24" M.H. 1-Spl. R. 24"x 3/8" A-440

Lat. Conn. same as for L2

1-Fill 24"x 5/8"

1-Spl. R. 24"x 5/8" A-440

1-Bev. Fill 5/8" av.

1-R. 7"x 1/2" A-36

1-Spl. R. 5/8" A-440 F.S.

1-Lat. R. 5/8" A-441 N.S. (2'-9" in-in)

2-Rfs. 16"x 5/16" A-440

LAT. INTERSECTION L1-L6

Notes:
Rivets 7/8" ø except Diagonal connections 1" ø as noted.
Hand Holes in chords 6"x 12" @ 3'-0" c-c, 2'-8" Min.
Tack Weld all loose fills.
For typ. diaphs. and weld details see L6-U6 Dwg. 17731

FOR INFORMATION ONLY

I-67 As Constructed

U. S. HIGHWAY NO. 101
COLUMBIA RIVER BRIDGE
ASTORIA, OREGON - PT. ELLICE, WASHINGTON
SUPERSTRUCTURE CONTRACT

TRUSS DETAILS L0 to L4
MAIN TRUSS

WASHINGTON STATE HIGHWAY COMMISSION
DEPARTMENT OF HIGHWAYS
OLYMPIA, WASHINGTON

SHEET 12 OF 64 SHEETS 17719

RECD FYI MAR 19 1958
MAR 19 1958
26

FED. ROAD DIV. NO.	STATE	FED. AID PROJ. NO.	FISCAL YEAR	SHEET NO.	TOTAL SHEETS
8	WASH.	[illegible]			

PLAN - NAVIGATION LIGHT ACCESS PLATFORM AT L7 & L28, L1 & L1'

(6" Rad'l.) Note: No platform @ L1' Platform one side only @ L1 & L1'

SECTION "A-A" @ L1 & L1'

L5

Same as L1 except ¾" fills under Lot R (23 lbs/in) & 15x¾ Fills on Lots. 4 2.2" in/in Gus. R's.

Notes:

Rivets ¾" ø @ L6 & L7 except diagonal connections @ L6, 1" ø Rivets. Rivets 1" ø except ¾" ø in Lot Conn's. & as noted @ L8.

Hand holes in chords 6"x12" @ 8'-0" c/c, 2'-8" min. Tack weld all loose fills.

For typ. diaph's. and weld details see U2-U6, Dwg. 17731

L6

L7

L8

FOR INFORMATION ONLY

1-67 As Constructed

U.S. HIGHWAY NO. 101
COLUMBIA RIVER BRIDGE
ASTORIA, OREGON - PT. ELLICE, WASHINGTON
SUPERSTRUCTURE CONTRACT

TRUSS DETAILS L5 to L8
MAIN TRUSS

WASHINGTON STATE HIGHWAY COMMISSION
DEPARTMENT OF HIGHWAYS
OLYMPIA, WASHINGTON

SHEET 8.0 OF 84 SHEETS 17720

FED. ROAD DIV. NO.	STATE	FED. AID PROJ. NO.	FISCAL YEAR	SHEET NO.	TOTAL SHEETS
8	WASH.	FOOS 1(16)			


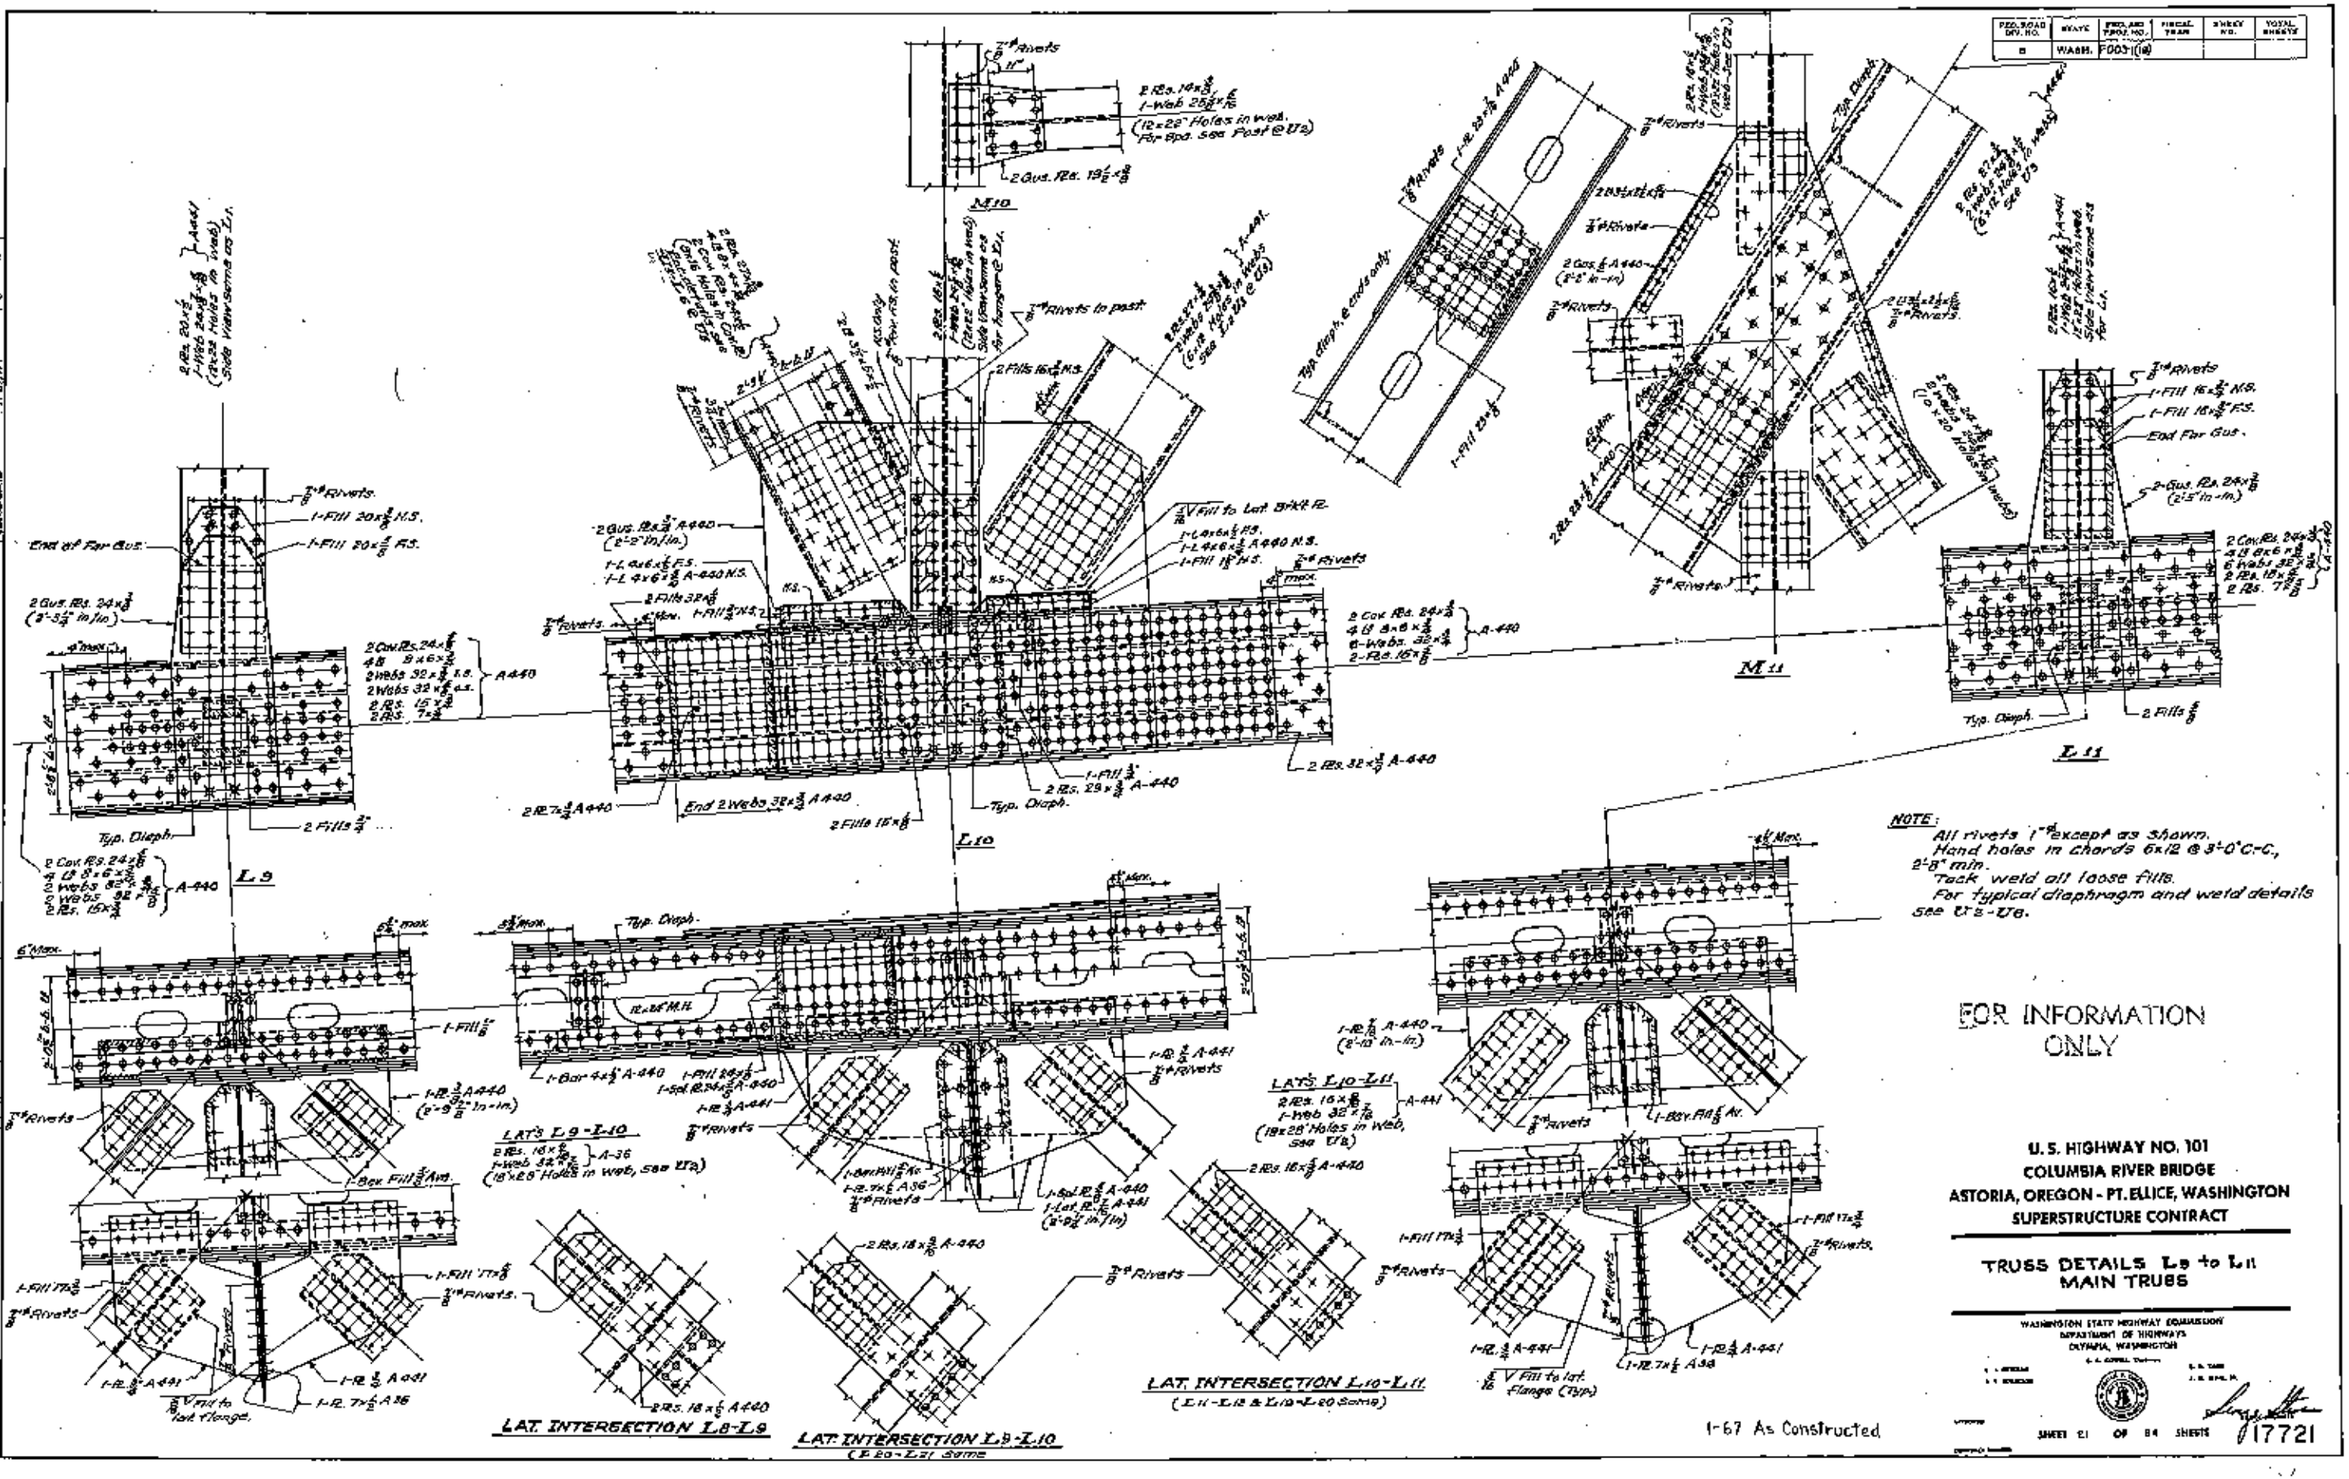

FOR INFORMATION ONLY

U. S. HIGHWAY NO. 101
COLUMBIA RIVER BRIDGE
ASTORIA, OREGON - PT. ELLICE, WASHINGTON
SUPERSTRUCTURE CONTRACT

MAIN TRUSS

WASHINGTON STATE HIGHWAY COMMISSION
DEPARTMENT OF HIGHWAYS
OLYMPIA, WASHINGTON

SHEET 21 OF 84 SHEETS 17721

1-67 As Constructed

FED. ROAD DIV. NO.	STATE	FED. AID PROJ. NO.	FISCAL YEAR	SHEET NO.	TOTAL SHEETS
5	WASH.	F003-1(6)			

M12

L12

L13

Lat Intersect L12-L13
(L13-L14 same)

Note:
All rivets ⅞" ø except as shown.
Hand holes in chords 6"x18"@3'-0" & 24" min.
For Typ. Diaph. & web details see U2-U3, Dwg. 17731.
Tack weld all loose fills.

FOR INFORMATION ONLY

U. S. HIGHWAY NO. 101
COLUMBIA RIVER BRIDGE
ASTORIA, OREGON - PT. ELLICE, WASHINGTON
SUPERSTRUCTURE CONTRACT

TRUSS DETAILS M12 & L12 to L13
MAIN TRUSS

WASHINGTON STATE HIGHWAY COMMISSION
DEPARTMENT OF HIGHWAYS
OLYMPIA, WASHINGTON

I-67 As Constructed

SHEET 82 OF 84 SHEETS

17722

FED. ROAD DIV. NO.	STATE	FED. AID PROJ. NO.	FISCAL YEAR	SHEET NO.	TOTAL SHEETS
8	WASH.	F003-1(14)			

FOR INFORMATION ONLY

U.S. HIGHWAY NO. 101
COLUMBIA RIVER BRIDGE
ASTORIA, OREGON - PT. ELLICE, WASHINGTON
SUPERSTRUCTURE CONTRACT

TRUSS DETAILS AT L14 MAIN TRUSS

WASHINGTON STATE HIGHWAY COMMISSION
DEPARTMENT OF HIGHWAYS
OLYMPIA, WASHINGTON

SHEET 83 OF 84 SHEETS 17723

NOTES:
Rivets 1" except in U12-L14 as noted.
Hand holes in chords and diagonals 6"x12" @ 3'0" C-C, 2'-8" minimum.
Tack weld all loose fills.
For typ. diaphs and weld details see U2-U6.
As Constructed 1-67
Revised Sus. & material 7-3-63

SECTION A-A
Typ. Stringer Conn.

SECTION B-B

SECTION C

VIEW "D-D"
(View E-E Similar)

See upper part of tower Dwg. 17748

FED. ROAD DIV. NO.	STATE	FED. AID PROJ. NO.	FISCAL YEAR	SHEET NO.	TOTAL SHEETS
8	WASH.				

M18 (See M17)

L15

L16

L17

M17

Lat. Intersection L15-L16
Same as L14-L15

Lat. Intersection L16-L17
Same of L15-L16, L17-L18.

Note:
All rivets 3/4"ø @ L15M17 except as shown.
All rivets 1"ø @ L16-L16 except as shown.
Hand holes in chords 6"x12"@ 3'-0"c-c, 2'-0" Min.
For Typ. Diaph. & Welding details see U2-U6 sheet, Dwg. 17731.
Tack weld all loose fills.

FOR INFORMATION ONLY

U. S. HIGHWAY NO. 101
COLUMBIA RIVER BRIDGE
ASTORIA, OREGON - PT. ELLICE, WASHINGTON
SUPERSTRUCTURE CONTRACT

TRUSS DETAILS L15 to L17 & M18 to M17
MAIN TRUSS

WASHINGTON STATE HIGHWAY COMMISSION
DEPARTMENT OF HIGHWAYS
OLYMPIA, WASHINGTON

SHEET 24 OF 64 SHEETS

17724

I-67 As Constructed

FED. ROAD DIV. NO.	STATE	FED. AID PROJ. NO.	FISCAL YEAR	SHEET NO.	TOTAL SHEETS
8	WASH.	7003-1(16)			

M18
(See M10)

Stairs and Platforms on East Truss only.

SECTION C-C
(See Stairway & U16 for details not shown)

SECTION B-B

SECTION V-V

L19

L18

LATS L16-L18
2 Rds. 16 x 5/8 } A441
1-Web 32 x 5/16
(For Lat. Intersect. See L16-L18)

LATS L18-L19
2 Rds. 15 x 5/8 } A441
1-Web 32 x 5/16
(For Lat. Intersect. See L18)

LATS L18-L20
2 Rds. 18 x 5/8 } A441
1-Web 32 x 5/16
(For Lat Intersect. See L18-L20)

Notes:
All rivets 7/8" ø L18 except as noted.
Hand holes in chords 6"x12" @ 3'-0" c-c. (2'-8" min.)
Tack weld all loose fills.
For Typ. Diaph. & Weld Details see U2-U6, Dwg. 17731

Platform:
Weld floorplates to ℄ with 5/16" weld 2" long @ 6" ctrs. Rail posts & rails shall be joined with 5/16" continuous welds. All other welds as noted.
All floor plates shall have a raised pattern.

FOR INFORMATION ONLY

1-67 As Constructed

U.S. HIGHWAY NO. 101
COLUMBIA RIVER BRIDGE
ASTORIA, OREGON - PT. ELLICE, WASHINGTON
SUPERSTRUCTURE CONTRACT

TRUSS DETAILS M18 & L18 to L19
MAIN TRUSS

WASHINGTON STATE HIGHWAY COMMISSION
DEPARTMENT OF HIGHWAYS
OLYMPIA, WASHINGTON

SHEET 29 OF 84 SHEETS

17725

FED. ROAD DIV. NO.	STATE	FED. AID PROJ. NO.	FISCAL YEAR	SHEET NO.	TOTAL SHEETS
8	WASH. F003(16)				

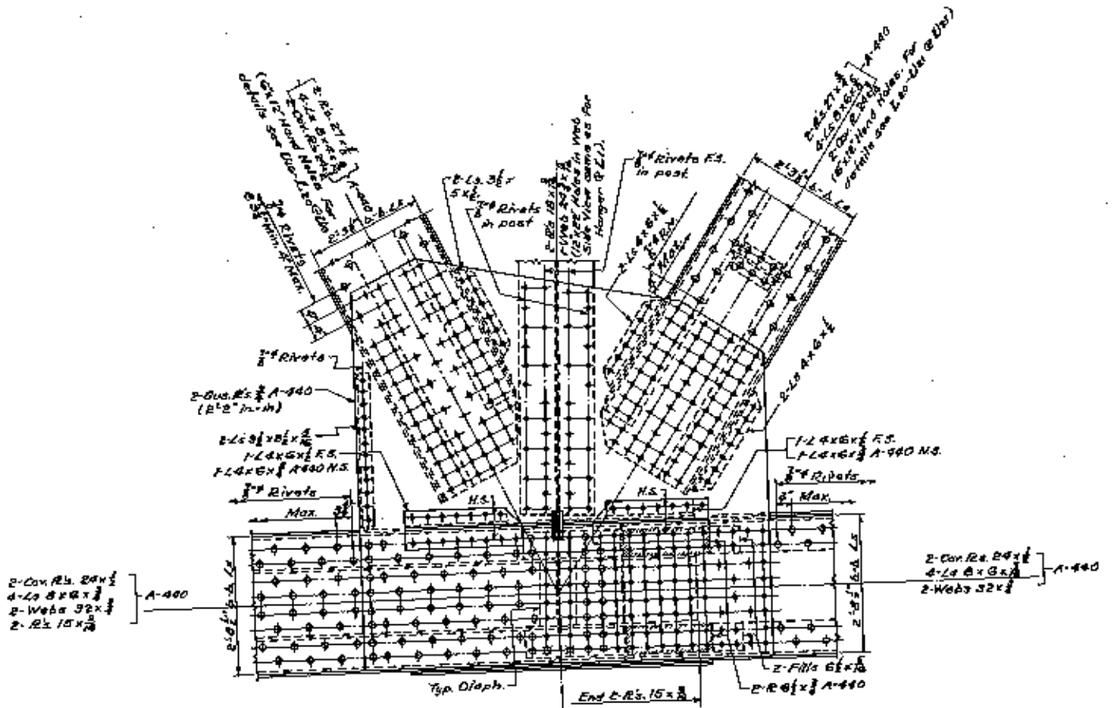

U. S. HIGHWAY NO. 101
COLUMBIA RIVER BRIDGE
ASTORIA, OREGON - PT. ELLICE, WASHINGTON
SUPERSTRUCTURE CONTRACT

TRUSS DETAILS L20 to L21
MAIN TRUSS

WASHINGTON STATE HIGHWAY COMMISSION
DEPARTMENT OF HIGHWAYS
OLYMPIA, WASHINGTON

SHEET 28 OF 64 SHEETS 17726

I-67 As Constructed

FED. ROAD DIV. NO.	STATE	FED. AID PROJ. NO.	FISCAL YEAR	SHEET NO.	TOTAL SHEETS
6	WASH.	P0031(16)			

LATERAL INTERSECTION

SECTION "A-A"

L 22

L 23

NOTES

Rivets 1"ϕ except ⅞"ϕ in Lat. Conn's and as noted.
Handholes 6x12 @ 3'-0" C/c, 2'-8" min.
Tackweld all loose Fills.
For typical diaphragms and welding details see U2-U6, Dwg. 17731. For final adjustment of jacking member plates "P" and Holes "E" See U23 - U24 except: Dwg. 17738.
2. Fill Space "A" with D+0.048 (T-65) inches of shims for T≥65°F & D=0.048 (65-T) inches of shims for T≤63°F
3. Machine R. "P" to a width of 8" minus shims inserted in space "A".

FOR INFORMATION ONLY

U. S. HIGHWAY NO. 101
COLUMBIA RIVER BRIDGE
ASTORIA, OREGON - PT. ELLICE, WASHINGTON
SUPERSTRUCTURE CONTRACT

TRUSS DETAILS L22 to L23
MAIN TRUSS

WASHINGTON STATE HIGHWAY COMMISSION
DEPARTMENT OF HIGHWAYS
OLYMPIA, WASHINGTON

1-67 As Constructed

SHEET 27 OF 64 SHEETS 17727

FED. ROAD DIV. NO.	STATE	FED. AID PROJ. NO.	FISCAL YEAR	SHEET NO.	TOTAL SHEETS
5	WASH.	P0031(6)			

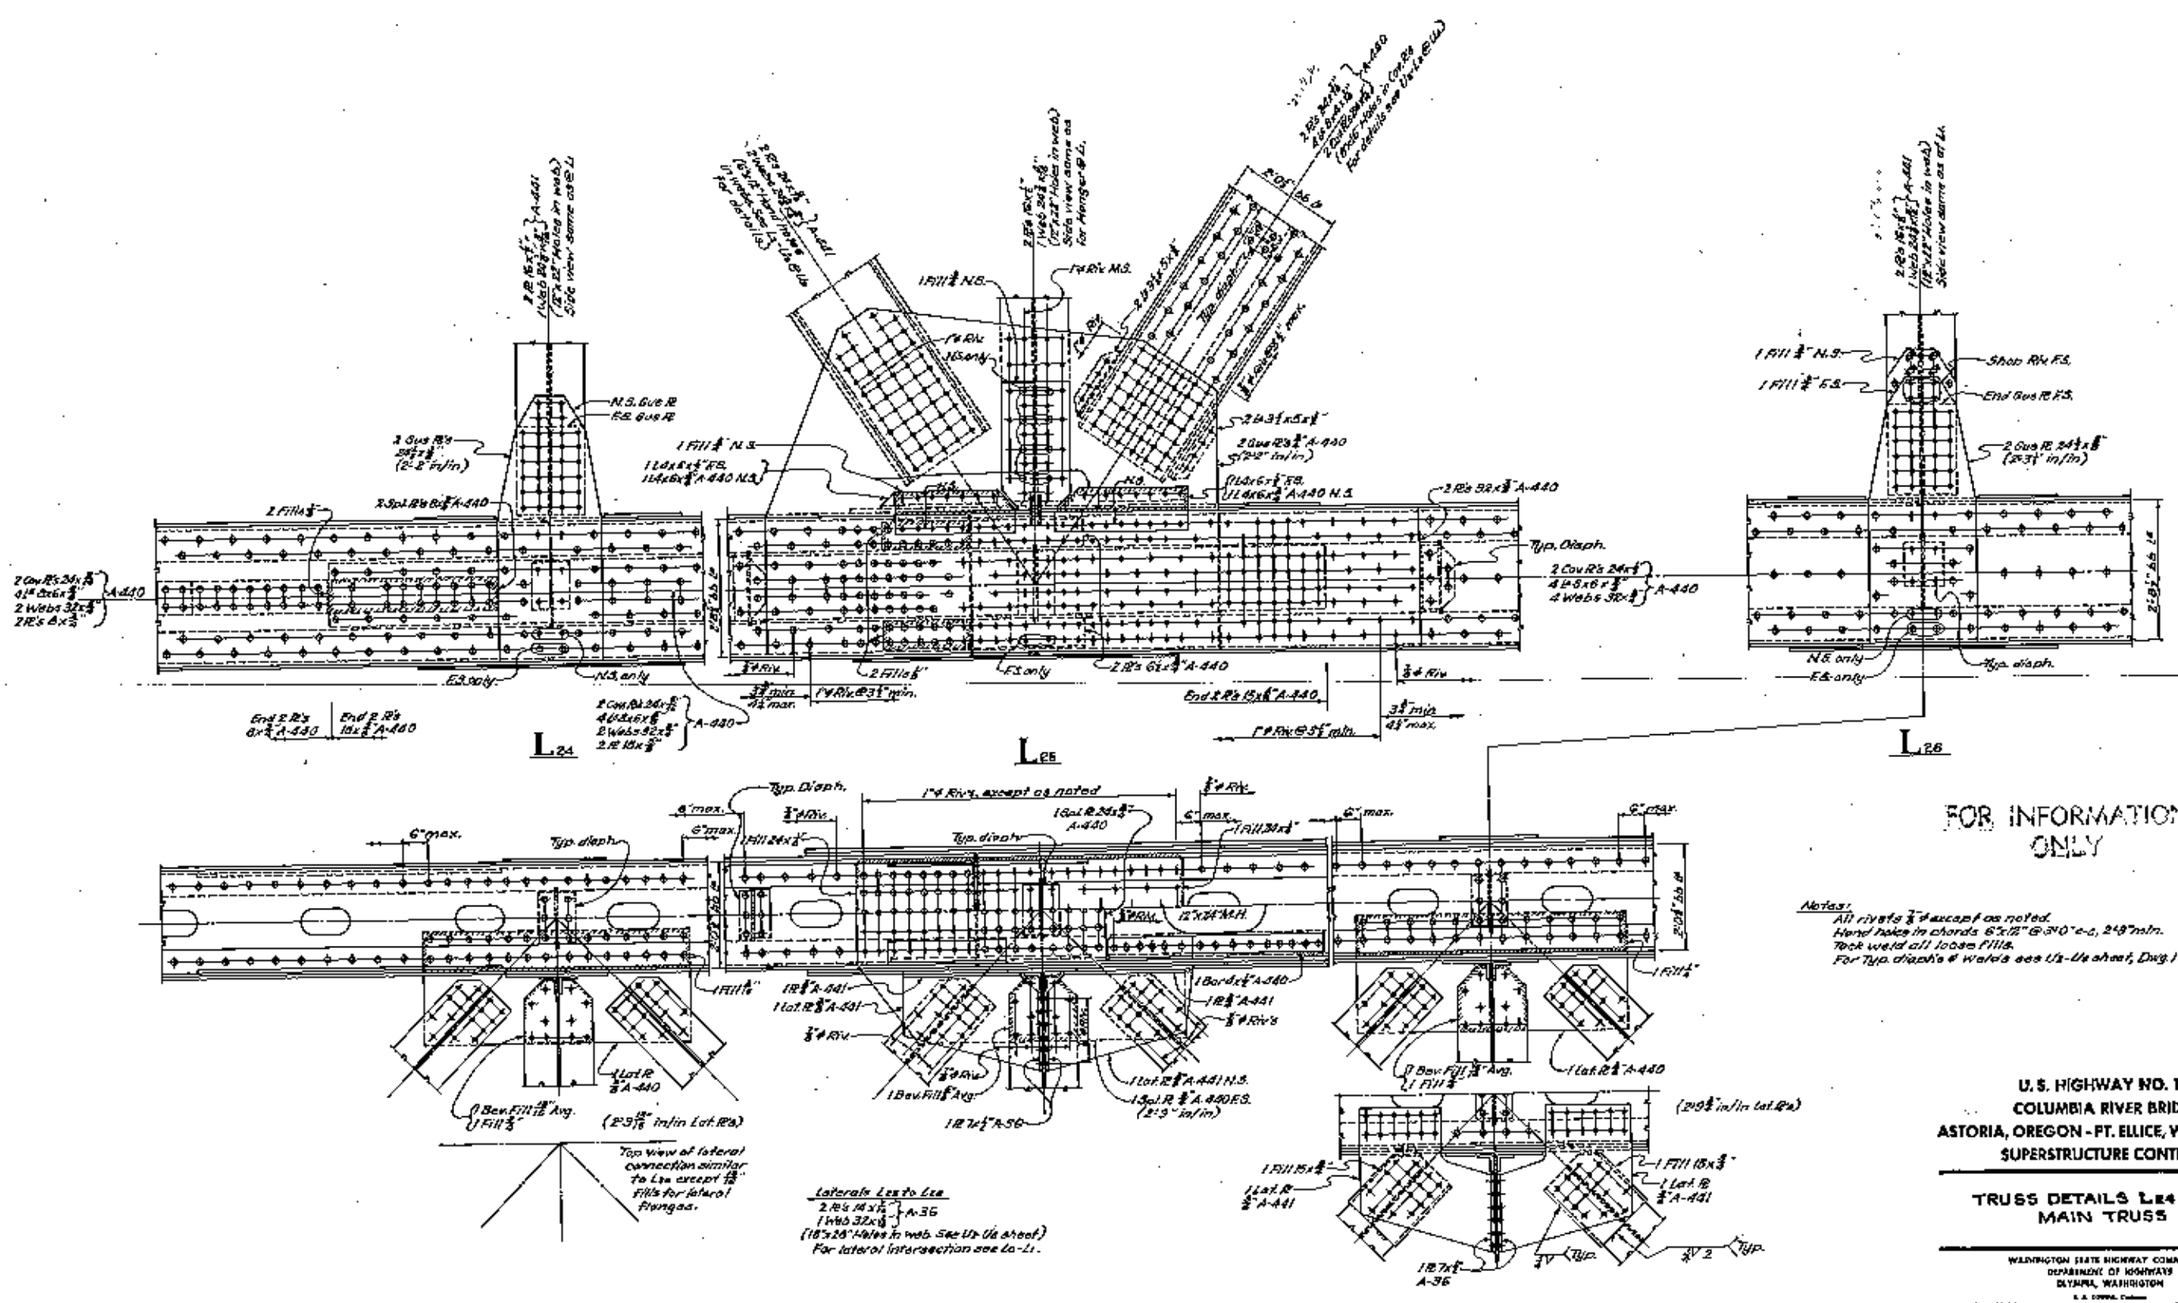

FOR INFORMATION ONLY

Notes:
All rivets 3/4" ϕ except as noted.
Horiz holes in chords 6"x18" @ 30" c-c, 24" min.
Tack weld all loose fills.
For Typ. diaph's & Webs see U1-U2 sheet, Dwg. 17731

U.S. HIGHWAY NO. 101
COLUMBIA RIVER BRIDGE
ASTORIA, OREGON - FT. ELLICE, WASHINGTON
SUPERSTRUCTURE CONTRACT

TRUSS DETAILS L24 to L26
MAIN TRUSS

WASHINGTON STATE HIGHWAY COMMISSION
DEPARTMENT OF HIGHWAYS
OLYMPIA, WASHINGTON

SHEET 55 OF 84 SHEETS 17728

I-67 As Constructed

FED. ROAD DIV. NO.	STATE	FED. AID PROJ. NO.	FISCAL YEAR	SHEET NO.	TOTAL SHEETS
8	WASH.	I-(10)-1(16)			

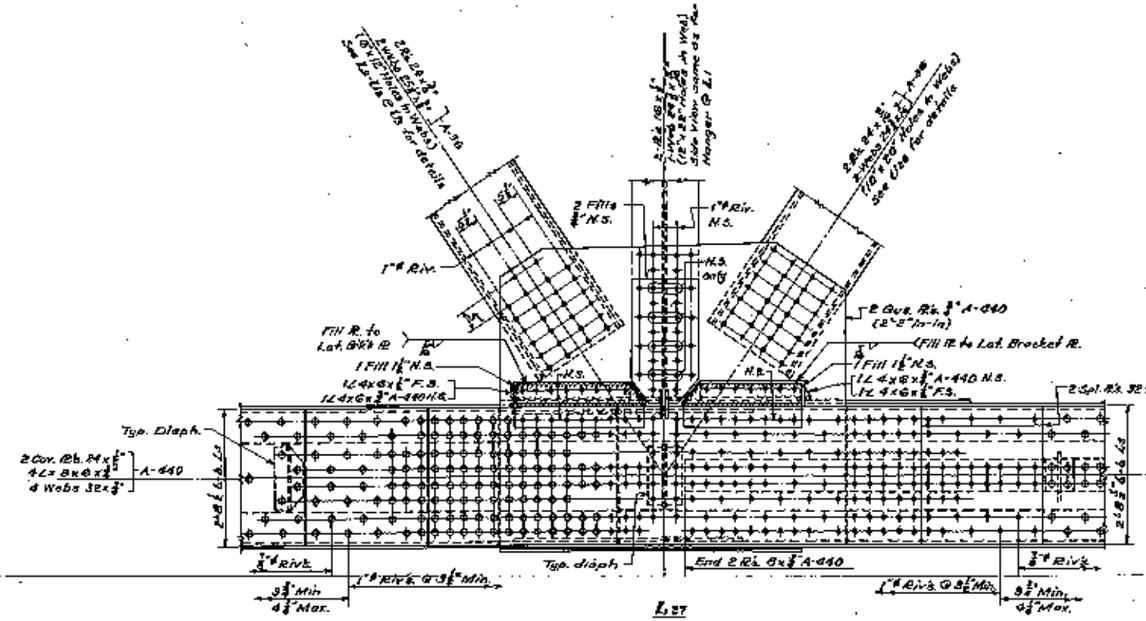

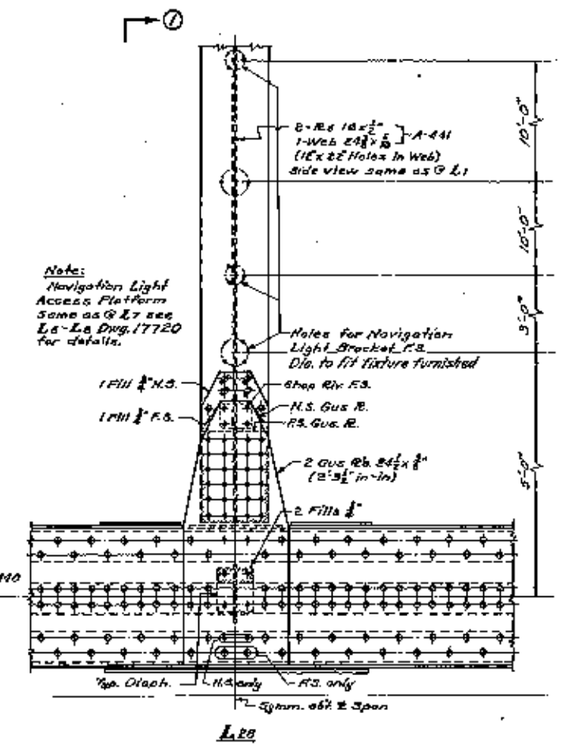

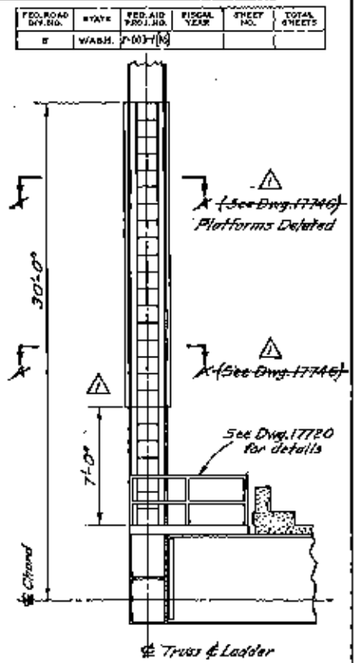

SECTION ⓘ-ⓘ

Showing location of ladder and platforms, required on both East and West trusses. For ladder and ~~platform~~ details see Dwg. 17746. ~~Omit cage at this location.~~ cage

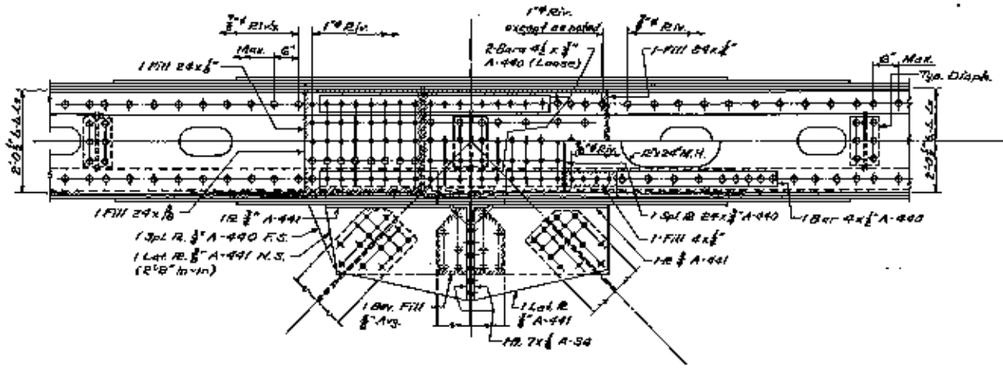

Laterals L26-L28
8-Rs. 14 x ⅝ A-36
1-Web 32 x ⅜
(10"x 28" Holes in Web, See U2)
See L0-L1 for lat. intersection

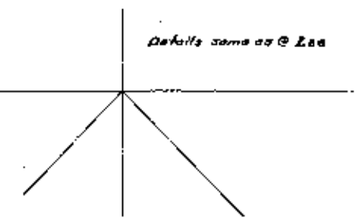

Note:
Rivets ¾" ϕ except as noted.
Hand holes in chords 6"x12" @ 3'-0" c-c., 2'-6" Min.
Tackweld all loose fills.
For typ. diaphs. and weld details see U2-U4 sheet, Dwg. 17731.

FOR INFORMATION ONLY

U. S. HIGHWAY NO. 101
COLUMBIA RIVER BRIDGE
ASTORIA, OREGON - PT. ELLICE, WASHINGTON
SUPERSTRUCTURE CONTRACT

TRUSS DETAILS L27 to L28
MAIN TRUSS

WASHINGTON STATE HIGHWAY COMMISSION
DEPARTMENT OF HIGHWAYS
OLYMPIA, WASHINGTON

SHEET 29 OF 64 SHEETS

17729

1-67 As Constructed
ⓘ Apr. 11, 63 Revised Ladder & Platform Detail

FED. ROAD DIV. NO.	STATE	FED. AID PROJ. NO.	FISCAL YEAR	SHEET NO.	TOTAL SHEETS
8	WASH.	F-0024(16)			

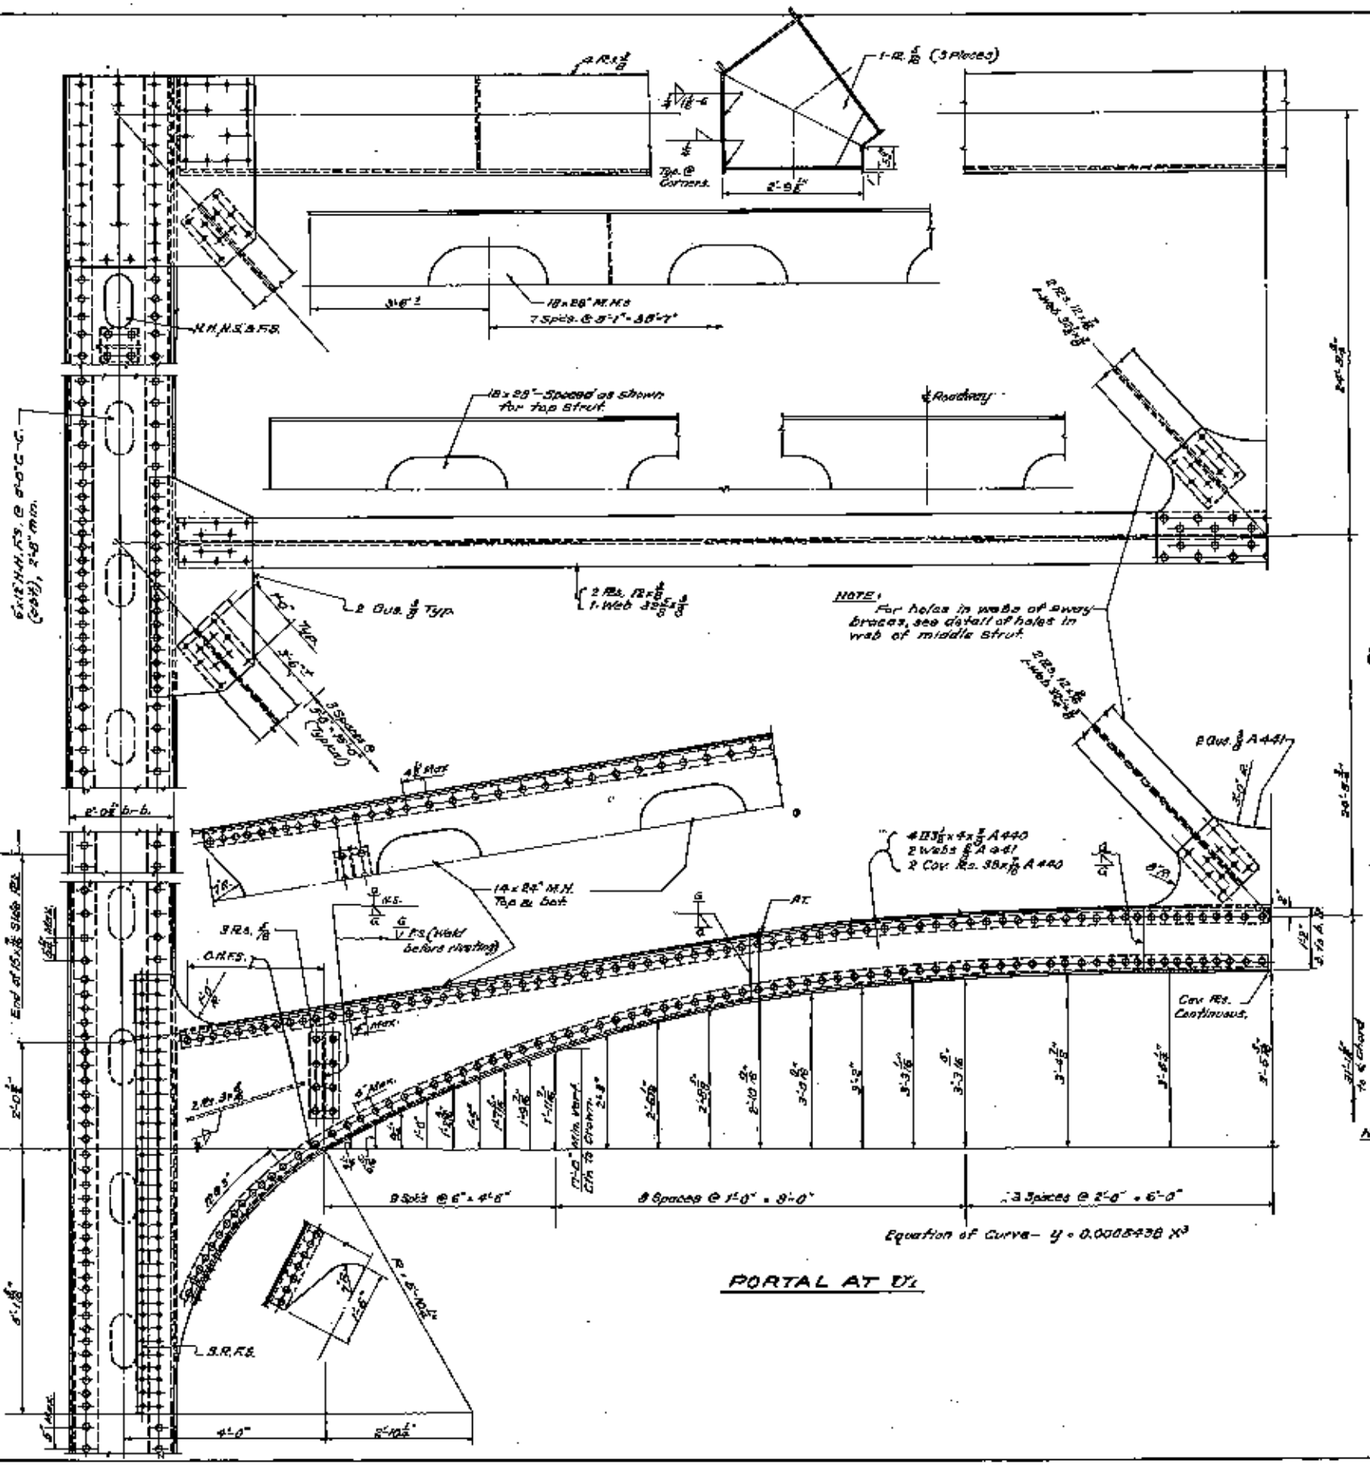

FOR INFORMATION ONLY

U. S. HIGHWAY NO. 101
COLUMBIA RIVER BRIDGE
ASTORIA, OREGON - PT. ELLICE, WASHINGTON
SUPERSTRUCTURE CONTRACT

PORTAL & TRUSS DETAILS AT U1 MAIN TRUSS

WASHINGTON STATE HIGHWAY COMMISSION
DEPARTMENT OF HIGHWAYS
OLYMPIA, WASHINGTON

SHEET 30 OF 64 SHEETS 17730

I-67 As Constructed

FED. ROAD DIV. NO.	STATE	FED. AID PROJ. NO.	FISCAL YEAR	SHEET NO.	TOTAL SHEETS
8	WASH.	F003-1(6)			

U2

U3

U4
Same as U2

U5

U6
Similar to U2 except 2-6⅝" in-in. Lat. Rs., 13/8" Fills under laterals, 2'-5" in./in. gus. and as shown.

LATS U1 to U3
2 Pls. 12 x ⅞
1-Web 32 x ⅞ (13/16" Holes)

2 Cov. Pls. 24 x ⅞
4 L 8 x 6 x ⅞
2 Webs 32 x ½

2 Pls. 16 x ⅝ } A441
1-Web 24 x ⅞
18" x 22" Holes in web
Same as for post at U2

2 Pls. 16 x ⅝ } A441
1-Web 24 x ⅞
12" x 22" Holes in web
Same as for post at U2

2 Cov. Pls. 24 x ⅞
4 L 8 x 6 x ⅞
2 Webs 32 x ½ } A440

2 Pls. 16 x ⅝
1-Web 28 x ⅞ } A441

2 Pls. 12 x ⅝
1-Web 32 x ⅝
10" x 28" Holes in Web, see U2

2 Pls. 12 x ⅝
1-Web 32 x ⅝
10" x 28" Holes in web
See U2

2 Pls. 12 x ⅝
1-Web 32 x ⅝
10" x 28" Holes in web
See U3

CHORDS, L0-U1 & L14-U14

24" & 27" DIAG'S.

WELDED 24" & 27" DIAG'S.
Lat. Strut @ L22½ & U22½ Similar.

TYPICAL DIAPHRAGMS.
Use one diaphragm at each end of all diagonals and as shown.

WELD DETAILS OF HANGERS, POSTS & LATERALS

WELD DETAIL OF LATERAL PLATES

HANDHOLE ALIGNMENT DETAIL
Handholes in diagonals shall be aligned vertically as shown (Typ.)

NOTES:
Rivets ⅞" except 1" for Diagonal connections at U3 & U5.
Hand holes in chords 6'-12" @ 8'-0" c/c, 2'-8" min.
Tack weld all loose fills.

FOR INFORMATION ONLY

U.S. HIGHWAY NO. 101
COLUMBIA RIVER BRIDGE
ASTORIA, OREGON - PT. ELLICE, WASHINGTON
SUPERSTRUCTURE CONTRACT

TRUSS DETAILS U2 to U6
MAIN TRUSS

WASHINGTON STATE HIGHWAY COMMISSION
DEPARTMENT OF HIGHWAYS
OLYMPIA, WASHINGTON

1-67 As Constructed

SHEET 51 OF 64 SHEETS

17731

FED. ROAD DIV. NO.	STATE	FED. AID PROJ. NO.	FISCAL YEAR	SHEET NO.	TOTAL SHEETS
8	WASH.	F003H(16)			

U7

U8

U9

LATERAL INTERSECTION U9 - U11

Notes:
Rivets in Truss Members 7/8 D.N.
Rivets in laterals & bracing 3/4 ø.
Handholes in chords 6"x12"@3'-0" c/c min.
For Typ. Diaphs. & welding details of welded members see U2-U6 Sheet, Dwg. 17731.
Tackweld all loose fills.

FOR INFORMATION ONLY

1-67 As Constructed

U.S. HIGHWAY NO. 101
COLUMBIA RIVER BRIDGE
ASTORIA, OREGON - PT. ELLICE, WASHINGTON
SUPERSTRUCTURE CONTRACT

TRUSS DETAILS U7 to U9
MAIN TRUSS

WASHINGTON STATE HIGHWAY COMMISSION
DEPARTMENT OF HIGHWAYS
OLYMPIA, WASHINGTON

SHEET 32 OF 84 SHEETS

17732

PROJECT DESIGNATION	STATE	FED. AID PROJECT NO.	FISCAL YEAR	SHEET NO.	TOTAL SHEETS
B	WASH.	F003(1)8			

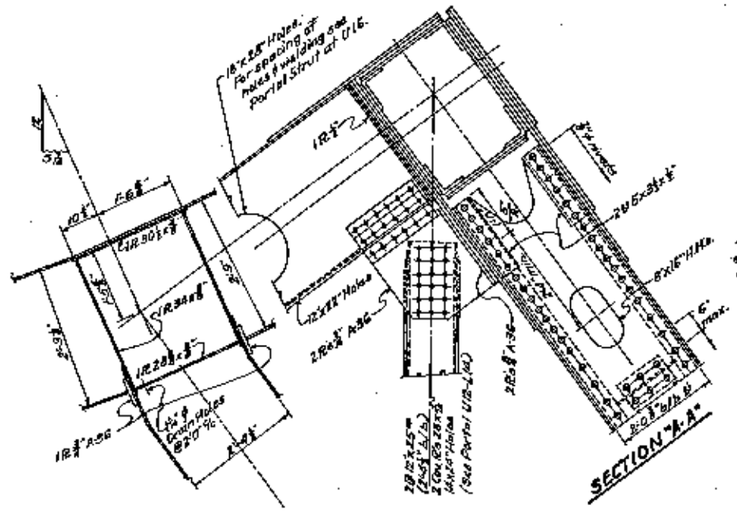

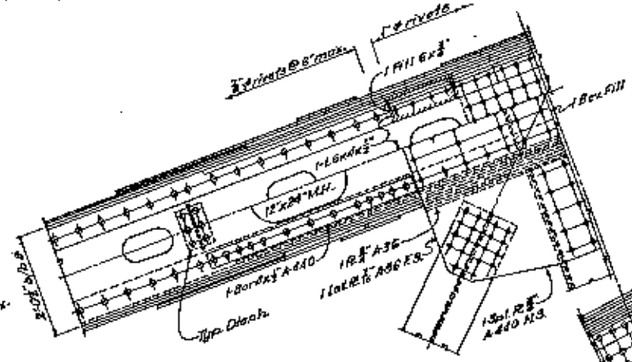

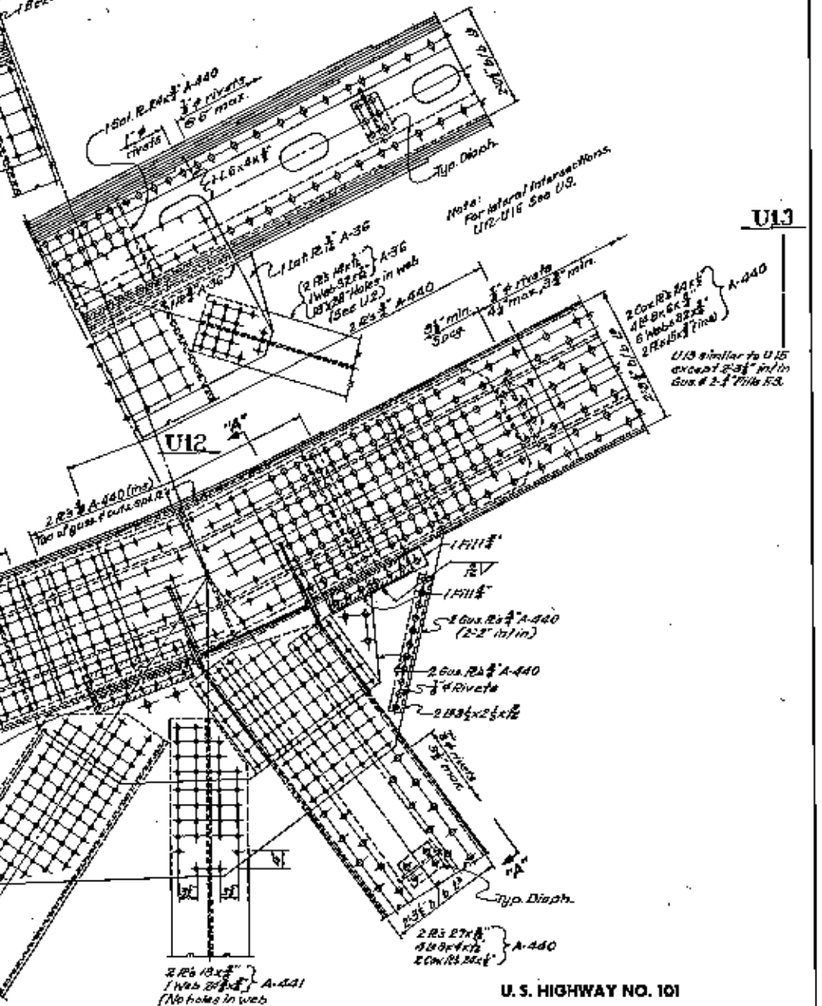

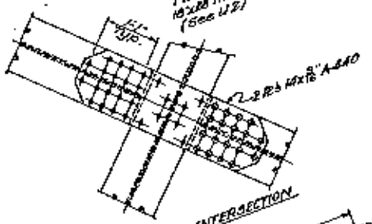

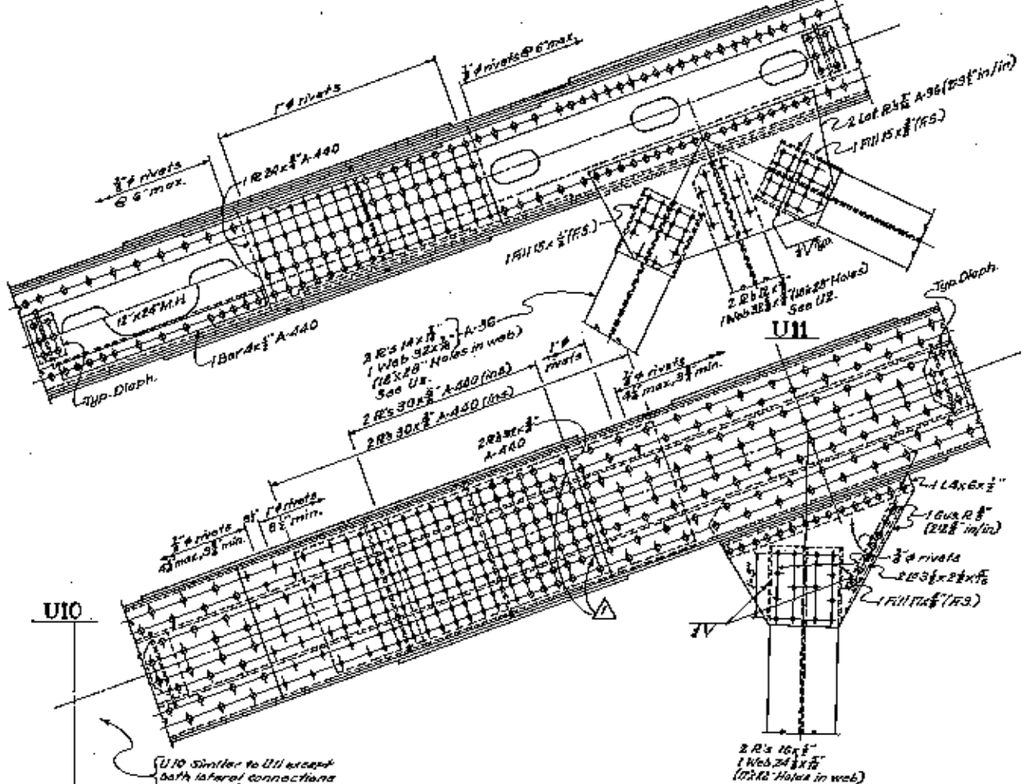

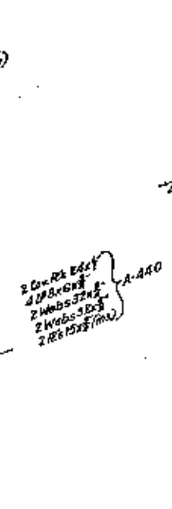

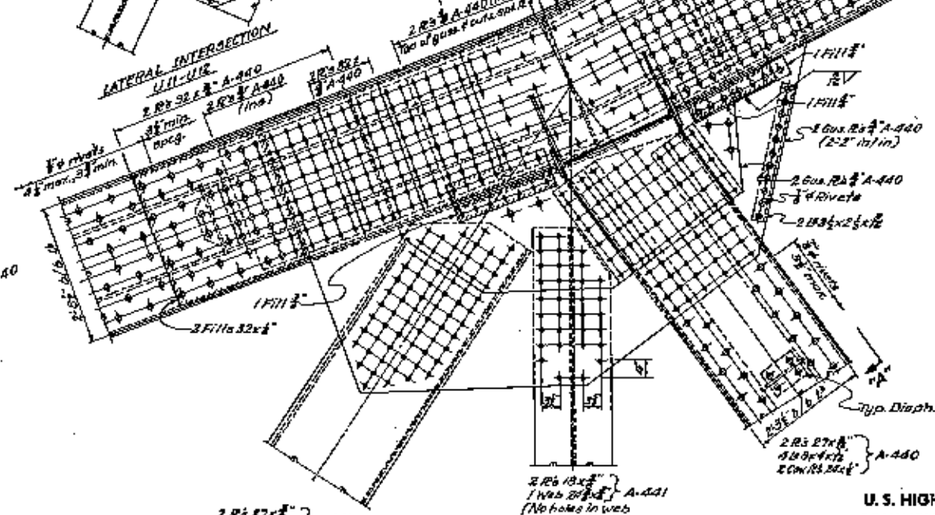

FOR INFORMATION ONLY

Note.
Rivets in truss members 1" ø U.N.O.
Rivets in laterals & bracing ¾" ø.
Hand Holes in Cov Pls of Truss Chords & Diagonals 6"x12" @ 9'-10" c/c, 2'-8" min. except U12-M13.
For Typ. Diaphs. & welding details of welded members see U2-U6 Shts. Dwg. 17731
Tack weld all loose Fills.

⚠ May 8, 1964 Removed 2 Rivets
1-67 As Constructed

U. S. HIGHWAY NO. 101
COLUMBIA RIVER BRIDGE
ASTORIA, OREGON - PT. ELLICE, WASHINGTON
SUPERSTRUCTURE CONTRACT

TRUSS DETAILS U10 to U13 MAIN TRUSS

WASHINGTON STATE HIGHWAY COMMISSION
DEPARTMENT OF HIGHWAYS
OLYMPIA, WASHINGTON

SHEET 38 OF 84 SHEETS 17733

FED. ROAD DIV. NO.	STATE	FED. AID PROJ. NO.	FISCAL YEAR	SHEET NO.	TOTAL SHEETS
8	WASH.	F-003-1(16)			

BEACON LIGHT BRACKET DETAIL

2 Req'd.
1 ea. @ U14 & U'14

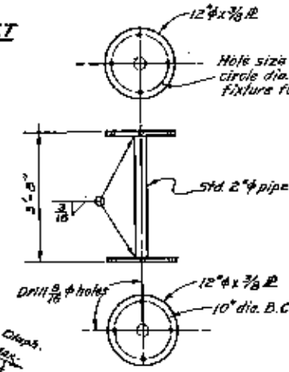

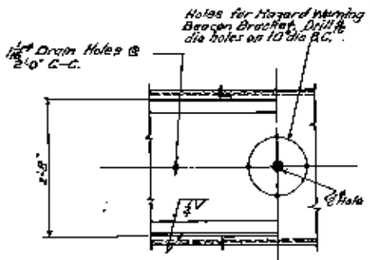

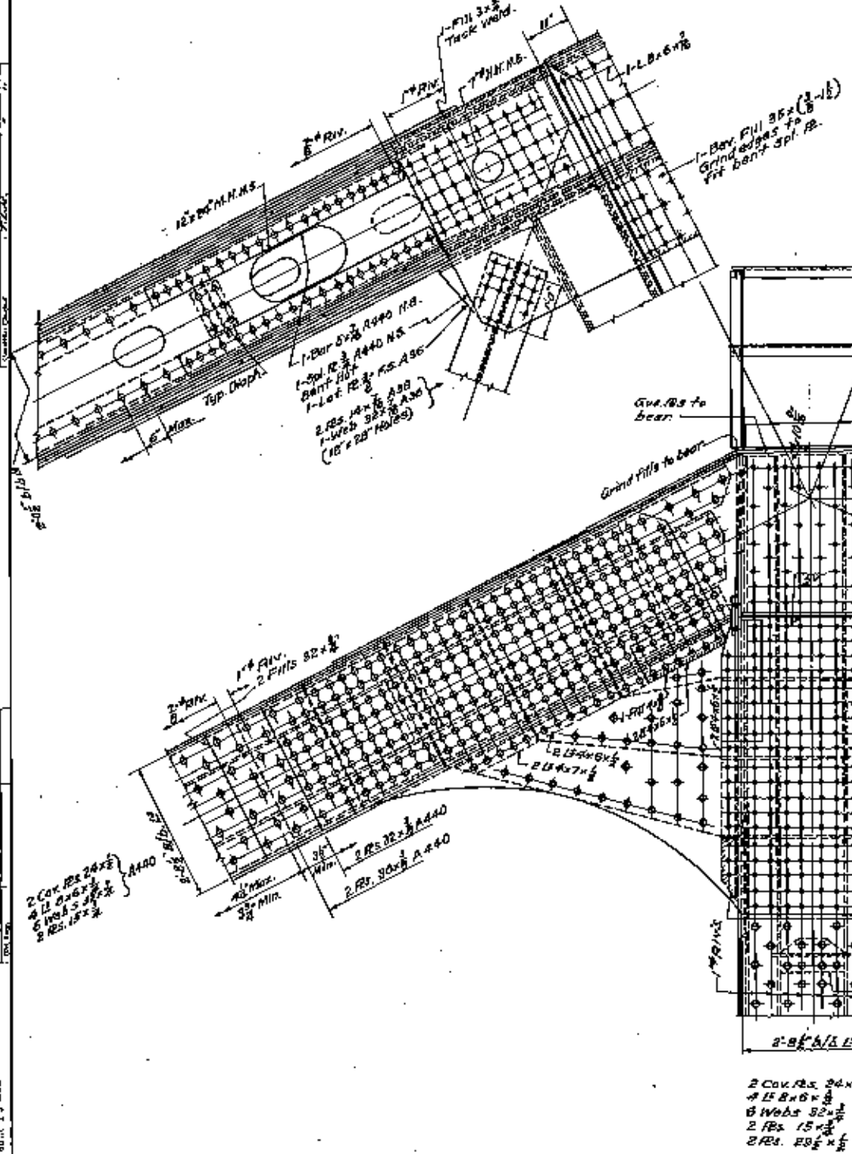

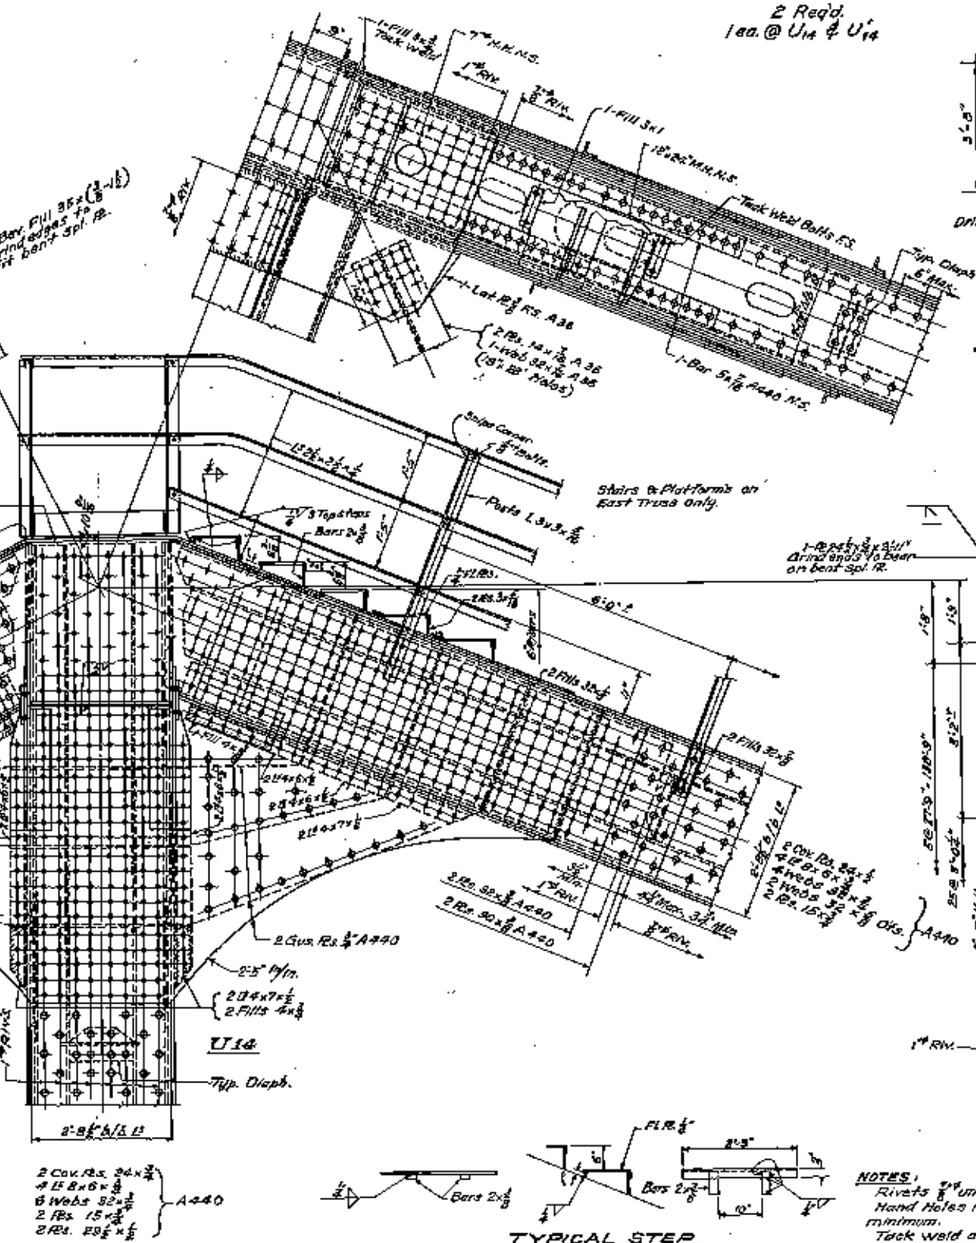

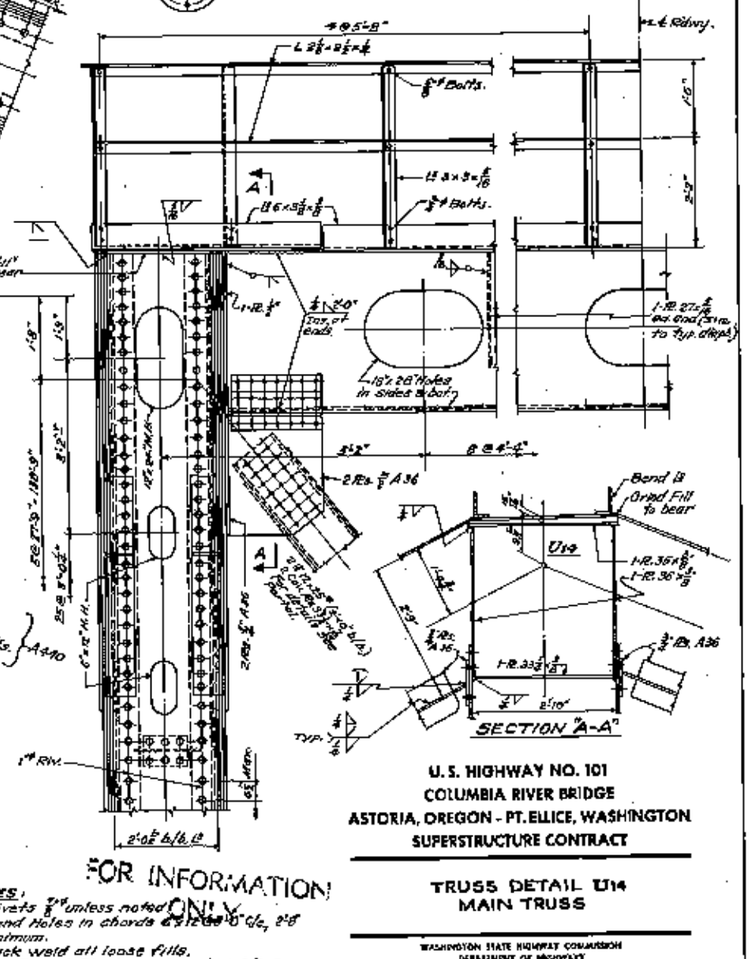

NOTES:
Rivets 7/8" ϕ unless noted otherwise.
Hand Holes in chords & webs 8"x12", 2'-6" minimum.
Tack weld all loose fills.
For Typical Diaphragms and welding details see U2-U6, Dwg. 17731.
All Fl. Pls to be raised pattern.

FOR INFORMATION ONLY

1-67 As Constructed

U.S. HIGHWAY NO. 101
COLUMBIA RIVER BRIDGE
ASTORIA, OREGON - PT. ELLICE, WASHINGTON
SUPERSTRUCTURE CONTRACT

TRUSS DETAIL U14
MAIN TRUSS

WASHINGTON STATE HIGHWAY COMMISSION
DEPARTMENT OF HIGHWAYS
OLYMPIA, WASHINGTON

SHEET 34 OF 64 SHEETS

17734

FED. ROAD DIV. NO.	STATE	FED. AID PROJ. NO.	FISCAL YEAR	SHEET NO.	TOTAL SHEETS
10	WASH.	F-0031(6)			

Rivets in truss members 1" unless noted.
Rivets in laterals and bracing 7/8"ø
Hand holes in cov. Pls. of truss chords and diagonals 6"x12" @ 3'-0" C-C, 2'-8" min.
For typical diaphs and welding details of welded members see U2-U8 sheet, Dwg. 17731.
For holes in webs of laterals see U8.

FOR INFORMATION ONLY

U. S. HIGHWAY NO. 101
COLUMBIA RIVER BRIDGE
ASTORIA, OREGON - PT. ELLICE, WASHINGTON
SUPERSTRUCTURE CONTRACT

TRUSS DETAILS U15 to U16
MAIN TRUSS

WASHINGTON STATE HIGHWAY COMMISSION
DEPARTMENT OF HIGHWAYS
OLYMPIA, WASHINGTON

I-67 As Constructed

SHEET 38 OF 84 SHEETS 17735

FED. ROAD DIV. NO.	STATE	FED. AID PROJ. NO.	FISCAL YEAR	SHEET NO.	TOTAL SHEETS
8	WASH.	F-003-1(6)			

U17

U18

U19

LATERAL INTERSECTION U17 - U18

LATERAL INTERSECTION U16 - U17

Notes:
Rivets in truss members 1"ø U.N.
Rivets in laterals & bracing ⅞"ø
Hand Holes in Cov. Pls. of Chord members 6"x 12" @ 3'-0" ctrs., 2'-8" Min.
For Typ. Diaphs. & Welding details of welded members see U16-U18 sheet, Dwg. 17731.
Tack weld all loose fills.

FOR INFORMATION ONLY

1-67 As Constructed

U. S. HIGHWAY NO. 101
COLUMBIA RIVER BRIDGE
ASTORIA, OREGON - PT. ELLICE, WASHINGTON
SUPERSTRUCTURE CONTRACT

TRUSS DETAILS U17 to U19
MAIN TRUSS

WASHINGTON STATE HIGHWAY COMMISSION
DEPARTMENT OF HIGHWAYS
OLYMPIA, WASHINGTON

SHEET 36 OF 84 SHEETS

17736

FED. ROAD DIV. NO.	STATE	FED. AID PROJ. NO.	FISCAL YEAR	SHEET NO.	TOTAL SHEETS
5	WASH.	F-061-1(8)			

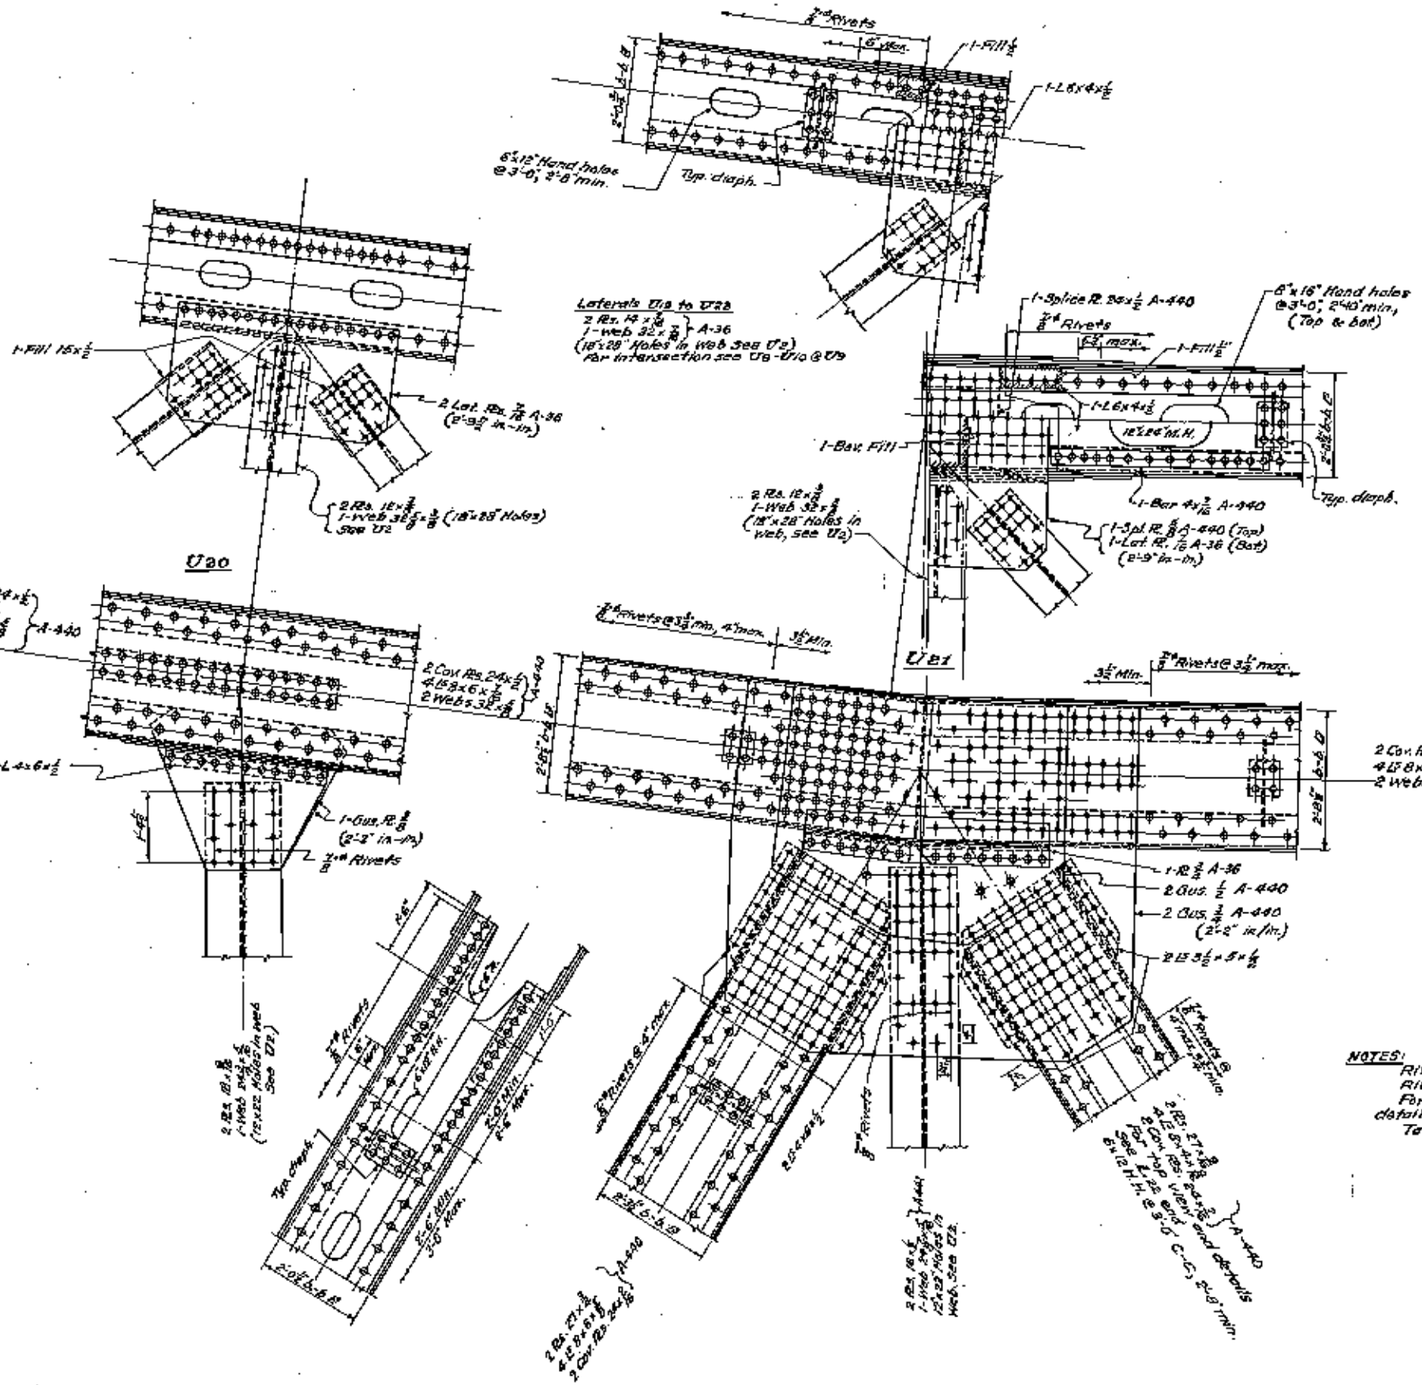

NOTES:
Rivets in truss members @ U21 1st U.N.
Rivets in laterals and struts 7/8 ø
For typical diaphrams and welding details of welded members see U2-U6 sheet Dwg. 17731
Tack weld all loose fills.

FOR INFORMATION ONLY

I-67 As Constructed

U.S. HIGHWAY NO. 101
COLUMBIA RIVER BRIDGE
ASTORIA, OREGON - PT. ELLICE, WASHINGTON
SUPERSTRUCTURE CONTRACT

TRUSS DETAILS U20 to U22
MAIN TRUSS

WASHINGTON STATE HIGHWAY COMMISSION
DEPARTMENT OF HIGHWAYS
OLYMPIA, WASHINGTON

SHEET 32 OF 84 SHEETS

17737

FED. ROAD DIV. NO.	STATE	FED. AID PROJ. NO.	FISCAL YEAR	SHEET NO.	TOTAL SHEETS
8	WASH.	F-003-1(14)			

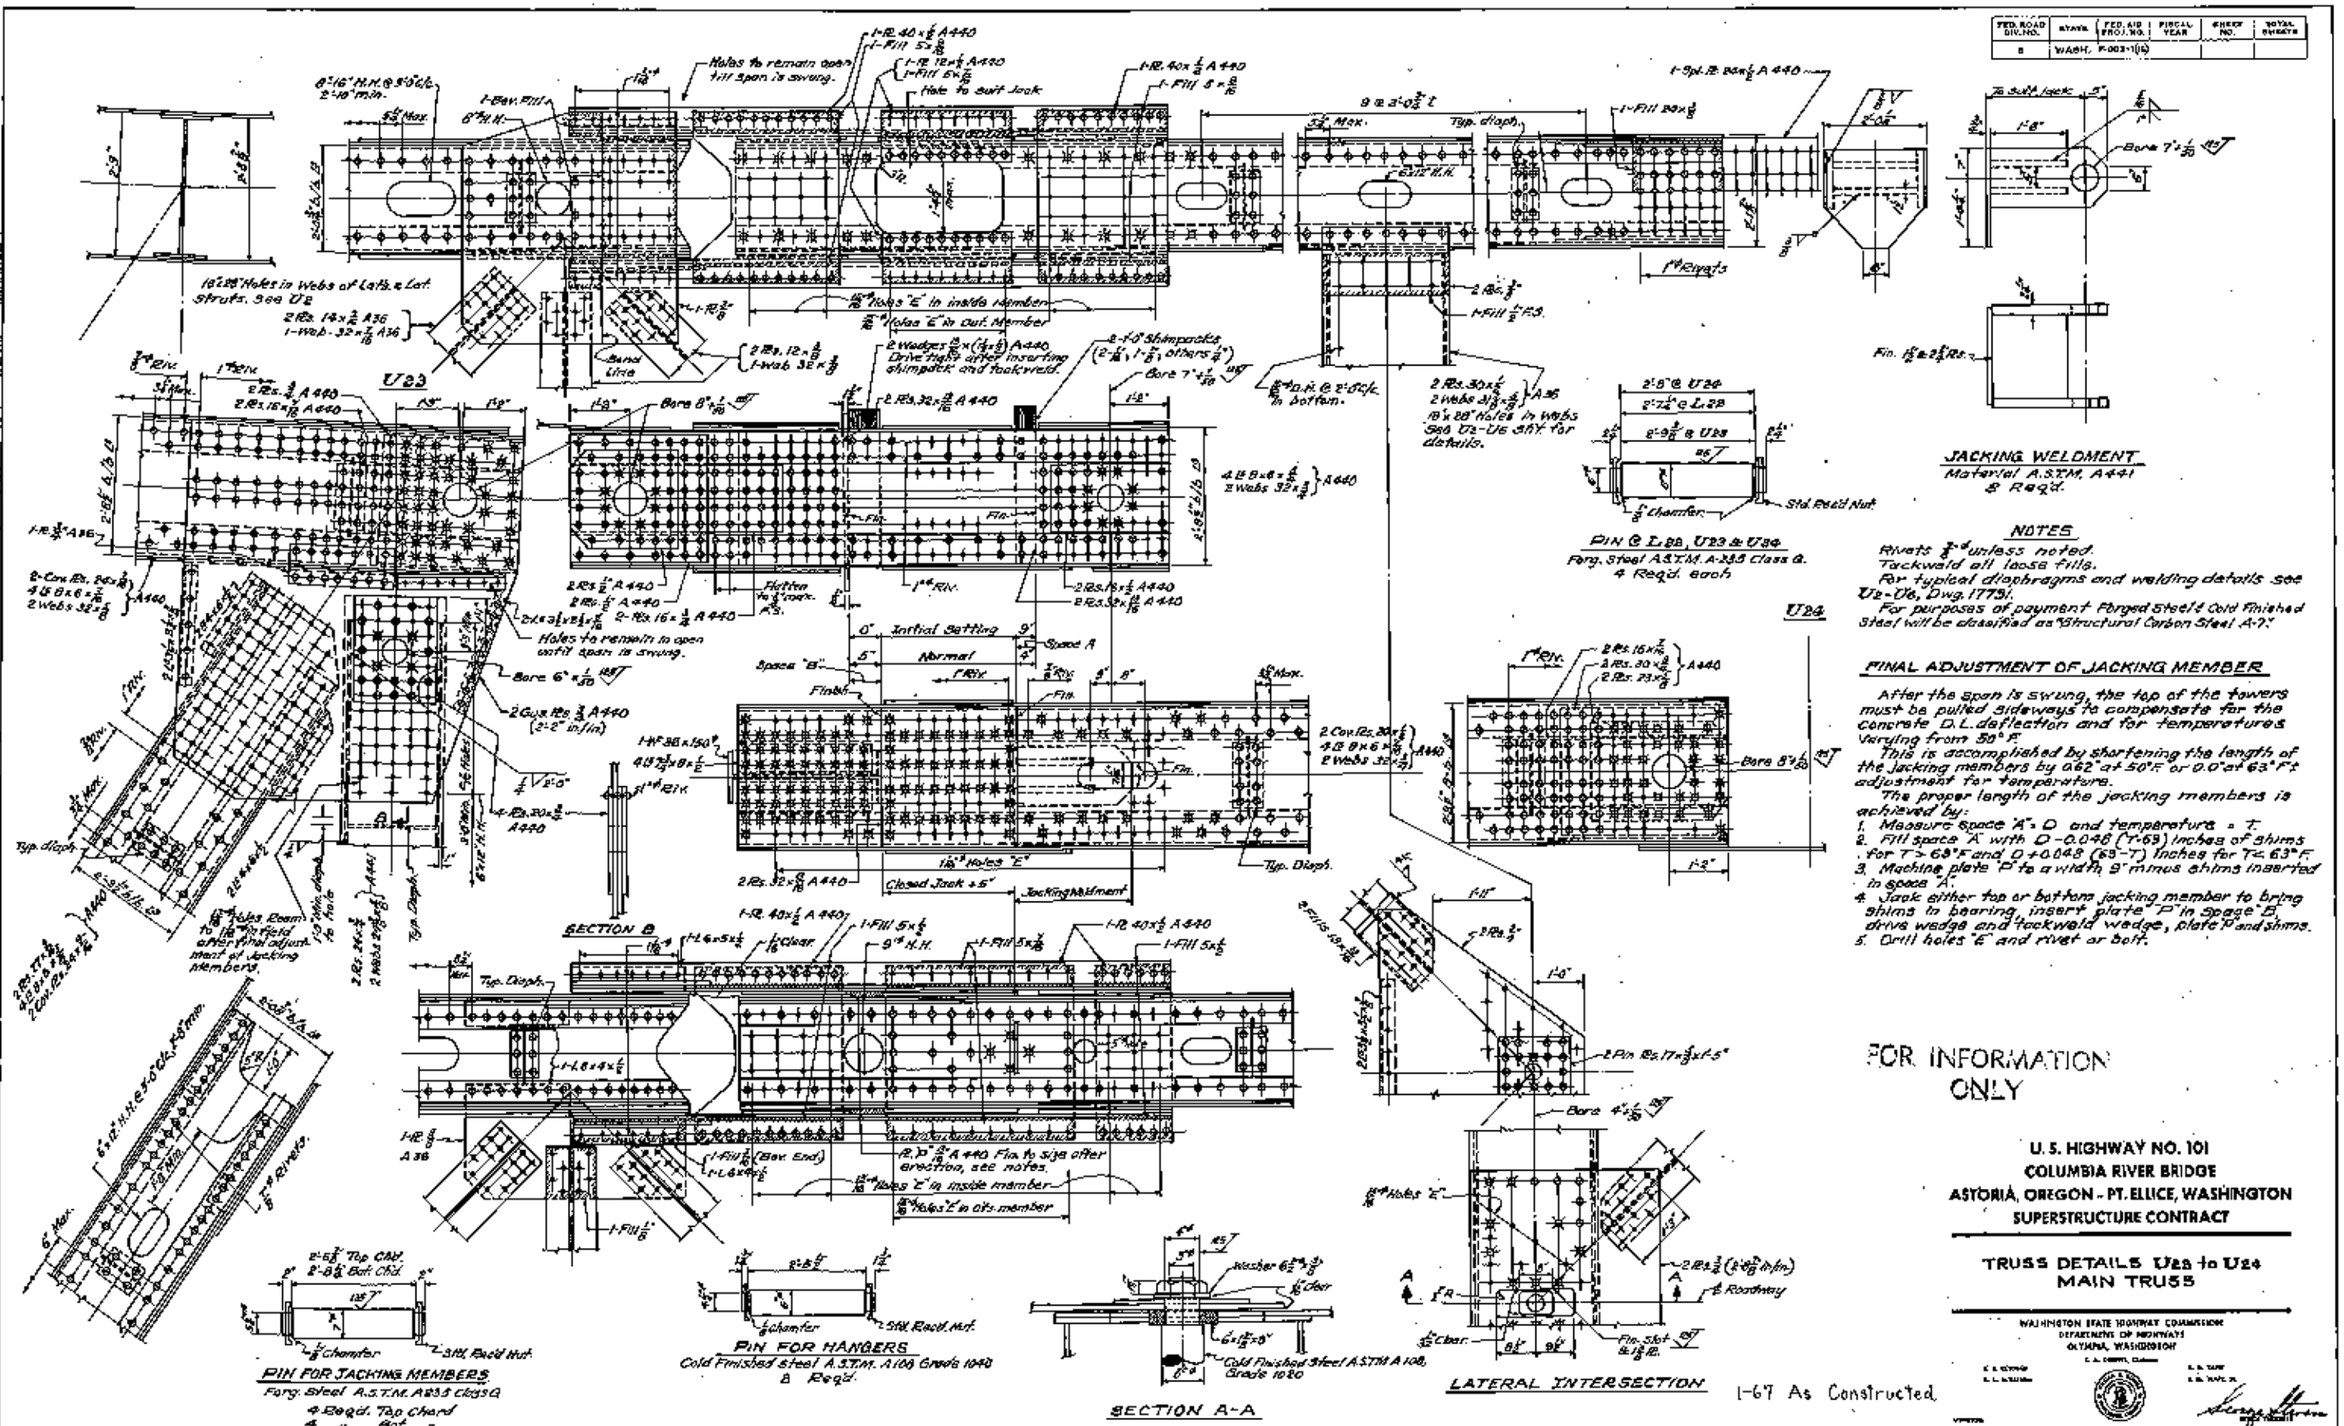

JACKING WELDMENT

Material A.S.T.M. A441
8 Reqd.

NOTES

Rivets 7/8" ø unless noted.
Tackweld all loose fills.
For typical diaphragms and welding details see U2-U6, Dwg. 1779.
For purposes of payment Forged Steel's Cold Finished Steel will be classified as "Structural Carbon Steel A-7".

PIN @ L 28, U23 & U24

Forg. Steel A.S.T.M. A-235 Class G.
4 Reqd. each

PIN FOR JACKING MEMBERS

Forg. Steel A.S.T.M. A235 class G
4 Reqd. Top Chord
4 " Bot. "

PIN FOR HANGERS

Cold Finished Steel A.S.T.M. A108 Grade 1040
8 Reqd.

FINAL ADJUSTMENT OF JACKING MEMBER

After the span is swung, the top of the towers must be pulled sideways to compensate for the concrete D.L. deflection and for temperatures varying from 50° F.

This is accomplished by shortening the length of the Jacking members by 0.62" at 50°F or 0.0" at 63° F. adjustment for temperature.

The proper length of the jacking members is achieved by:

1. Measure space "A" = D and temperature = T.
2. Fill space "A" with D-0.048 (T-63) inches of shims for T > 63°F and D+0.048 (63-T) inches for T< 63°F.
3. Machine plate "P" to a width 9" minus shims inserted in space "A".
4. Jack either top or bottom jacking member to bring shims to bearing, insert plate "P" in space "B", drive wedge and tackweld wedge, plate "P" and shims.
5. Drill holes "E" and rivet or bolt.

FOR INFORMATION ONLY

U. S. HIGHWAY NO. 101
COLUMBIA RIVER BRIDGE
ASTORIA, OREGON - PT. ELLICE, WASHINGTON
SUPERSTRUCTURE CONTRACT

TRUSS DETAILS U23 to U24 MAIN TRUSS

WASHINGTON STATE HIGHWAY COMMISSION
DEPARTMENT OF HIGHWAYS
OLYMPIA, WASHINGTON

I-67 As Constructed

SHEET 38 OF 64 SHEETS

17738

FED. ROAD DIV. NO.	STATE	FED. AID PROJ. NO.	FISCAL YEAR	SHEET NO.	TOTAL SHEETS
8	WASH.	F-003-1(15)			

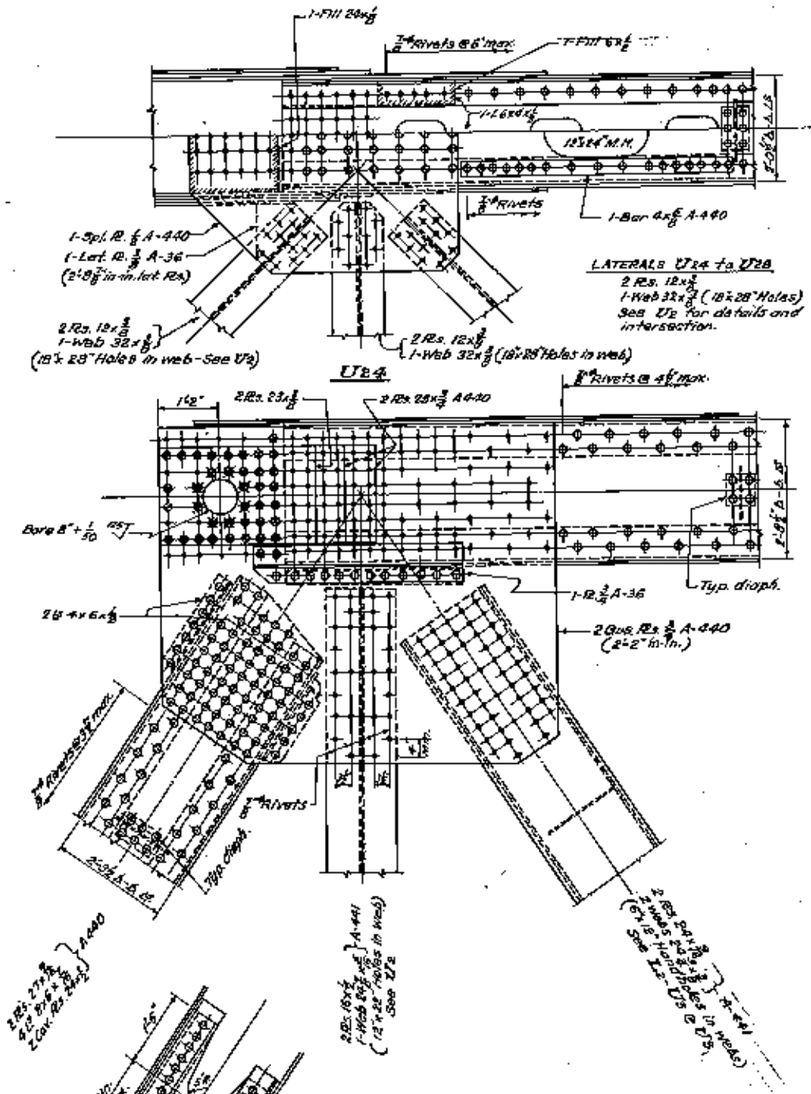
U24
U26
U26
1-Fill 24"x 5/8"
7/8" Rivets @ 6" max.
1-Fill 42" x 1/2"
1-L 6"x 4"x 5/8"
15"x 24" M.H.
7/8" Rivets
1-Bar 4"x 5/8" A-440
1-Spl. Pl. 5/8" A-440
1-Lat. Pl. 3/8" A-36
(2'-8 3/8" in-in lat. Pls.)
2 Pls. 12"x 3/8"
1-Web 32"x 3/8"
(15/16" Holes in web-See U2)
2 Pls. 12"x 3/8"
1-Web 32"x 3/8" (15/16" Holes in web)
LATERALS U24 to U28
2 Pls. 12"x 3/8"
1-Web 32"x 3/8" (15/16" Holes)
See U2 for details and intersection.
1-Fill 14"x 3/8" F.S.
1-Fill 18"x 3/8" F.S.
2 Lat. Pls. 3/8"
(2'-10" in-in)
1-Fill 14"x 3/8" F.S.
1-Fill 18"x 3/8" F.S.
3/8" V
2 Pls. 18"x 3/8"
1-Web 35 3/8"x 3/8" (15/16" Holes in web)
See U2.
7/8" Rivets
6"
Max.
1-L 4"x 6"x 5/8"
1-Spl. Pl. 24"x 5/8" A-440
12"x 24" M.H.
1-Bar 4"x 5/8" A-440
Typ. diaph.
1-Lat. Pl. 3/8" A-36
(2'-8 3/8" in-in.)
1-Spl. Pl. 5/8" A-440
2 Pls. 12"x 3/8"
1-Web 32"x 3/8"
(15/16" Holes in web
See U2)
open holes of
member erected
last.
7/8" Rivets,
@ 4 1/2" max.
7/8" Rivets @ 4 1/2" max.
2 Fills 7 1/2"
Mill
2 Spl. Pls. 3/8" A-440
2 Gus. Pls. 5/8" A-440
(2'-2" in-in.)
Typ. diaph.
2 Fills 4"x 1/4"
1-Pl. 3/8" A-36
2 L 3 1/2"x 3 1/2"x 1/2"
1-Gus. Pl. 3/8"
(2'-8" in-in)
7/8" Rivets @ 4" max.
2 Cov. Pls. 24"x 3/8"
4 L's 8"x 6"x 3/8"
2 Webs 32"x 3/8"
A-440
2 Cov. Pls. 24"x 3/8"
4 L's 8"x 6"x 3/8"
2 Webs 32"x 3/8"
2 Rep. Pls. 7"x 1/2" (15/16" Holes)
A-440
2 Rs. 23"x 1/2"
2 Rs. 28"x 3/4" A-440
16'-0"
Bore 8" + 1/50 RST
1-Pl. 3/4" A-36
2 Gus. Pls. 3/8" A-440
(2'-2" in-in.)
2 Pls. 4"x 6"x 1/2"
7/8" Rivets @ 5" max.
7/8" Rivets
Typ. diaph.
2 Pls. 27 3/8"x 1/2"
4 L's 8"x 6"x 1/2"
2 Cov. Pls. 24"x 1/2"
A-440
2 Pls. 16"x 1/2"
1-Web 84"x 1/2" (13/16" Holes in web)
See U2
2 Pls. 20"x 1/2"
2 Webs 84"x 1/2" (13/16" Holes in web)
See U2

FED. ROAD DIV. NO.	STATE	FED. AID PROJ. NO.	FISCAL YEAR	SHEET NO.	TOTAL SHEETS
8	WASH.	F-003-1(6)			

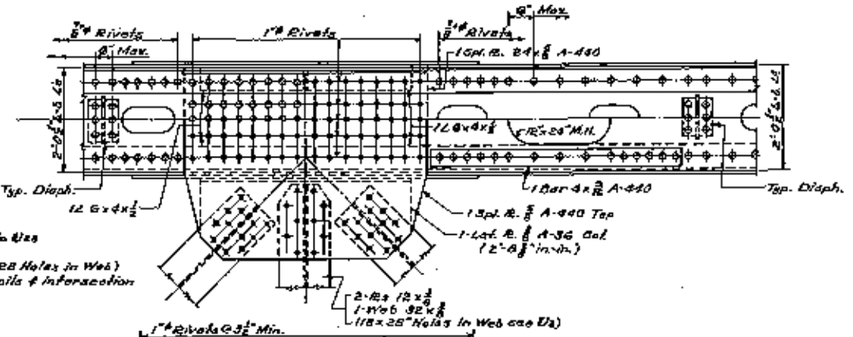

Notes:
Rivets 7/8" ϕ U.H.
Hand Holes in chord members 6"x12"@ 9'0" ctrs., 2'-8" min.
For Typ. diaphrs. & details of welded members see U2-U8 sheet, Dwg. 17731.

FOR INFORMATION ONLY

I-67 As Constructed

U. S. HIGHWAY NO. 101
COLUMBIA RIVER BRIDGE
ASTORIA, OREGON - PT. ELLICE, WASHINGTON
SUPERSTRUCTURE CONTRACT

TRUSS DETAILS U27 to U28
MAIN TRUSS

WASHINGTON STATE HIGHWAY COMMISSION
DEPARTMENT OF HIGHWAYS
OLYMPIA, WASHINGTON

SHEET 40 OF 64 SHEETS 17740

FED. ROAD DIV. NO.	STATE	FED. AID PROJ. NO.	FISCAL YEAR	SHEET NO.	TOTAL SHEETS
8	WASH.	F-003-1(14)			

SECTION A-A

Typical for all struts & diagonals

Struts & Diagonals except in lower panel.
2 (12"x25#) (2-4½"x⅝) (⅞" Rivs. in flanges)
2 Cov. PLs 28x⅞ (14"x24" holes)

Connections typical except for Fills.

Before assembly

Open holes F.S.

Shop Rivets F.S.

Equation of curve $y = 0.0005640x^2$

PORTAL @ U12-U14

Rivets ⅞" ø U.N.
For typical diaphs & welding details see U12-U13 sheet, Dwg. 17731.

FOR INFORMATION ONLY

1-67 As Constructed

U. S. HIGHWAY NO. 101
COLUMBIA RIVER BRIDGE
ASTORIA, OREGON - PT. ELLICE, WASHINGTON
SUPERSTRUCTURE CONTRACT

PORTAL AT U12-U14
MAIN TRUSS

WASHINGTON STATE HIGHWAY COMMISSION
DEPARTMENT OF HIGHWAYS
OLYMPIA, WASHINGTON

SHEET 41 OF 84 SHEETS 17741

Fed. Roads Div. No.	State	Fed. Aid Proj. No.	Fiscal Year	Sheet No.	Total Sheets
8	WASH. F-003-1(16)				


Typ. diagph. at splice only.

Typ. for all struts and diagonals.

Strut near M 14
Others Similar

Struts & Diagonals
2 LL 12 x 8 5/8 x 2 1/2 x 10 1/2 (3/4" Riv. in flgs.)
2 Cov Pls., 33 1/2 x 7/16 (14" x 26" holes)

SECTION A-A

PORTAL AT 14

LOWER DIAGONAL CONNECTION AT VERTICAL

Equation of Curve
$Y = .0004535 X^3$

Rivets 7/8" U.N.
For typical diaphs see U2-U6

FOR INFORMATION ONLY

1-67 As Constructed

U. S. HIGHWAY NO. 101
COLUMBIA RIVER BRIDGE
ASTORIA, OREGON - PT. ELLICE, WASHINGTON
SUPERSTRUCTURE CONTRACT

PORTAL AT U14-L14
MAIN TRUSS

WASHINGTON STATE HIGHWAY COMMISSION
DEPARTMENT OF HIGHWAYS
OLYMPIA, WASHINGTON

SHEET 42 OF 64 SHEETS 17742

FED. ROAD DIV. NO.	STATE	FED. AID PROJ. NO.	FISCAL YEARS	SHEET NO.	TOTAL SHEETS
8	WASH.	F-002-1(6)			

M 16

SECTION A-A

Typ. for all struts & diagonals except 12"x22" holes in lowest diagonal.

Struts & Diagonals except Lower Diagonal
2 PL 12x80# (2 @ 5/8") (7/8" ϕ Rivets in Flanges)
2 Cov. Pls 25x 1/2 (1 1/4" x 24" Holes)
Connections shown typical except for Fills.

Equation of curve
$y = 0.0005483\,x^3$

PORTAL @ L14-U16
Rivets 1" ϕ U.N.
For typical diaphr. & welding details see U12-U8.

FOR INFORMATION ONLY

I-67 As Constructed

U. S. HIGHWAY NO. 101
COLUMBIA RIVER BRIDGE
ASTORIA, OREGON - PT. ELLICE, WASHINGTON
SUPERSTRUCTURE CONTRACT

PORTAL AT L14-U16
MAIN TRUSS

WASHINGTON STATE HIGHWAY COMMISSION
DEPARTMENT OF HIGHWAYS
OLYMPIA, WASHINGTON

SHEET 19 OF 64 SHEETS

17743