


PILOT HOLE ALIGNMENT
SCALE: 1:960

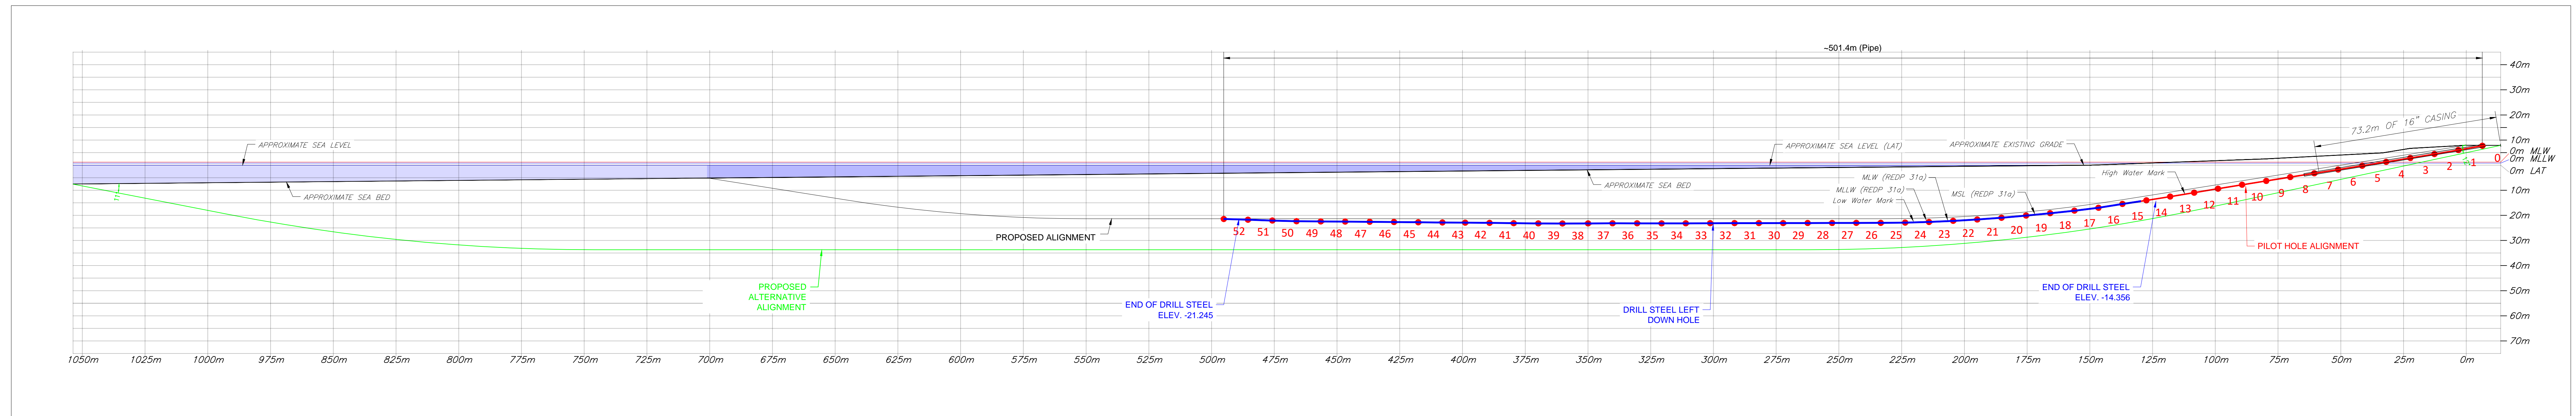

PILOT HOLE PROFILE
HOR. SCALE: 1:960
VER. SCALE: 1:960

Plan View & HDD Profile (As-Built Pilot Hole & Provisional Profile)	
HDD JUPITER PACIFIC CITY, OREGON	
Subcontractor Mantech International Ltd	Contractor SUBCOM LLC
Pacific City Oregon HDD Pilot Hole_RevA.dwg	20 Jun 2023
Pacific City Oregon HDD Pilot Hole_RevA.dwg	20 Jun 2023
Rev. Drawing	Revision Date Prepared by Checked by Approved by Issues for